

DEPARTMENT OF INSPECTIONS, LICENSES & PERMITS 3430 COURT HOUSE DRIVE ELLICOTT CITY, MD 21043 PERMITS (410) 313-2455 INSPECTIONS (410) 313-1850	HOWARD COUNTY RESIDENTIAL HEATING-VENTILATION-AIR CONDITIONING AND REFRIGERATION PERMIT APPLICATION	HVACR PERMIT # <u>M11001125</u> BUILDING PERMIT #
---	---	--

BUILDING ADDRESS: <u>3338 Brantly Road</u> SUITE/APT: SUBDIVISION: CENSUS TRACT: SECTION: AREA: LOT: TAX MAP: PARCEL: BLOCK: ZONE: PROPERTY ID: MAP COORDINATES: TYPE OF IMPROVEMENTS: USE:	OWNERS NAME: <u>David Smith & Diane Deering</u> ADDRESS: <u>3338 Brantly Rd.</u> CITY: <u>Glenwood</u> STATE: <u>MD</u> ZIP CODE: <u>21738</u> HOME PHONE: WORK PHONE:
---	--

<u>CHECK ONE</u>	<u>HOW MANY</u>	COMPANY NAME:
SINGLE FAMILY DWELLING <input type="checkbox"/>	<u>1</u> ZONES	<u>Total Comfort Heating & AC</u>
SINGLE FAMILY TOWNHOUSE <input type="checkbox"/>	___ ZONES	LICENSEE NAME: <u>James E. Aaron</u>
MULTI-FAMILY / HOTEL/MOTEL <input type="checkbox"/>	___ ROOMS	ADDRESS: <u>P.O. Box 643</u>
ASSISTED LIVING HOMES (16 OR FEWER RESIDENTS) <input type="checkbox"/>	___ ROOMS	CITY: <u>Smithsburg</u> STATE: <u>MD</u> ZIP CODE: <u>21783</u> PHONE: <u>302-824-3200</u> HVACR LICENSE NO: <u>5833-01</u>

New

Heating and Air Conditioning Heating System Only Other Work (Describe):

Geo Thermal System Ductless Mini Splits Thru The Wall Systems

Replacement

Heating Heating and Air Conditioning

Heating and Air Conditioning

12/7/2011 approved (BB)

Install geothermal unit.

Additions and Alterations

Heating Air Conditioning Heating and Air Conditioning

****Replacement Geo Thermal Systems are not required; However, if a tax credit is being sought a permit is required****

Zones Permit Fee = # of Zones x \$40 = <u>40.00</u> Technology Fee (10% of Permit Fee) = <u>4.00</u> Plus Application Fee <u>\$50.00</u> Total Fees Due = <u>94.00</u>	Rooms Permit Fee = # of Rooms x \$80 = _____ Technology Fee (10% of Permit Fee) = _____ Plus Application Fee \$50 <u>\$50.00</u> Total Fees Due = _____
---	--

I HAVE CAREFULLY EXAMINED AND READ THIS APPLICATION AND KNOW IT IS TRUE AND CORRECT. THE WORK DESCRIBED HEREIN WILL BE PERFORMED BY A STATE HVACR LICENSED PERSON(S), AND ALL WORK WILL BE PERFORMED IN COMPLIANCE WITH APPLICABLE CODES AND STANDARDS OF HOWARD COUNTY THE STATE OF MARYLAND.

James E. Aaron
 SIGNATURE OF LICENSEE DATE 11/7/11

James E. Aaron
 PRINT NAME OF LICENSEE

J.AARON@MYACTV.NET
 Email Address

Validation
Check Number: <u>3787</u>
Cash: _____
Receipt Number: <u>260787</u>


Make check payable to: DIRECTOR OF FINANCE OF HOWARD COUNTY

Word doc: T:\Updated Forms\hvac application
 Rev:10.2009

Well + Septic

211001128

7

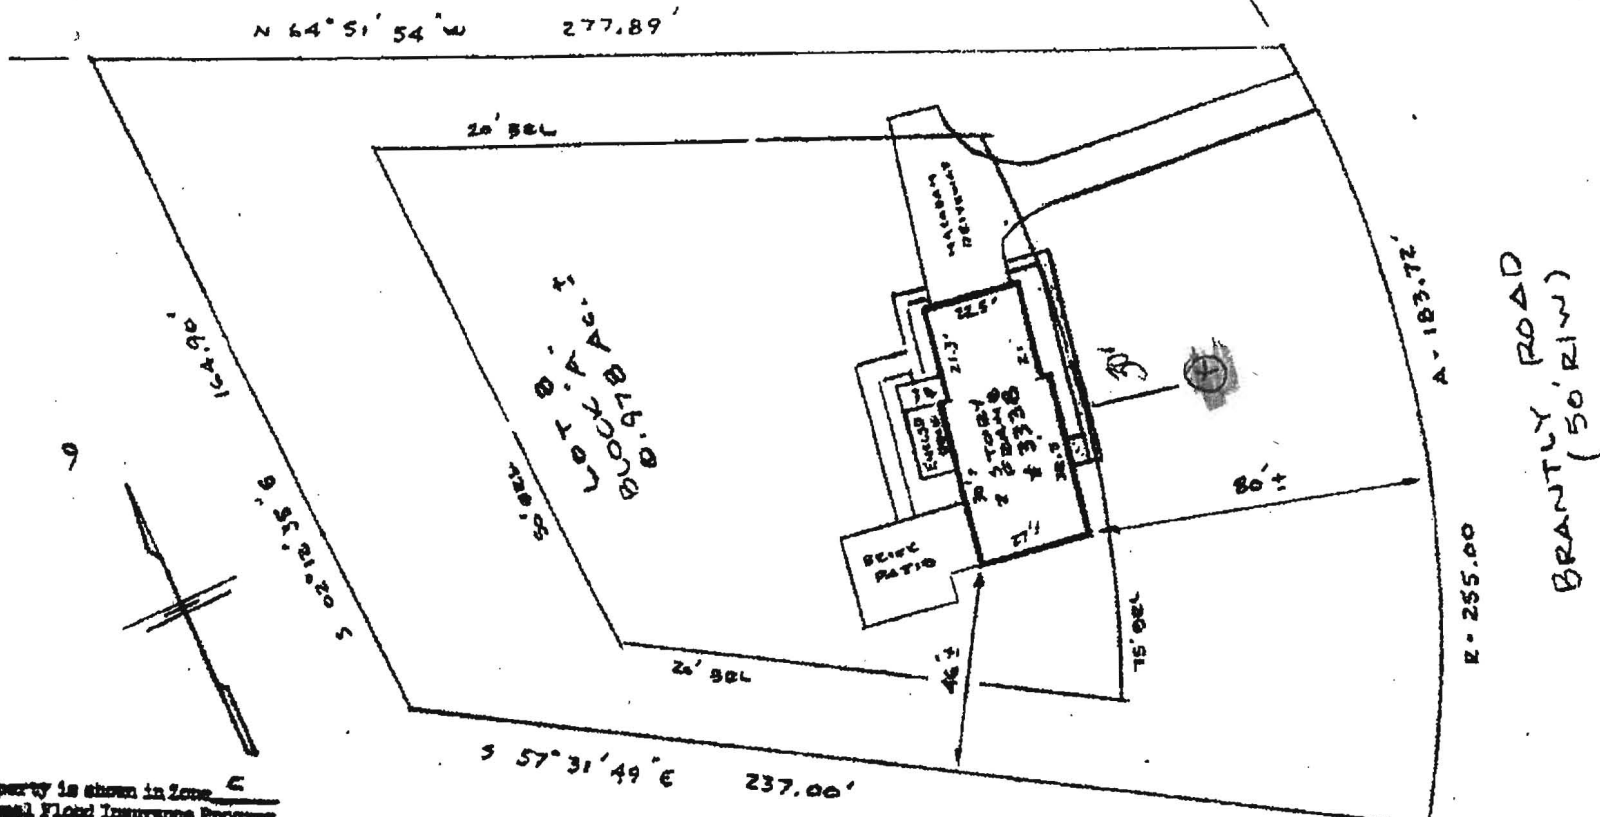

Subject property is shown in Zone C
 on the National Flood Insurance Program
 Flood Insurance Rate Map of HOWARD
 County, Maryland, Panel # 200245
 Community Panel # 240024-00208
 Effective Date: DEC 4, 1986

This is to certify that I have surveyed the property
 known as LOT B, BLOCK 'A'
3338 BRANTLY ROAD
 sheet of recorded PLAT NO. 3805 among the
 Land Records of HOWARD County, Maryland for the
 purpose of locating the improvements thereon.

THIS PLAT SHOWS ONLY THAT THE IMPROVEMENTS ARE
 CONTAINED WITHIN THE OUTLINES OF THE LOT AND IS
 NOT TO BE USED TO ESTABLISH PROPERTY LINES.



J. Carl Hur 15 PLS#96

LOCATION SURVEY
 3338 BRANTLY ROAD
 BRANTLY
 4TH ELECTION DISTRICT
 HOWARD COUNTY, MD.

NTT ASSOCIATES, INC.
 16205 Old Frederick Road
 Mt. Airy, Maryland 21771
 Phone 442-2031

Scale	1" = 40'
Date	FEB 5, 1993
Field By	JCH
Drawn By	JCH
Drawing #	X 99