

PUB. SEWER STATUS VERIFIED BY _____

ISSUE DATE: 7/24/2012

PERMIT

P 538001

APPROVAL DATE: _____

A REPAIR

Septic Repair ON-SITE SEWAGE DISPOSAL SYSTEM HOWARD COUNTY HEALTH DEPARTMENT BUREAU OF ENVIRONMENTAL HEALTH

South Carroll Backhoe IS PERMITTED TO INSTALL ALTER

ADDRESS: 4410 Salem Bottom Road, Westminster, MD 21157 PHONE NUMBER: 410-596-3618

SUBDIVISION: _____ LOT NUMBER: _____

ADDRESS: 3557 Church Road PROPERTY OWNER: Steven O'Conner

SEPTIC TANK CAPACITY (GALLONS): N/A (1000 exist)

PUMP CHAMBER CAPACITY (GALLONS): _____

NUMBER OF BEDROOMS: 4

SQUARE FEET OF HOUSE: 3378


LINEAR FEET OF TRENCH REQUIRED: 60

TRENCHES:	<u>Install 3x20' Trenches per layout (7/24/12, ref). Trenches 2 feet wide, Inlet at 4 feet with 7 feet of gravel under pipe. Trench Bottom at 11 feet from grade.</u>
LOCATION:	<u>Trenches are spaced at 14 feet edge-to-edge. Install top trench edge 10 feet from water service line. Install man hole access on septic tank. Install D-box.</u>
PURPOSE:	<u>Install observation pipes at trench ends. Dry Well Failed; crush dry well cap and fill void with clean earth material for Final Approval of Installation. Septic Tank and Dry Well have been pumped dry, 7/24/2012</u>
PLANS APPROVED:	<u>Robert Bricker</u> DATE: <u>7/24/2012</u>

- NOTE: PERMIT VOID AFTER 2 YEARS
- NOTE: CONTRACTOR RESPONSIBLE FOR SCHEDULING A PRE-CONSTRUCTION INSPECTION FOR ALL INSTALLATIONS
- NOTE: WATERTIGHT SEPTIC TANKS REQUIRED
- NOTE: ALL PARTS OF SEPTIC SYSTEM SHALL BE 100 FEET FROM ANY WATER WELL
- NOTE: MANHOLE RISERS REQUIRED ON ALL SEPTIC TANKS AND PUMP CHAMBERS

NEITHER THE HOWARD COUNTY COUNCIL OR THE HEALTH DEPARTMENT IS RESPONSIBLE FOR THE SUCCESSFUL OPERATION OF ANY SYSTEM PERMITTEE RESPONSIBLE FOR OBTAINING FINAL APPROVAL ON THIS PERMIT CALL 410-313-1771 FOR INSPECTION OF SEPTIC SYSTEM

NOT TO SCALE

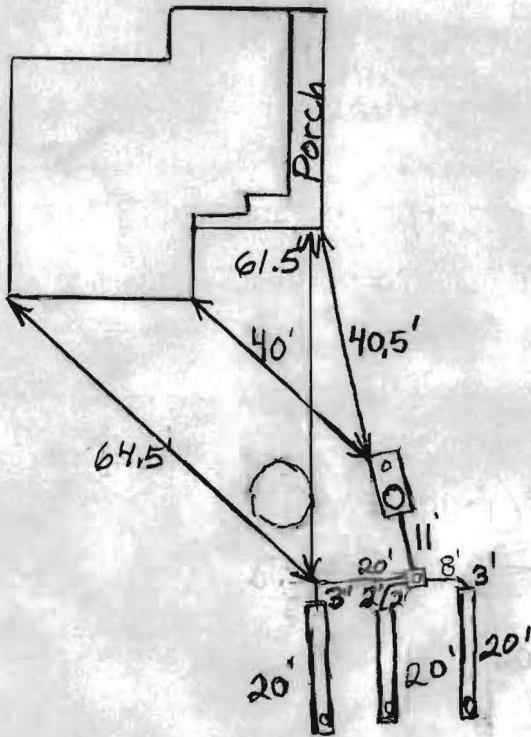

TRENCH/DRAINFIELD DATA

WIDTH	INLET	BOTTOM
2'	4'	11'
NUMBER OF TRENCHES 3		
TOTAL LENGTH 60'		
ABSORPTION AREA 420		
DISTRIBUTION BOX LEVEL Levelers		
DISTRIBUTION BOX BAFFLE Yes		
DISTRIBUTION BOX PORT Yes		

SEPTIC TANK DATA

SEPTIC TANK 1 LEVEL	Yes
MANUFACTURER	
CAPACITY	GAL
SEAM LOC	Midseam
TANK LID DEPTH	0.5'-1.5'
BAFFLES	Yes
BAFFLE FILTER	No
MANHOLE LOC	Rear
6" PORT LOC	Front
WATERTIGHT TEST	No
SLOTTED	No
DATE ON LID	N/A

~~PUMP/SEPTIC TANK LEVEL N/A~~

MANUFACTURER	
CAPACITY	GAL
SEAM LOC	
TANK LID DEPTH	
BAFFLES	
BAFFLE FILTER	
MANHOLE LOC	
6" PORT LOC	
WATERTIGHT TEST	
SLOTTED	
DATE ON LID	

PRE-CONSTRUCTION:

7/24/2012 Layout done by R. Bricker. (BB)

INSTALLATION: 7/25/2012 System finished Drywell pumped and collapsed, O.K. to backfill (BB)

FINAL INSPECTOR

B. Baker

DATE OF APPROVAL

7/25/2012