

PUB. SEWER STATUS VERIFIED BY _____

ISSUE DATE: 10/17/12

PERMIT

P 538072

APPROVAL DATE: 10/18/12

A REPAIR

Septic Repair ON-SITE SEWAGE DISPOSAL SYSTEM HOWARD COUNTY HEALTH DEPARTMENT BUREAU OF ENVIRONMENTAL HEALTH

J.M. Contracting LLC. IS PERMITTED TO INSTALL ALTER

ADDRESS: 425 Obrecht Road Sykesville, MD 21784 PHONE NUMBER: 443-277-7526

SUBDIVISION: _____ LOT NUMBER: _____

ADDRESS: 11476 Old Frederick Road PROPERTY OWNER: Stuart Blum

SEPTIC TANK CAPACITY (GALLONS): N/A Ex.

PUMP CHAMBER CAPACITY (GALLONS): —

NUMBER OF BEDROOMS: 4

SQUARE FEET OF HOUSE: _____

LINEAR FEET OF TRENCH REQUIRED: 90'

TRENCHES:	<u>2' wide</u> <u>4'-9'</u> <u>~60 ton stone.</u>
LOCATION:	
PURPOSE:	<u>Pump/collector Ex. Dvd. manhole on st.</u> <u>obs. pipes required @ trench ends.</u>


PLANS APPROVED: K. Wolf DATE: 10/17/12

- NOTE: PERMIT VOID AFTER 2 YEARS
- NOTE: CONTRACTOR RESPONSIBLE FOR SCHEDULING A PRE-CONSTRUCTION INSPECTION FOR ALL INSTALLATIONS
- NOTE: WATERTIGHT SEPTIC TANKS REQUIRED
- NOTE: ALL PARTS OF SEPTIC SYSTEM SHALL BE 100 FEET FROM ANY WATER WELL
- NOTE: MANHOLE RISERS REQUIRED ON ALL SEPTIC TANKS AND PUMP CHAMBERS

NEITHER THE HOWARD COUNTY COUNCIL OR THE HEALTH DEPARTMENT IS RESPONSIBLE FOR THE SUCCESSFUL OPERATION OF ANY SYSTEM PERMITTEE RESPONSIBLE FOR OBTAINING FINAL APPROVAL ON THIS PERMIT CALL 410-313-1771 FOR INSPECTION OF SEPTIC SYSTEM

NOT TO SCALE

↑ Ex Bar (Does Have H₂O from Public H₂O)

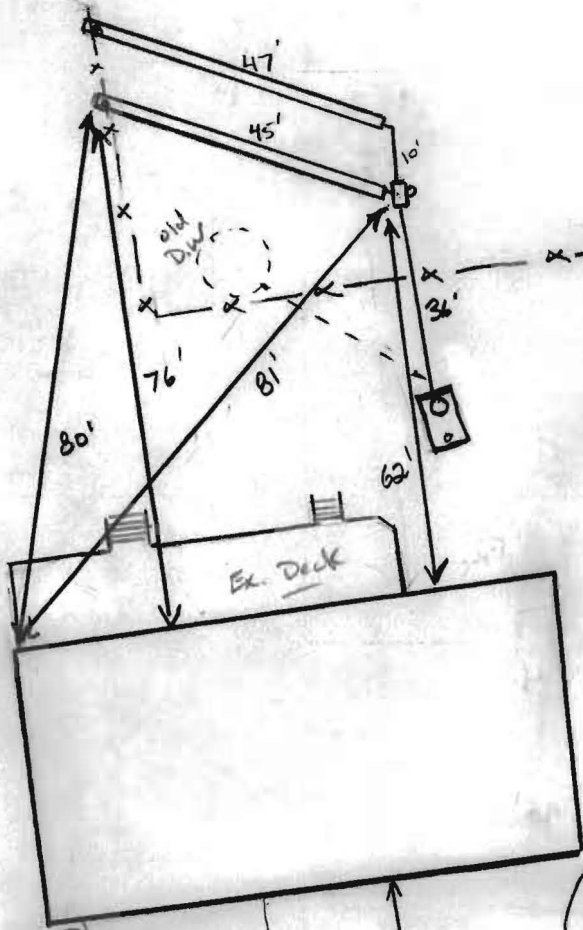

TRENCH/DRAINFIELD DATA

WIDTH	INLET	BOTTOM
2	4'	9'
NUMBER OF TRENCHES		2
TOTAL LENGTH		92
ABSORPTION AREA		184' ± SW
DISTRIBUTION BOX LEVEL		Levelers
DISTRIBUTION BOX BAFFLE		Yes
DISTRIBUTION BOX PORT		Yes (side)

SEPTIC TANK DATA

SEPTIC TANK I LEVEL	Ex.
MANUFACTURER	?
CAPACITY	1,000 GAL
SEAM LOC	mid
TANK LID DEPTH	2'
BAFFLES	Yes (new outlet)
BAFFLE FILTER	—
MANHOLE LOC	Rear
6" PORT LOC	Front
WATERTIGHT TEST	OK
SLOTTED	no
DATE ON LID	—

PUMP/SEPTIC TANK LEVEL N/A

MANUFACTURER	—
CAPACITY	— GAL
SEAM LOC	—
TANK LID DEPTH	—
BAFFLES	—
BAFFLE FILTER	—
MANHOLE LOC	—
6" PORT LOC	—
WATERTIGHT TEST	—
SLOTTED	—
DATE ON LID	—

Public H₂O

(HO-93-3213)

PRE-CONSTRUCTION:

10/17/12 Install new Dbox ~ 20' or so straight out from Ex S.T.
 Run 2x 45' trenches on contour across yard towards side fence
 running NW. Pump and collapse ex. Dry well. Manhole riser and new
 out let baffle must be installed on tank (P)

INSTALLATION:

10/18/12 system complete. OK to cover. Dbox tested.
 Ex. DW pumped and collapsed. Ex. well on pump still connected and
 in use by Front yard spicket only. Everything else on public H₂O.

FINAL INSPECTOR

J. Hoff

DATE OF APPROVAL

10/18/12

LAYOUT _____ INSP 4 _____

INSP 2 _____ INSP 5 _____

INSP 3 _____ INSP 6 _____

ISSUE DATE: _____

APPROVAL DATE: _____

P _____

A 525255 _____

PERMIT

INDEXED

TAX ID # 03-298035

ON-SITE SEWAGE DISPOSAL SYSTEM HOWARD COUNTY HEALTH DEPARTMENT BUREAU OF ENVIRONMENTAL HEALTH

_____ IS PERMITTED TO INSTALL ALTER

ADDRESS: _____ PHONE NUMBER: _____

SUBDIVISION: Marriott Manor LOT NUMBER: Parcel 14

ADDRESS: 11476 Old Frederick Road PROPERTY OWNER: Stuart G. Blum

SEPTIC TANK CAPACITY (GALLONS): _____ OUTLET BAFFLE FILTER REQUIRED

PUMP CHAMBER CAPACITY (GALLONS): _____ COMPARTMENTED TANK REQUIRED

NUMBER OF BEDROOMS: _____

SQUARE FEET PER BEDROOM: _____

LINEAR FEET OF TRENCH REQUIRED: _____

TRENCHES:	Trench to be _____ feet wide. Inlet _____ feet below original grade. Bottom maximum depth _____ feet below original grade. Effective area begins at _____ feet below original grade. _____ feet of stone below distribution pipe.
LOCATION:	_____
NOTES:	_____

PLANS APPROVED: _____ DATE: _____

- NOTE: PERMIT VOID AFTER 2 YEARS
- NOTE: CONTRACTOR RESPONSIBLE FOR SCHEDULING A PRE-CONSTRUCTION INSPECTION FOR ALL INSTALLATIONS
- NOTE: WATERTIGHT SEPTIC TANKS REQUIRED
- NOTE: ALL PARTS OF SEPTIC SYSTEM SHALL BE 100 FEET FROM ANY WATER WELL
- NOTE: MANHOLE RISERS REQUIRED ON ALL SEPTIC TANKS AND PUMP CHAMBERS UNLESS SPECIFICALLY AUTHORIZED

NEITHER THE HOWARD COUNTY COUNCIL NOR THE HEALTH DEPARTMENT IS RESPONSIBLE FOR THE SUCCESSFUL OPERATION OF ANY SYSTEM PERMITTEE RESPONSIBLE FOR OBTAINING FINAL APPROVAL ON THIS PERMIT CALL 410-313-2640 FOR INSPECTION OF SEPTIC SYSTEM

A 525255