

PUB. SEWER STATUS VERIFIED BY _____

ISSUE DATE: 6/28/10

PERMIT

P 533310

APPROVAL DATE: 7/12/10

A REPAIR

Minor Septic Repair ON-SITE SEWAGE DISPOSAL SYSTEM HOWARD COUNTY HEALTH DEPARTMENT BUREAU OF ENVIRONMENTAL HEALTH

Fogles Septic Clean Inc. IS PERMITTED TO INSTALL ALTER

ADDRESS: 580 Obrecht Road Sykesville, MD 21784 PHONE NUMBER: 410-795-5670

SUBDIVISION: _____ LOT NUMBER: 12

ADDRESS: 14108 Barbara Circle PROPERTY OWNER: James Parbuoni

SEPTIC TANK CAPACITY (GALLONS): N/A Inlet 35'-4'

PUMP CHAMBER CAPACITY (GALLONS): _____ Bottom 8'

NUMBER OF BEDROOMS: _____

SQUARE FEET OF HOUSE: _____ Trench 3' Wide

LINEAR FEET OF TRENCH REQUIRED: 53'


TRENCHES:	
LOCATION:	
PURPOSE:	Replace pump in pump chamber and add an alarm to the system. Line between the septic tank and pump chamber needs to be repaired.

PLANS APPROVED: _____ DATE: _____

- NOTE: PERMIT VOID AFTER 2 YEARS
- NOTE: CONTRACTOR RESPONSIBLE FOR SCHEDULING A PRE-CONSTRUCTION INSPECTION FOR ALL INSTALLATIONS
- NOTE: WATERTIGHT SEPTIC TANKS REQUIRED
- NOTE: ALL PARTS OF SEPTIC SYSTEM SHALL BE 100 FEET FROM ANY WATER WELL
- NOTE: MANHOLE RISERS REQUIRED ON ALL SEPTIC TANKS AND PUMP CHAMBERS

NEITHER THE HOWARD COUNTY COUNCIL OR THE HEALTH DEPARTMENT IS RESPONSIBLE FOR THE SUCCESSFUL OPERATION OF ANY SYSTEM PERMITTEE RESPONSIBLE FOR OBTAINING FINAL APPROVAL ON THIS PERMIT CALL 410-313-1771 FOR INSPECTION OF SEPTIC SYSTEM

NOT TO SCALE

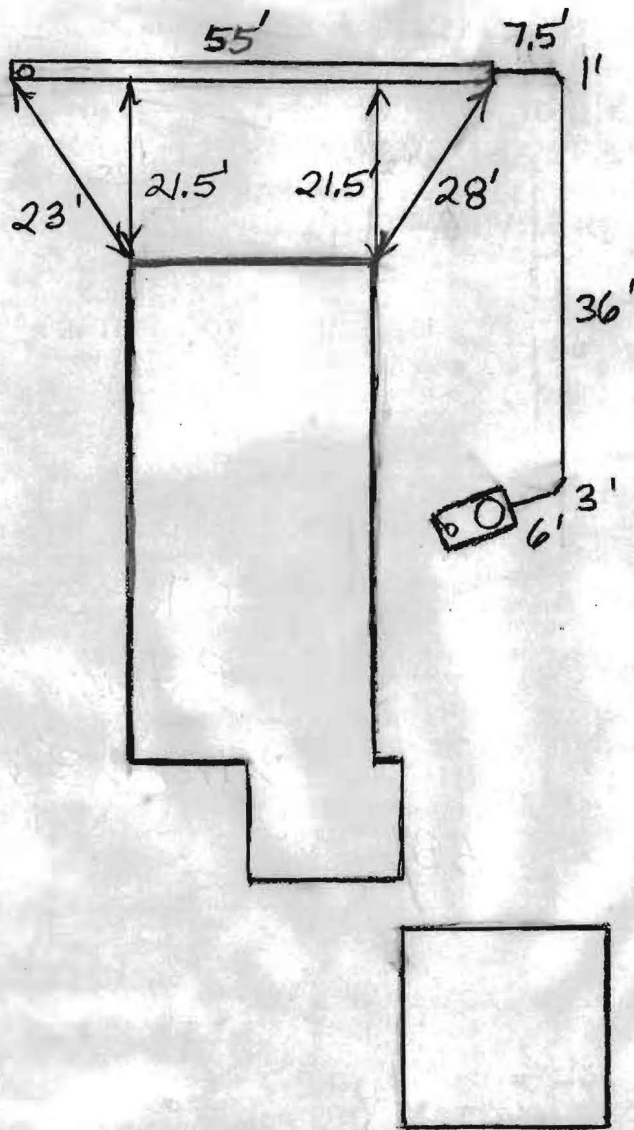

TRENCH/DRAINFIELD DATA		
WIDTH	INLET	BOTTOM
3'	4'	8'
NUMBER OF TRENCHES		1
TOTAL LENGTH		55'
ABSORPTION AREA		165 + Sidewall
DISTRIBUTION BOX LEVEL		
DISTRIBUTION BOX BAFFLE		<input checked="" type="checkbox"/>
DISTRIBUTION BOX PORT		<input checked="" type="checkbox"/>

SEPTIC TANK DATA	
SEPTIC TANK 1 LEVEL	Yes
MANUFACTURER	
CAPACITY	
SEAM LOC	Midseam
TANK LID DEPTH	4.5'-5'
BAFFLES	Yes
BAFFLE FILTER	No
MANHOLE LOC	Rear
6" PORT LOC	Front
WATERTIGHT TEST	No
SLOTTED	No
PUMP/SEPTIC TANK LEVEL	N/A
MANUFACTURER	
CAPACITY	
SEAM LOC	
TANK LID DEPTH	
BAFFLES	
BAFFLE FILTER	
MANHOLE LOC	
6" PORT LOC	
WATERTIGHT TEST	
SLOTTED	

PRE-CONSTRUCTION
 7/9/2010 Install one trench exactly 20' from the side of the house. Keep trench towards

front yard. Pump out and fill drywell with dirt. (BB)
 7/12/2010 System finished. Drywell filled in. O.K. to
 INSTALLATION: cover (BB)

FINAL INSPECTOR B. Baker DATE OF APPROVAL 7/12/10