

Bureau of Environmental Health
 7178 Gateway Drive Columbia, MD 21046
 (410) 313-2640 Fax (410) 313-2648
 TDD (410) 313-2323 Toll Free 1-866-313-6300
 website: www.hchealth.org

Maura J. Rossman, M.D., Acting Health Officer

APPLICATION FOR PERCOLATION TESTING AND SITE EVALUATION

PROPERTY LOCATION

SUBDIVISION/PROPERTY NAME _____ LOT # _____
 PROPERTY ADDRESS 7073 Mink Hollow Rd Highland MD 20777
STREET TOWN ZIP
 TAX ACCOUNT # _____ TAX MAP 40 GRID 8 PARCEL 358 ZONING DESIGNATION 4

PROPERTY OWNER(S) LISA Faraone

DAYTIME PHONE 240-423-2691 CELL _____ EMAIL _____

MAILING ADDRESS same
STREET CITY, STATE ZIP

APPLICANT Fogle's Septic Clean RELATIONSHIP TO OWNER: Agent/contractor

DAYTIME PHONE 410-795-5670 CELL _____ EMAIL Kim@FoglesInc.com

MAILING ADDRESS 580 Obrecht Rd Sykesville, MD 21784
STREET CITY, STATE ZIP

I HEREBY APPLY FOR THE NECESSARY TESTING/EVALUATION PRIOR TO ISSUANCE OF SEWAGE DISPOSAL SYSTEM PERMIT(S):

BUILDING:

- RESIDENTIAL WITH _____ EXISTING OR PROPOSED BEDROOMS IN THE COMPLETED STRUCTURE
- COMMERCIAL (PROVIDE DETAIL OF TYPE OF USE AND NUMBERS OF EMPLOYEES/CUSTOMERS ON ACCOMPANYING PLAN)

PROPERTY:

- SUBDIVISION: NUMBER OF LOTS INCLUDING RESIDUE: _____
- CONSTRUCT NEW OSDS ON UNDEVELOPED LOT
- REPAIR OR REPLACE FAILING OSDS
- UPGRADE EXISTING OSDS

IS THE PROPERTY WITHIN 2500 FEET OF ANY RESERVOIR?

- YES
- NO

AS APPLICANT, I UNDERSTAND THE FOLLOWING:

- THIS APPLICATION IS VALID FOR TWO(2) YEARS FROM DATE OF FEE PAYMENT AND APPROVAL IS BASED UPON HEALTH OFFICER SIGNATURE OF A PERC CERTIFICATION PLAN PRIOR TO EXPIRATION OF THIS PERMIT.
- THE APPLICATION FEE IS NON-REFUNDABLE
- THIS APPLICATION MUST BE ACCOMPANIED BY ALL APPLICABLE FEES AND A SUITABLE SITE PLAN IN ORDER TO BE PROCESSED
- THIS IS A PUBLIC DOCUMENT


I declare and affirm that to the best of my knowledge, the information contained herein is correct. I declare that I am the owner of the property or duly authorized to make this application on behalf of the owner. I agree to comply with all applicable state and county regulations.

By signature of this application, I hereby grant Howard County Health Department officials the right to enter onto the property for the purpose of inspecting the property as directly related to the requested permit/service.

[Signature] (AGENT FOGLE'S SEPTIC) 1/27/2015
 SIGNATURE OF APPLICANT DATE

7073 mink Hollow Rd

AP 555724

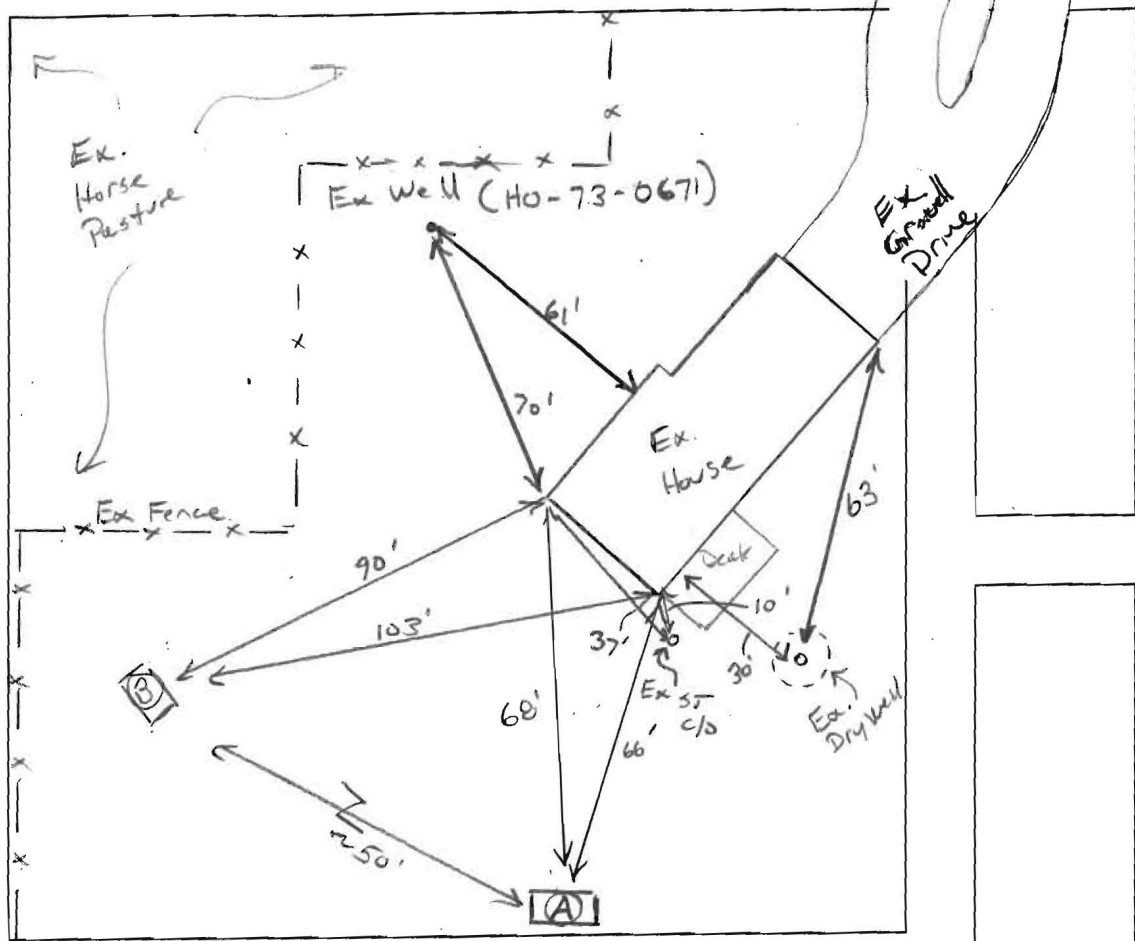

(A)

0-2' ORG. WKB
 2' Dark Yellow CL
 Friable, Dry, MOK
 Bullets
 4' Br/Y SL
 Friable, Dry
 25BK, 5% rock
 6' Br/Y SL, wk platy 5% rock, 10% Sph. High mica
 13'8" ↓

(B)

12' ORG. D.K. G.L.
 WMBK
 Br CL, CW, Friable, 5% mica
 3' Br/Y L, wk SK, Friable
 4' Br/Y SL, wk platy, mica, rock, Dry
 6-8' Br/Y/R FSL, Highly mica, no rd, Dry, 10% wk sp.
 14' 10' strays Platy SL

DATE	TEST #	DEPTH	START	BREAK 1" DROP	STOP 2" DROP	TIME OF 2ND INCH	P/F/H	
2/6/14	(A)	65' 134'	1:03	1:05	1:09	4	(P)	
		H2O found @ bottom ~ 120psi						
	(B)	vd vent OK						

REMARKS Hole (A) slightly more ex contact. Hole (B) no ex.




SANITARIAN DK, Wolf BACKHOE Ed = Fugles OTHERS

TEST HOLES USED IN SDA 2 AVG. PERC TIME 4 SQ. FT/BR 1.2

TRENCH WIDTH 3 INLET DEPTH 4.5' MAX. BOT DEPTH 8' EFFECTIVE S/W 5.5'

Design = $150(4) = 600 \text{ gal} / 1.2 \text{ gal/ft}^2 = 500 \text{ ft}^2 \div 3 = 166 (.55) = 91 \text{ LF}$

PASTURE

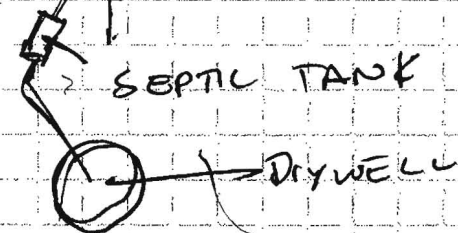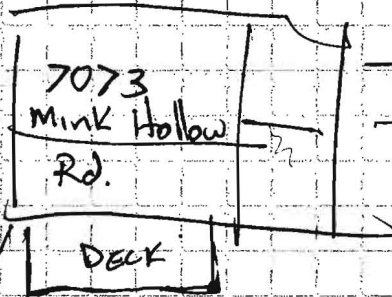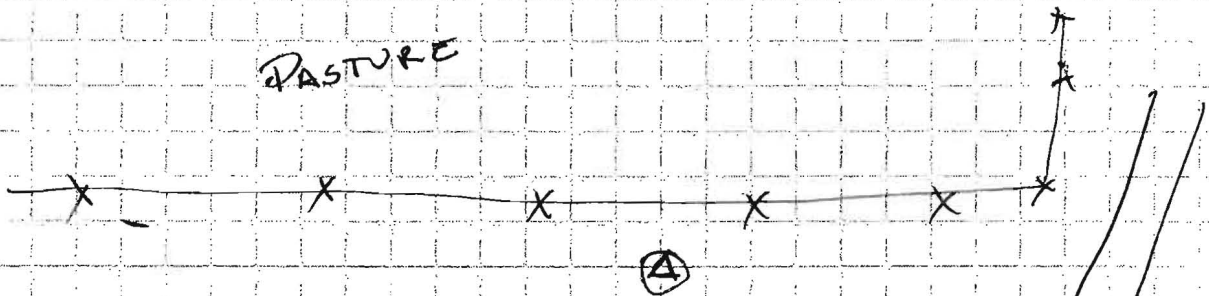

WOODED
AREA