

PUB. SEWER STATUS VERIFIED BY \_\_\_\_\_

ISSUE DATE: 09/10/07

P 527338

APPROVAL DATE: 12/13/07

**PERMIT**  
*Logged Into Permit Manager*  
Tax ID # **03-295648**

A REPAIR

*10/16/07  
11/8/07  
11/9/07*

**ON-SITE SEWAGE DISPOSAL SYSTEM  
HOWARD COUNTY HEALTH DEPARTMENT  
BUREAU OF ENVIRONMENTAL HEALTH**

Fogles Septic Clean, Inc IS PERMITTED TO INSTALL  ALTER

ADDRESS: 580 Obrecht Road PHONE NUMBER: 410-795-5670

SUBDIVISION: \_\_\_\_\_ LOT NUMBER: \_\_\_\_\_

ADDRESS: 12102 Frederick Road PROPERTY OWNER: Autumn Williams

SEPTIC TANK CAPACITY (GALLONS): \_\_\_\_\_ *Trenches 2' Wide*  
PUMP CHAMBER CAPACITY (GALLONS): 1500 *Inlet 3.5'*  
NUMBER OF BEDROOMS: 5 *Bottom 8.5'*  
SQUARE FEET PER BEDROOM: \_\_\_\_\_ *3-50' Trenches*  
LINEAR FEET OF TRENCH REQUIRED: 150'

TRENCHES:	Trench to be _____ feet wide. Inlet _____ feet below original grade. Bottom maximum depth _____ feet below original grade. Effective area begins at _____ feet below original grade. _____ feet of stone below distribution pipe.
LOCATION:	<i>In Back Yard, Directly Uphill of Swing Set</i>
PURPOSE:	Existing septic system has failed. Call for inspection when ground is opened so sanitarian can recommend repair.


PLANS APPROVED: B. Baber DATE: 10/16/07

- NOTE: PERMIT VOID AFTER 2 YEARS
- NOTE: CONTRACTOR RESPONSIBLE FOR SCHEDULING A PRE-CONSTRUCTION INSPECTION FOR ALL INSTALLATIONS
- NOTE: WATERTIGHT SEPTIC TANKS REQUIRED
- NOTE: ALL PARTS OF SEPTIC SYSTEM SHALL BE 100 FEET FROM ANY WATER WELL
- NOTE: MANHOLE RISERS REQUIRED ON ALL SEPTIC TANKS AND PUMP CHAMBERS

**NEITHER THE HOWARD COUNTY COUNCIL OR THE HEALTH DEPARTMENT IS RESPONSIBLE FOR THE SUCCESSFUL OPERATION OF ANY SYSTEM PERMITTEE RESPONSIBLE FOR OBTAINING FINAL APPROVAL ON THIS PERMIT CALL 410-313-2640 FOR INSPECTION OF SEPTIC SYSTEM**

*Contact Health Department If You Are Going to Use EZ Flow - Specs. May Change*

RT. 144

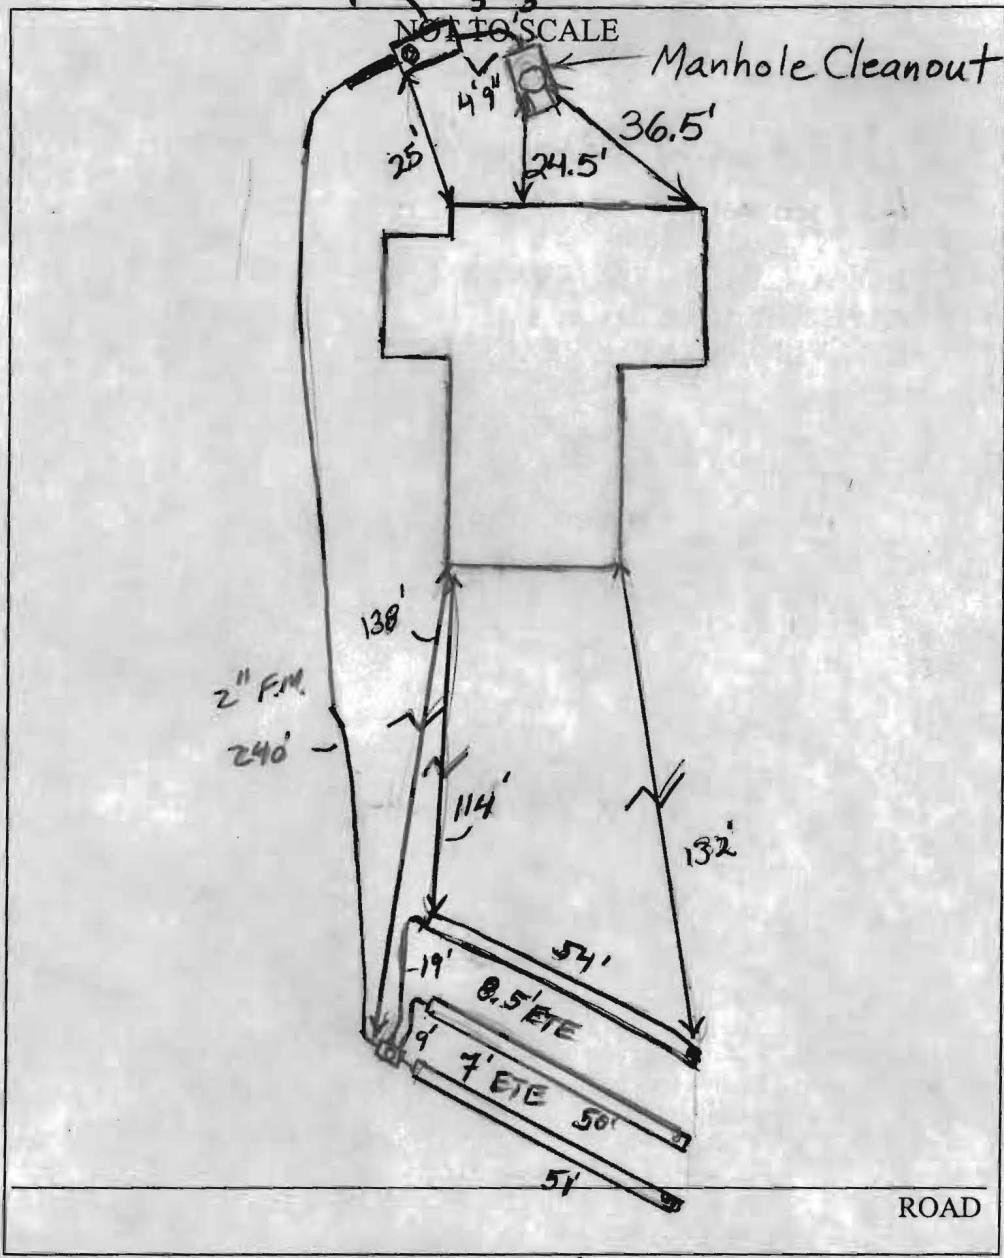

TRENCH/DRAINFIELD DATA		
WIDTH	INLET	BOTTOM
2'	3.5'	8.5'
NUMBER OF TRENCHES		3
TOTAL LENGTH		155'
ABSORPTION AREA		310' ± SW
DISTRIBUTION BOX LEVEL		Yes
DISTRIBUTION BOX BAFFLE		No (90°)
DISTRIBUTION BOX PORT		Yes

SEPTIC TANK DATA	
SEPTIC TANK 1 LEVEL	Yes
CAPACITY	1500 GAL
SEAM LOC	Top
TANK LID DEPTH	1.5'
BAFFLES	Yes
BAFFLE FILTER	NO
MANHOLE LOC	Center
6" PORT LOC	Front
WATERTIGHT TEST	—
SEPTIC TANK 2 LEVEL	Yes
CAPACITY	1500 GAL
SEAM LOC	Top
TANK LID DEPTH	2'
BAFFLES	Front
BAFFLE FILTER	NO
MANHOLE LOC	Rear
6" PORT LOC	None
WATERTIGHT TEST	—

PRE-CONSTRUCTION 10/16/07 Trenches directly uphill of searing set. EZ Flow may be needed due to hill in back yard. (BB)

INSTALLATION 11/8/07 Contractor installed Highest absorption trench and 1/2 way dug middle trench w/ new spec's. (3.5'-8.5' Contractor dug second trench 7' ETE from Top trench. Told contractor keep 9' separation to edges on last trench. OK to continue (KW) 11/9/07 Pump tank set. Need Pump and alarm test. Final trench dug. complete (KW) 12/13/07 Pump and alarm working. (BB)

FINAL INSPECTOR B. Baker DATE OF APPROVAL 12/13/07