

DEPT. OF INSPECTIONS, LICENSES AND PERMITS
 3430 COURT HOUSE DRIVE
 ELLICOTT CITY, MD 21043
 PERMITS (410) 313-2455
 INSPECTIONS (410) 313-1910
 AUTOMATED INFORMATION (410) 313-3800

**HOWARD COUNTY
 PERMIT APPLICATION**

**308001296
 PERMIT NUMBER**

Building Address 3330 BRANTLY RD
GLENWOOD MD 21738
 Suite/Apt. #: _____ SDP/WP/Petition #:
 Census Tract 6040 Subdivision BRANTLY
 Section 2 Area 1 Lot 6
 Tax Map 21 Parcel 185 Grid _____
 Zoning _____ Map Coordinates _____ Lot Size 9220

Property Owner's Name EILEEN HOGAN MARKERT
 Address 3330 BRANTLY RD
 City GLENWOOD State MD Zip Code 21738
 Phone 443-266-7300 Phone 443-326-0062
 Applicant's Name & Mailing Address, (if other than stated herein):

 Phone _____ Fax _____

Existing Use DECK
 Proposed Use ROOF OVER DECK
 Estimated Construction Cost \$ 5000.00
 Description of Work BUILD ROOF OVER
EXISTING DECK
37' x 20'
 Occupant or Tenant ROBERT & EILEEN MARKERT
 Contact Name SCOTT MARKERT
 Address 3330 BRANTLY RD
 City Glenwood State MD Zip Code 21738
 Phone 443-266-7300 Fax _____

Contractor Company SELF
 Contact Person _____
 Address _____
 City _____ State _____ Zip Code _____
 License No. _____
 Phone _____ Fax _____
 Engineer or Architect Company NONE
 Contact Person _____
 Address _____
 City _____ State _____ Zip Code _____
 Phone _____ Fax _____

BUILDING DESCRIPTION - COMMERCIAL

BUILDING DESCRIPTION - RESIDENTIAL

Building Characteristics
 Height: _____
 No. of stories: _____
 Gross area, sq. ft. per floor: _____
 Use group: _____
 Construction type:
 _____ Reinforced Concrete
 _____ Structural Steel
 _____ Masonry
 _____ Wood Frame
 _____ State Certified Modular

Utilities
 Water Supply:
 _____ Public
 _____ Private
 Sewage Disposal:
 _____ Public
 _____ Private
 Electric Yes No
 Gas Yes No
 Heating System:
 Electric Oil
 Natural Gas
 Propane Gas
 Sprinkler system: N/A
 _____ Full
 _____ Partial
 _____ Other Suppression
 _____ # of Heads

Building Characteristics
 SF Dwelling SF Townhouse
 Depth _____ Width _____
 1st floor: _____
 2nd floor: _____
 Basement: _____
 Finished Basement Unfinished Basement
 Crawl space Slab on Grade
 No. of Bedrooms 4
 Multi-family dwellings:
 No. of efficiency units: _____
 No. of 1 BR units: _____
 No. of 2 BR units: _____
 No. of 3 BR units: _____
 Other Structure: _____
 Dimensions: _____
 Footings: _____
 Roof Height: _____
 _____ State Certified Modular
 _____ Manufactured Home


Utilities
 Water Supply:
 _____ Public
 _____ Private
 Sewage Disposal:
 _____ Public
 _____ Private
 Electric Yes No
 Gas Yes No
 Heating System:
 Electric Oil
 Natural Gas
 Propane Gas
 Sprinkler system: N/A
 _____ NFPA #13D
 _____ NFPA #13R
 _____ Other.

THE UNDERSIGNED HEREBY CERTIFIES AND AGREES AS FOLLOWS: (1) THAT HE/SHE IS AUTHORIZED TO MAKE THIS APPLICATION; (2) THAT THE INFORMATION IS CORRECT; (3) THAT HE/SHE WILL COMPLY WITH ALL REGULATIONS OF HOWARD COUNTY WHICH ARE APPLICABLE THERETO; (4) THAT HE/SHE WILL PERFORM NO WORK ON THE ABOVE REFERENCED PROPERTY NOT SPECIFICALLY DESCRIBED IN THIS APPLICATION; (5) THAT HE/SHE GRANTS COUNTY OFFICIALS THE RIGHT TO ENTER ONTO THIS PROPERTY FOR THE PURPOSE OF INSPECTING THE WORK PERMITTED AND POSTING NOTICES.

Eileen F.A. (Hogan) Markert Eileen F.A. (HOGAN) MARKERT
 Applicant's Signature Print Name

 Title/Company Date

Checks payable to: **DIRECTOR OF FINANCE OF HOWARD COUNTY**
 PLEASE WRITE NEATLY AND LEGIBLY.
 - FOR OFFICE USE ONLY -

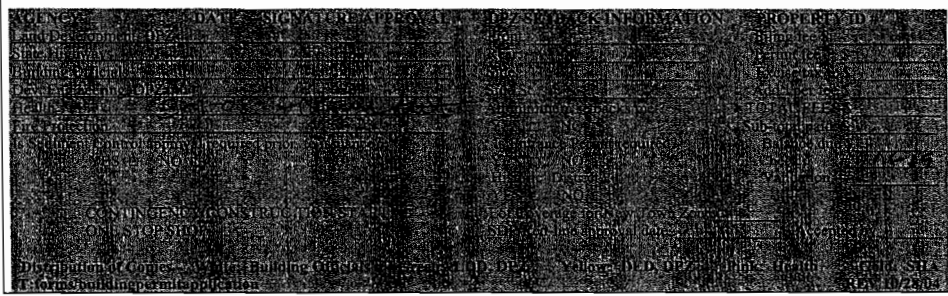

N25°17'45"E

222.16'

Wall

50' B.R.L.

95±

Lot G
Block "A"
Proposed
roof
~~Proposed~~
Deck

POOL

44'

42'

20'

25.2'

2 Sty
Alum

1 Sty
Alum

3320

30.7'

22.0'

Core Walk

Mac
Drive

72±

Septic
Tank

75' B.R.L. 7

Drive

100 Year Flood Plain & Drainage
Easement

Macadam

S61°42'15"E
0.71'

L=95.44'

4800'
S25°17'45"W

APPROVED

WALK-THRU BUILDING PERMIT

BP# B08001296 A#

APP. SAN HS


DATE: 5/22/88

DESC. OF WORK: roof over
existing deck (37' x 20')

BRANTLY

ROAD

22± Mac Paving

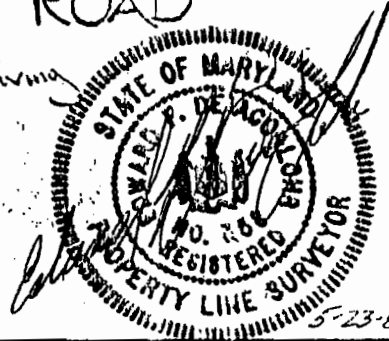

Note: The Flood Plain Crosses Property as Shown.
THIS IS TO CERTIFY That The Improvements Indicated
Hereon Are Located As Shown. This Is Not A Property
Line Survey And Should Not Be Used As Such.

HICKS ENGINEERING COMPANY, INC.

ENGINEERS • SURVEYORS • PLANNERS

200 EAST JOPPA ROAD - SUITE 402

TOWSON, MARYLAND 21204

TELEPHONE: 301/494-0001

LOCATION CERTIFICATION

#3320 BRANTLY ROAD, LOT G, BLK "A"
"BRANTLY - SECT. 2, AREA 1, SHT 1 OF 2
HOWARD CO., MD. PLAT C14P# 3205

DATE: 5/22/88

SCALE: 1"=30'

FILE: 5867