

LAYOUT 5/9/07 (KW) INSP 4 \_\_\_\_\_  
 INSP 2 5/10/07 (KW) INSP 5 \_\_\_\_\_  
 INSP 3 \_\_\_\_\_ INSP 6 \_\_\_\_\_

ISSUE DATE: 5/3/07

P 526680

APPROVAL DATE: 5/10/07 (KW)

A 526647

# PERMIT

## ON-SITE SEWAGE DISPOSAL SYSTEM HOWARD COUNTY HEALTH DEPARTMENT BUREAU OF ENVIRONMENTAL HEALTH

Zepp Plumbing and Heating IS PERMITTED TO INSTALL  ALTER

ADDRESS: \_\_\_\_\_ PHONE NUMBER: \_\_\_\_\_

SUBDIVISION: \_\_\_\_\_ LOT NUMBER: \_\_\_\_\_

ADDRESS: 11505 Johns Hopkins Rd. PROPERTY OWNER: Jerry and Nancy Berson

SEPTIC TANK CAPACITY (GALLONS): \_\_\_\_\_ TOTAL \_\_\_\_\_ OUTLET BAFFLE FILTER REQUIRED   
 OF 1500

PUMP CHAMBER CAPACITY (GALLONS): N/A COMPARTMENTED TANK REQUIRED

NUMBER OF BEDROOMS: 3

SQUARE FOOTAGE OF HOUSE: ~2000  
Proposed


LINEAR FEET OF TRENCH REQUIRED: N/A

	NO ALTERATION TO TRENCHES/DRYWELLS ALLOWED UNDER THIS PERMIT <b>*A LAYOUT INSPECTION IS REQUIRED PRIOR TO THE START OF WORK*</b>
LOCATION:	New tank to be installed in a location closer to the existing house than the current tank, unless the new tank is smaller than the existing tank; in which case the smaller tank must be installed last in sequence.
NOTES:	A new tank is to be installed to a total of 1,500 gallons septic tank capacity. If the existing septic tank is to be allowed to remain, it must first be proven to be in good condition; ie: no leaks, baffles intact, etc., and be evaluated for appropriate total volume prior to installation of the new septic tank. This must be confirmed by HCHD Inspection personnel prior to the start of the installation.

PLANS APPROVED: Gabriel A. Creighton DATE: 5/3/2007

- NOTE: PERMIT VOID AFTER 2 YEARS
- NOTE: CONTRACTOR RESPONSIBLE FOR SCHEDULING A PRE-CONSTRUCTION INSPECTION FOR ALL INSTALLATIONS
- NOTE: WATERTIGHT SEPTIC TANKS REQUIRED
- NOTE: ALL PARTS OF SEPTIC SYSTEM SHALL BE 100 FEET FROM ANY WATER WELL
- NOTE: MANHOLE RISERS REQUIRED ON ALL SEPTIC TANKS AND PUMP CHAMBERS UNLESS SPECIFICALLY AUTHORIZED

**NEITHER THE HOWARD COUNTY COUNCIL NOR THE HEALTH DEPARTMENT IS RESPONSIBLE FOR THE SUCCESSFUL OPERATION OF ANY SYSTEM PERMITTEE RESPONSIBLE FOR OBTAINING FINAL APPROVAL ON THIS PERMIT CALL 410-313-1771 FOR INSPECTION OF SEPTIC SYSTEM**

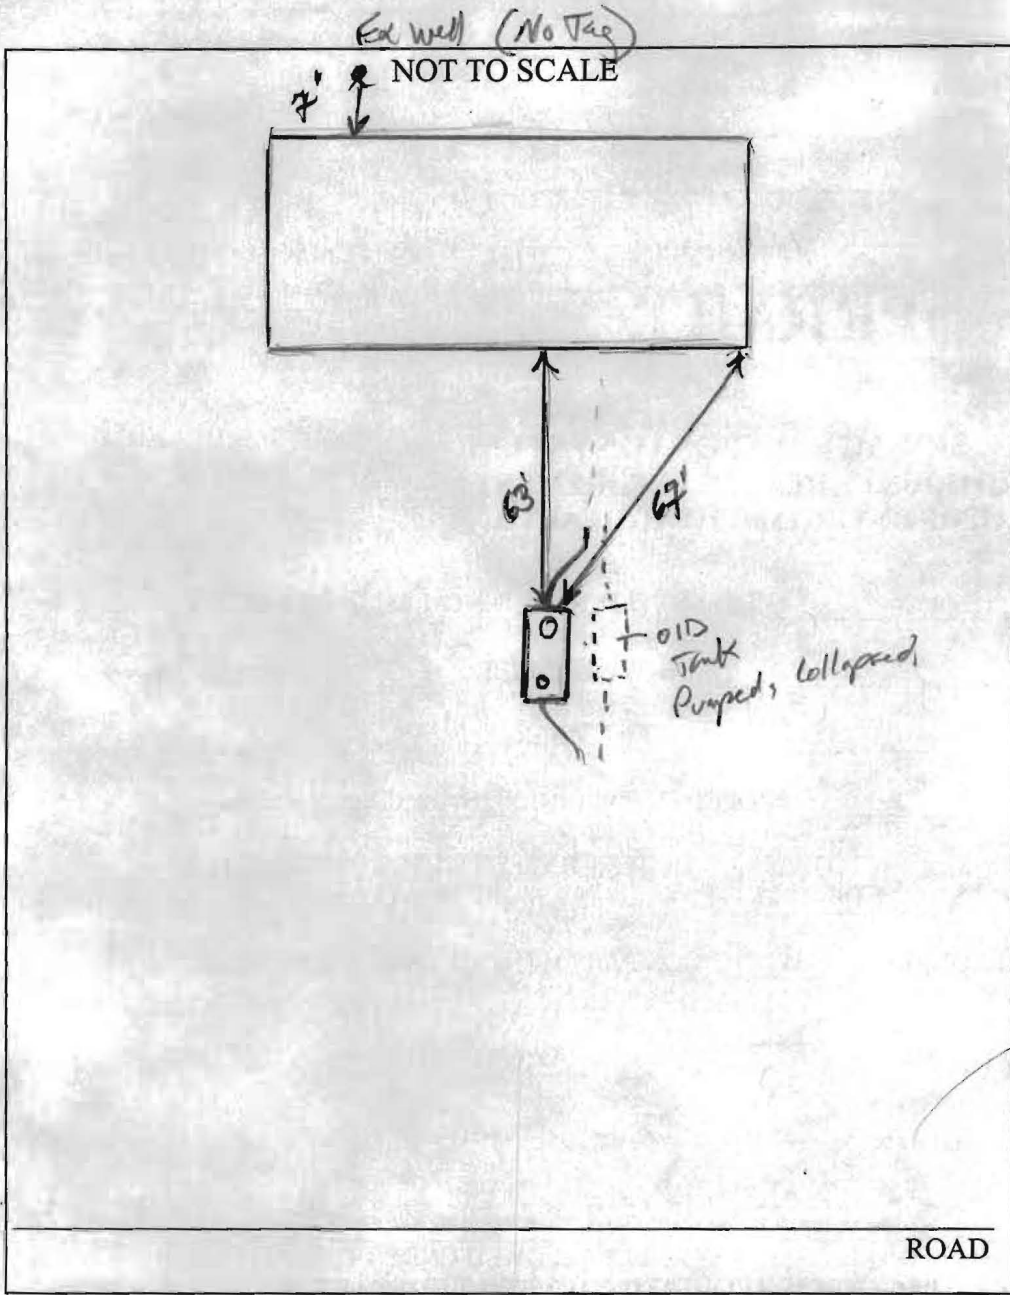

**TRENCH/DRAINFIELD DATA**

WIDTH	INLET	BOTTOM
_____	_____	_____
NUMBER OF TRENCHES _____		
TOTAL LENGTH _____		
ABSORPTION AREA _____		
DISTRIBUTION BOX LEVEL _____		
DISTRIBUTION BOX BAFFLE _____		
DISTRIBUTION BOX PORT _____		

**SEPTIC TANK DATA**

SEPTIC TANK 1 LEVEL land

CAPACITY 1500 GAL

SEAM LOC Top

TANK LID DEPTH 3'-5'

BAFFLES Yes 6" F

BAFFLE FILTER —

MANHOLE LOC Front

6" PORT LOC Rear

WATERTIGHT TEST —

SEPTIC TANK 2 LEVEL \_\_\_\_\_

CAPACITY \_\_\_\_\_ GAL

SEAM LOC \_\_\_\_\_

TANK LID DEPTH \_\_\_\_\_

BAFFLES \_\_\_\_\_

BAFFLE FILTER \_\_\_\_\_

MANHOLE LOC \_\_\_\_\_

6" PORT LOC \_\_\_\_\_

WATERTIGHT TEST \_\_\_\_\_

Mayer Bas  
Zump  
Slotted.

old Tank Pumped, collapsed

ROAD

PRE-CONSTRUCTION \_\_\_\_\_

INSTALLATION 5/9/07 New tank set. Mayer bas. To connect to existing septic. Old Tank pumped and collapsed. Need to see baffles in tank. (KW)

5/10/07 Baffles in tank. Grade set same as 4.5' @ front of tank. OK to cover. (KW)

FINAL INSPECTOR J. Way DATE OF APPROVAL 5/10/07