

PUB. SEWER STATUS VERIFIED BY _____

ISSUE DATE: 2-13-12

P 536717

APPROVAL DATE: 2/16/2012

A REPAIR

PERMIT

Septic Repair # 3291715

ON-SITE SEWAGE DISPOSAL SYSTEM
HOWARD COUNTY HEALTH DEPARTMENT
BUREAU OF ENVIRONMENTAL HEALTH

Freedom Septic IS PERMITTED TO INSTALL ALTER

ADDRESS: 2809 Liberty Road, Eldersburg MD 21784 PHONE NUMBER: 410-795-2947

SUBDIVISION: _____ LOT NUMBER: _____

ADDRESS: 12341 Pan Springs Court PROPERTY OWNER: Stephen Martin

SEPTIC TANK CAPACITY (GALLONS): N/A Application Rate: 0.8

PUMP CHAMBER CAPACITY (GALLONS): N/A

NUMBER OF BEDROOMS: 4

SQUARE FEET OF HOUSE: _____

LINEAR FEET OF TRENCH REQUIRED: 155'


TRENCHES:	Install 2 x 78' trenches on contour. 4' inlet, 7' bottom. Effective area begins at 5'. Trenches 3' wide.
LOCATION:	Collapse ex. drywell.
PURPOSE:	

PLANS APPROVED: HS DATE: 2-13-12

- NOTE: PERMIT VOID AFTER 2 YEARS
- NOTE: CONTRACTOR RESPONSIBLE FOR SCHEDULING A PRE-CONSTRUCTION INSPECTION FOR ALL INSTALLATIONS
- NOTE: WATERTIGHT SEPTIC TANKS REQUIRED
- NOTE: ALL PARTS OF SEPTIC SYSTEM SHALL BE 100 FEET FROM ANY WATER WELL
- NOTE: MANHOLE RISERS REQUIRED ON ALL SEPTIC TANKS AND PUMP CHAMBERS

NEITHER THE HOWARD COUNTY COUNCIL OR THE HEALTH DEPARTMENT IS RESPONSIBLE FOR THE SUCCESSFUL OPERATION OF ANY SYSTEM PERMITTEE RESPONSIBLE FOR OBTAINING FINAL APPROVAL ON THIS PERMIT CALL 410-313-1771 FOR INSPECTION OF SEPTIC SYSTEM

NOT TO SCALE

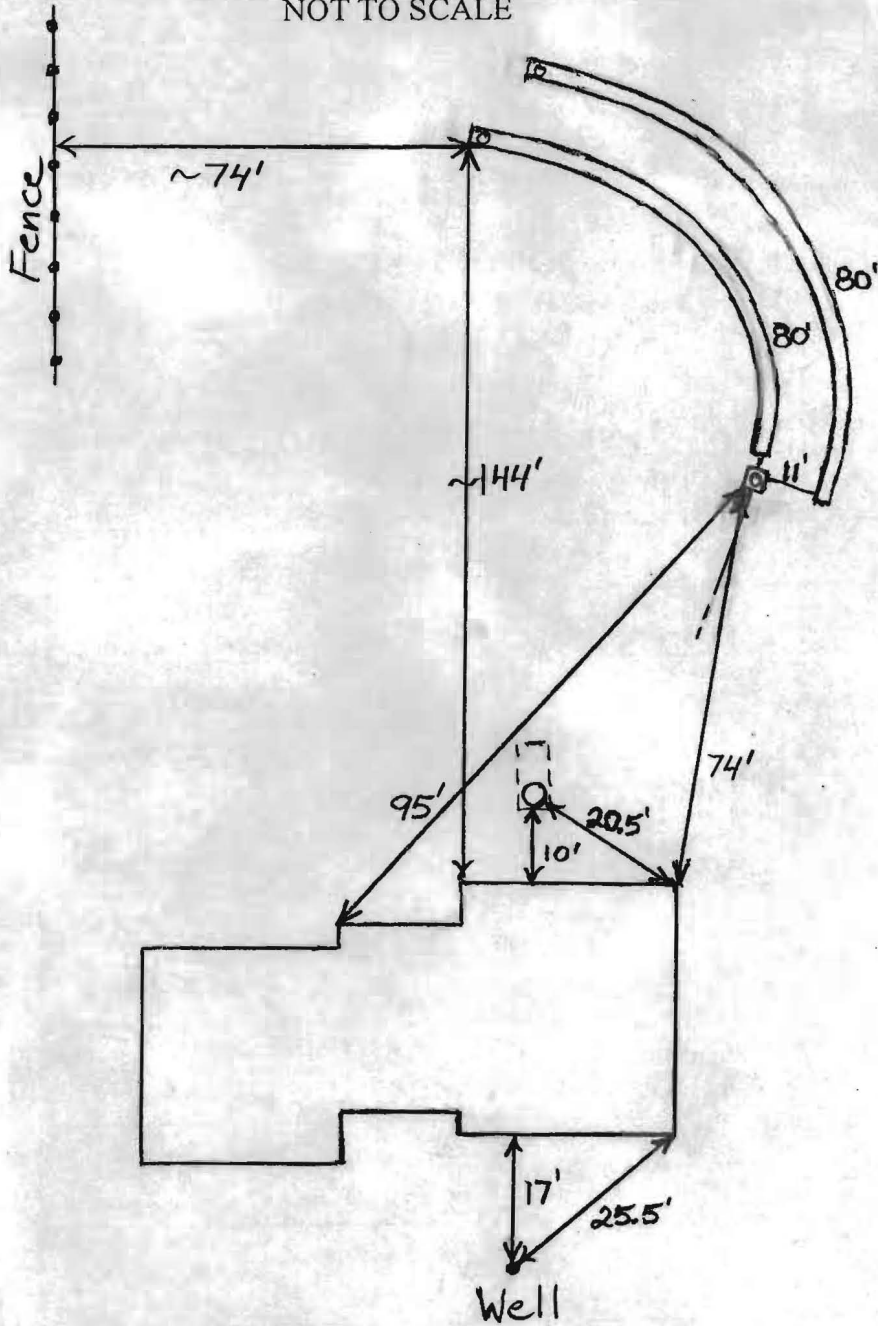

TRENCH/DRAINFIELD DATA

WIDTH	INLET	BOTTOM
3'	4'	7'
NUMBER OF TRENCHES		2
TOTAL LENGTH		160'
ABSORPTION AREA		480+ Sidewall
DISTRIBUTION BOX LEVEL		Levelers
DISTRIBUTION BOX BAFFLE		Yes
DISTRIBUTION BOX PORT		Yes

SEPTIC TANK DATA

SEPTIC TANK 1 LEVEL	Yes
MANUFACTURER	?
CAPACITY	? GAL
SEAM LOC	Midseam
TANK LID DEPTH	3'-3.5'
BAFFLES	Yes
BAFFLE FILTER	No
MANHOLE LOC	Front
6" PORT LOC	None
WATERTIGHT TEST	No
SLOTTED	No

PUMP/SEPTIC TANK LEVEL N/A

MANUFACTURER	
CAPACITY	GAL
SEAM LOC	
TANK LID DEPTH	
BAFFLES	
BAFFLE FILTER	
MANHOLE LOC	
6" PORT LOC	
WATERTIGHT TEST	
SLOTTED	

PRE-CONSTRUCTION


2/15/2012 Laid out trenches, Pumpout and fill in drywell. (BB)

INSTALLATION: 2/16/2012 System finished, O.K. to backfill. (BB)

FINAL INSPECTOR B. Baber

DATE OF APPROVAL 2/16/2012

12341 Pans Spring Court
Ellicott City Md.

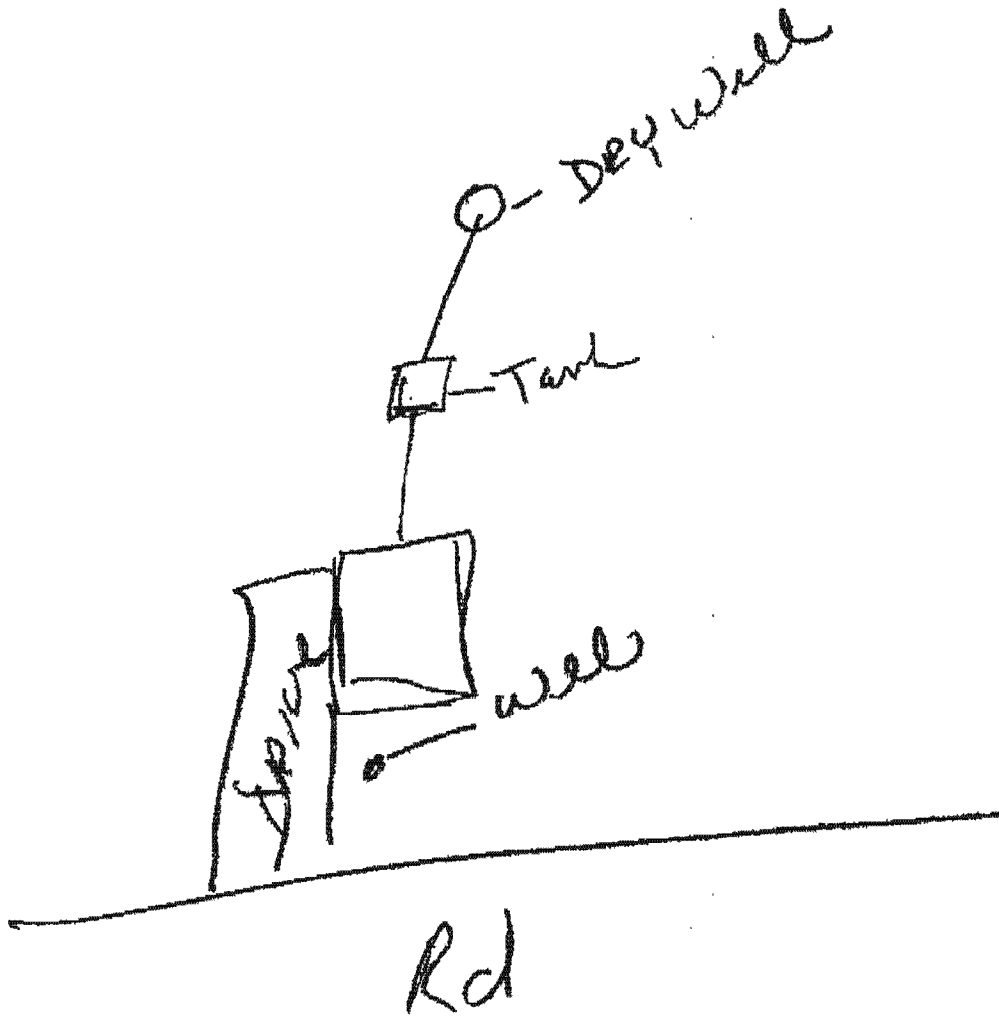

Attn: Heidi
fax 410 313 2648