

PUB. SEWER STATUS VERIFIED BY _____

ISSUE DATE: _____

PERMIT

P _____

APPROVAL DATE: _____

A UPGRADE

ON-SITE SEWAGE DISPOSAL SYSTEM HOWARD COUNTY HEALTH DEPARTMENT BUREAU OF ENVIRONMENTAL HEALTH

Fyock Septic Service IS PERMITTED TO INSTALL ALTER

ADDRESS: PO Box 89, Glenelg 21737 PHONE NUMBER: 410-988-9270

SUBDIVISION: Daisy Hill Estates LOT NUMBER: 24

ADDRESS: 15936 Meadow Walk Rd PROPERTY OWNER: Teresa Herring

SEPTIC TANK CAPACITY (GALLONS): _____

PUMP CHAMBER CAPACITY (GALLONS): _____

NUMBER OF BEDROOMS: _____

SQUARE FEET PER BEDROOM: _____

LINEAR FEET OF TRENCH REQUIRED: _____

TRENCHES:	Trench to be _____ feet wide. Inlet _____ feet below original grade. Bottom maximum depth _____ feet below original grade. Effective area begins at _____ feet below original grade. _____ feet of stone below distribution pipe.
LOCATION:	
PURPOSE:	In support of building permit. Call for inspection when ground is opened so sanitarian can recommend repair.

PLANS APPROVED: _____ DATE: _____

- NOTE: PERMIT VOID AFTER 2 YEARS
- NOTE: CONTRACTOR RESPONSIBLE FOR SCHEDULING A PRE-CONSTRUCTION INSPECTION FOR ALL INSTALLATIONS
- NOTE: WATERTIGHT SEPTIC TANKS REQUIRED
- NOTE: ALL PARTS OF SEPTIC SYSTEM SHALL BE 100 FEET FROM ANY WATER WELL
- NOTE: MANHOLE RISERS REQUIRED ON ALL SEPTIC TANKS AND PUMP CHAMBERS

NEITHER THE HOWARD COUNTY COUNCIL OR THE HEALTH DEPARTMENT IS RESPONSIBLE FOR THE SUCCESSFUL OPERATION OF ANY SYSTEM PERMITTEE RESPONSIBLE FOR OBTAINING FINAL APPROVAL ON THIS PERMIT CALL 410-313-2640 FOR INSPECTION OF SEPTIC SYSTEM

NOT TO SCALE

TRENCH/DRAINFIELD DATA

WIDTH _____ INLET _____ BOTTOM _____

NUMBER OF TRENCHES _____

TOTAL LENGTH _____

ABSORPTION AREA _____

DISTRIBUTION BOX LEVEL _____

DISTRIBUTION BOX BAFFLE _____

DISTRIBUTION BOX PORT _____

SEPTIC TANK DATA

SEPTIC TANK 1 LEVEL _____

CAPACITY _____ GAL

SEAM LOC _____

TANK LID DEPTH _____

BAFFLES _____

BAFFLE FILTER _____

MANHOLE LOC _____

6" PORT LOC _____

WATERTIGHT TEST _____

SEPTIC TANK 2 LEVEL _____

CAPACITY _____ GAL

SEAM LOC _____

TANK LID DEPTH _____

BAFFLES _____

BAFFLE FILTER _____

MANHOLE LOC _____

6" PORT LOC _____


WATERTIGHT TEST _____

ROAD

PRE-CONSTRUCTION _____

INSTALLATION _____

FINAL INSPECTOR _____ DATE OF APPROVAL _____

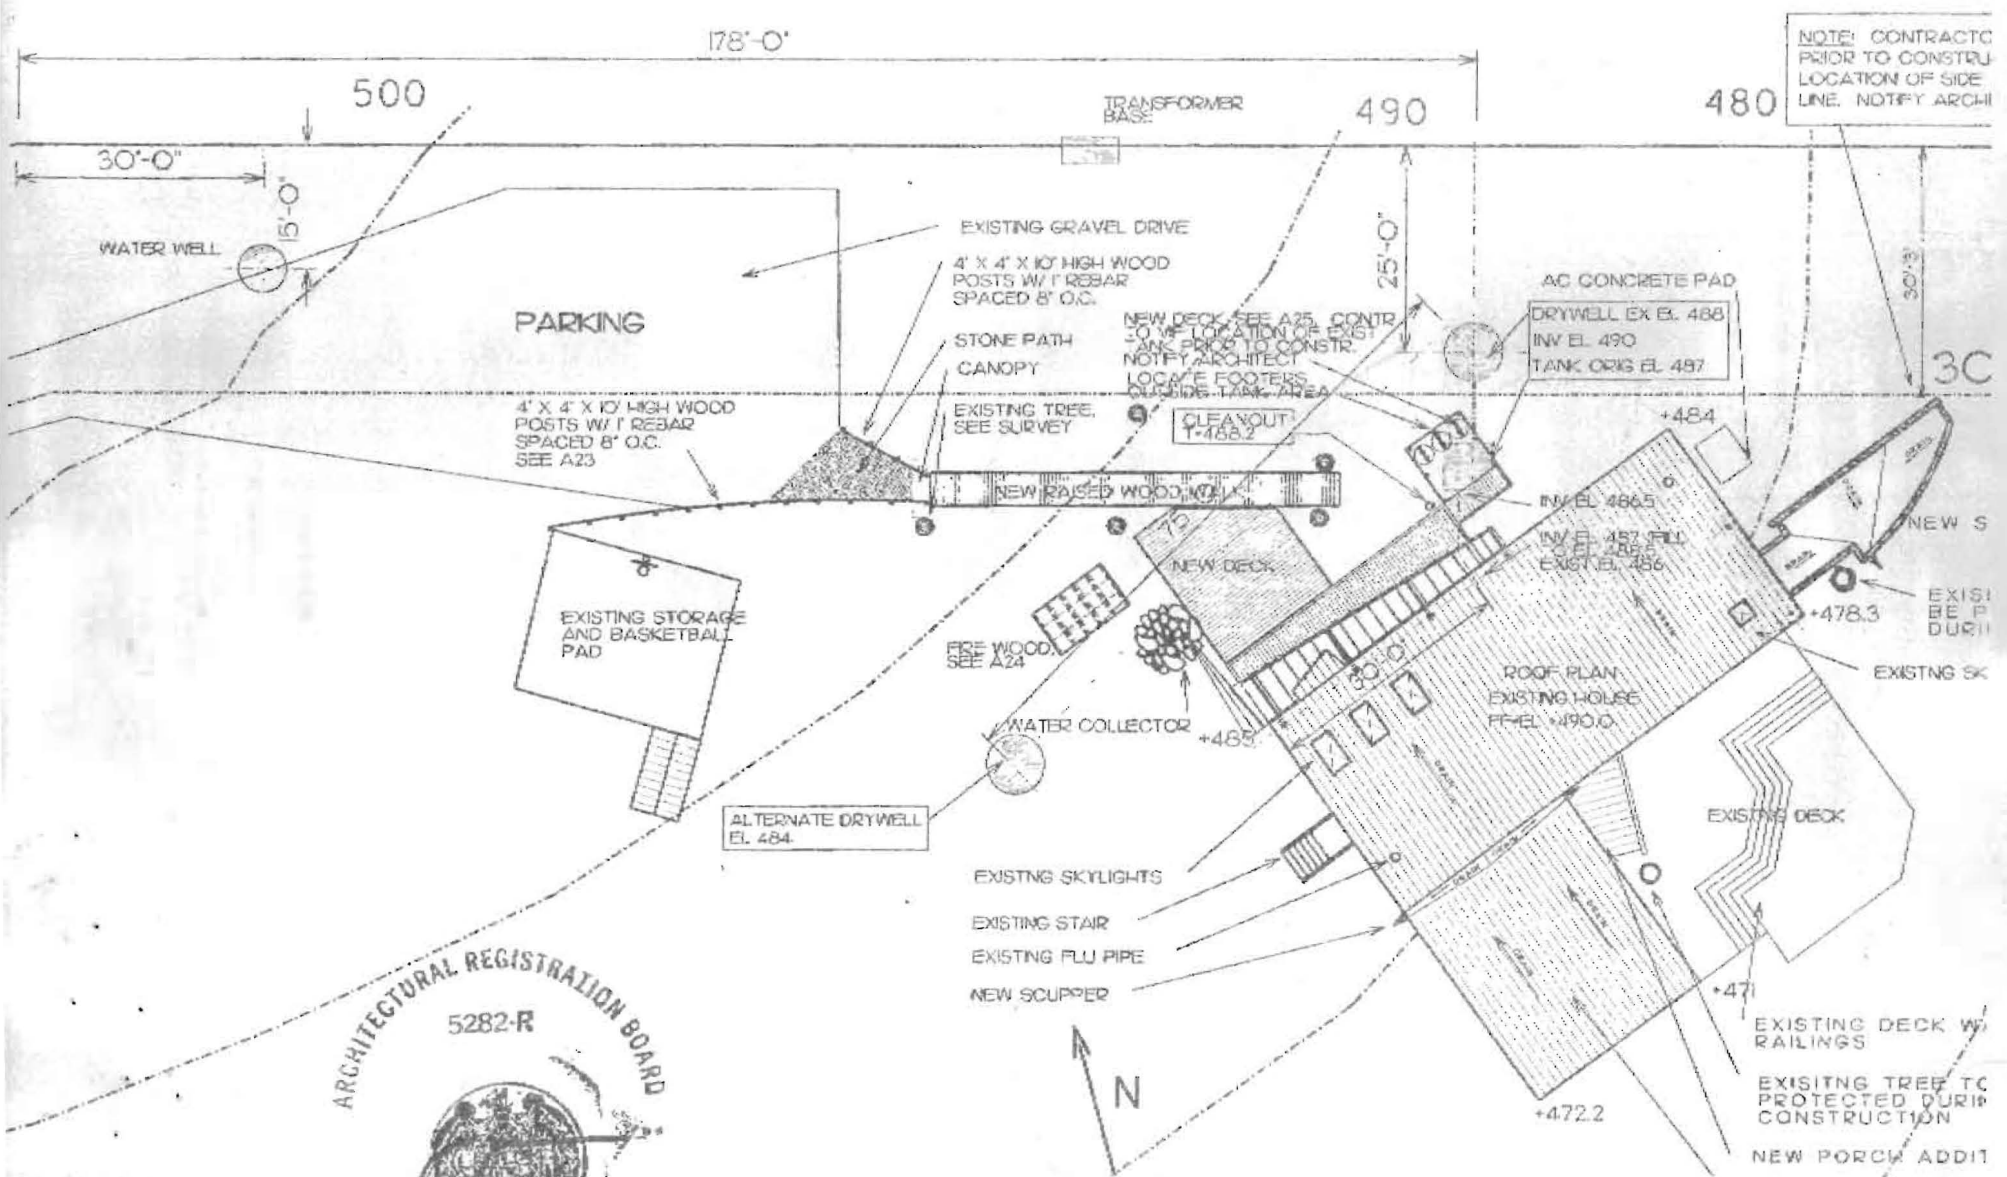

178'-0"



TRANSFORMER BASE

490

EXISTING GRAVEL DRIVE

4' X 4' X 10' HIGH WOOD POSTS W/ 1" REBAR SPACED 8" O.C.

STONE PATH CANOPY

EXISTING TREE, SEE SURVEY

NEW DECK, SEE A25. CONTR TO VIF LOCATION OF EXIST TANK PRIOR TO CONSTR. NOTIFY ARCHITECT LOCATE FOOTERS OUTSIDE TANK AREA

CLEANOUT T=488.2

AC CONCRETE PAD

DRYWELL EX EL 488
INV EL 490
TANK ORIG EL 487

NEW RAISED WOOD WALK

NEW DECK

INV EL 486.5

INV EL 487 (FILL TO EL 488.5)
EXIST EL 486

FIRE WOOD, SEE A24

WATER COLLECTOR

+485

ROOF PLAN EXISTING HOUSE
FF-EL +490.0

ALTERNATE DRYWELL EL 484



SECTION MON 8:10

P.04

9/16/96
 SITE INSPECTION, WELL LOCATED,
 SEPTIC NOT LOCATED, PETSITTER
 AT HOUSE INDICATED THAT OWNERS ARE
 OUT OF TOWN UNTIL 9/23/96.

OVERALL SITEPLAN

HO 13 1214

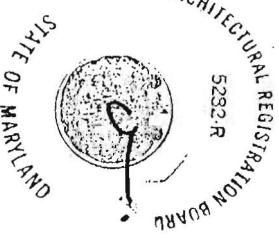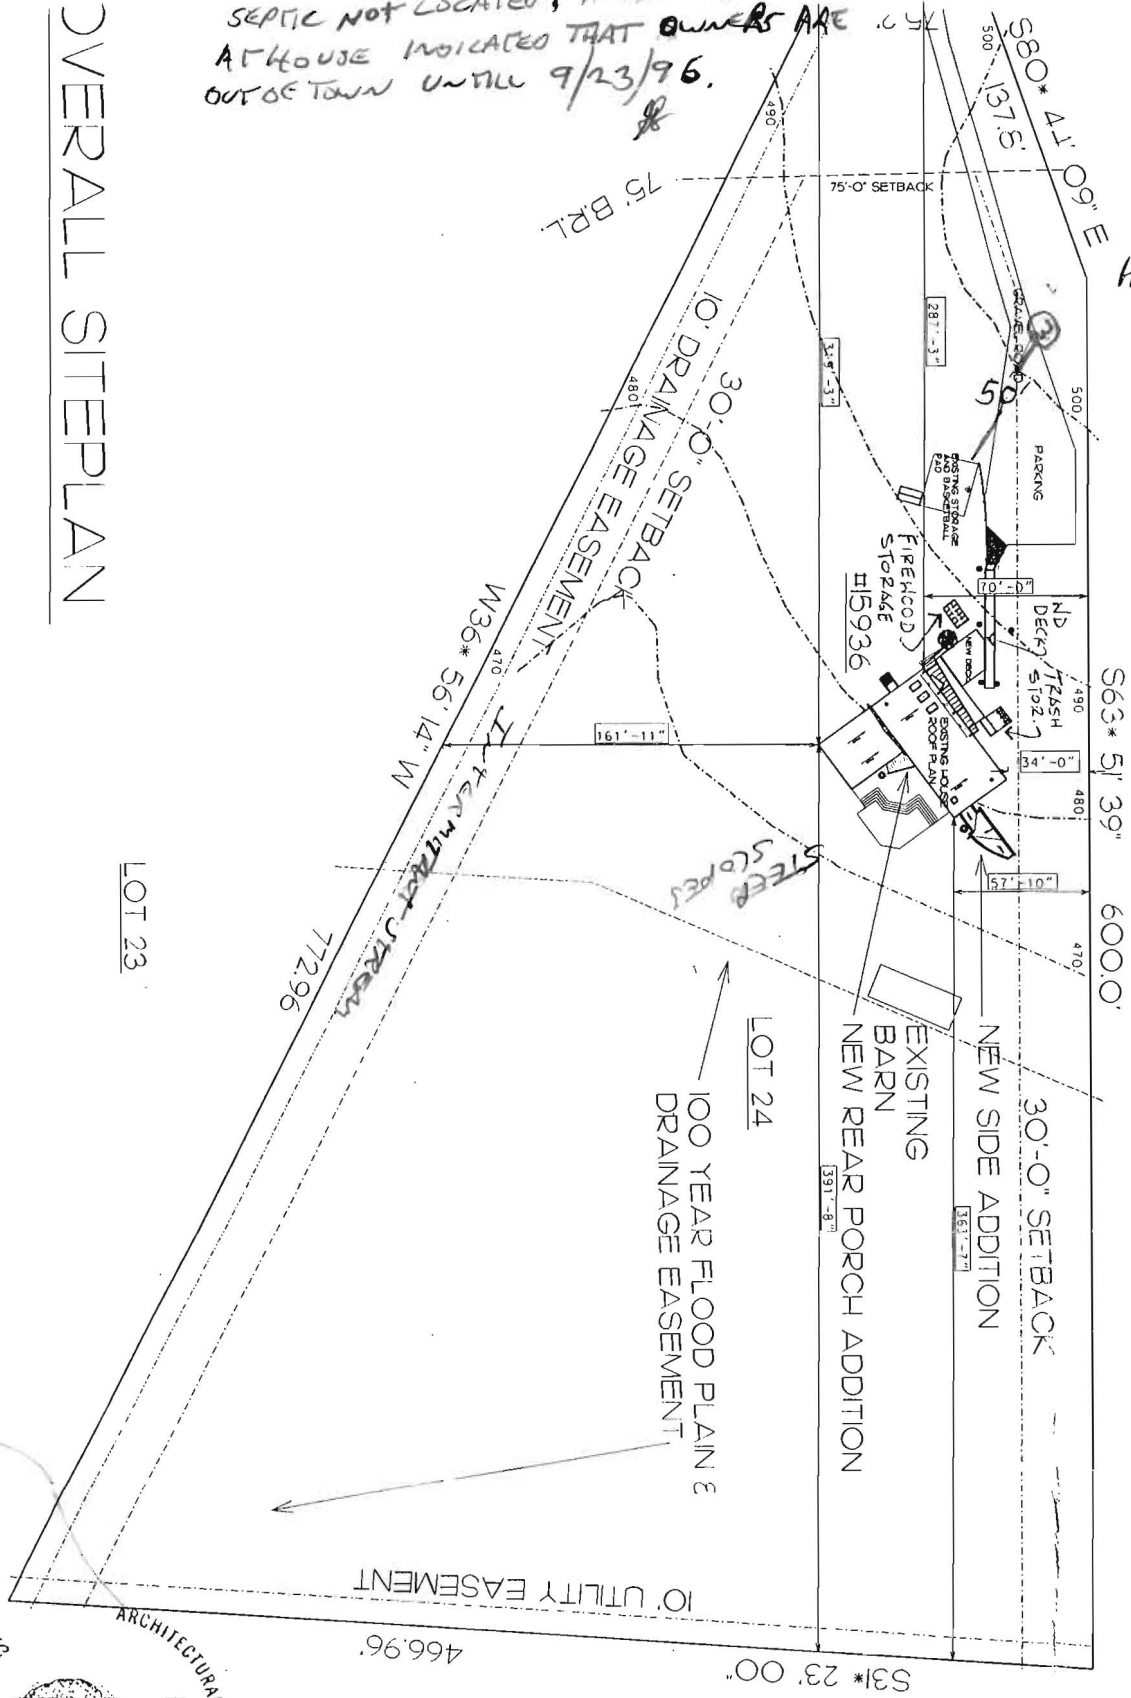

S
 DRAWING NUMBER

1/64" = 1' - 0"
 9/5/96
 SCALE

NO.	DATE	REVISIONS

SITE PLAN

HERRING RENOVATION/
 ADDITION

TRAVIS PRICE
 architect
 7850 Carroll Avenue, Tanona Park, Maryland 20712 | 301-278-9222 | Fax 3