


LANDTECH ASSOCIATES, INC.

1410 CRAIN HIGHWAY, N.W. SUITE 7B GLEN BURNIE, MD 21061
 410.598.2121 FAX 410.553.9081

NOTE: NOT TO BE USED FOR THE ISSUANCE OF PERMITS.

B/3003169
 barn OK
 8/26/13 HS

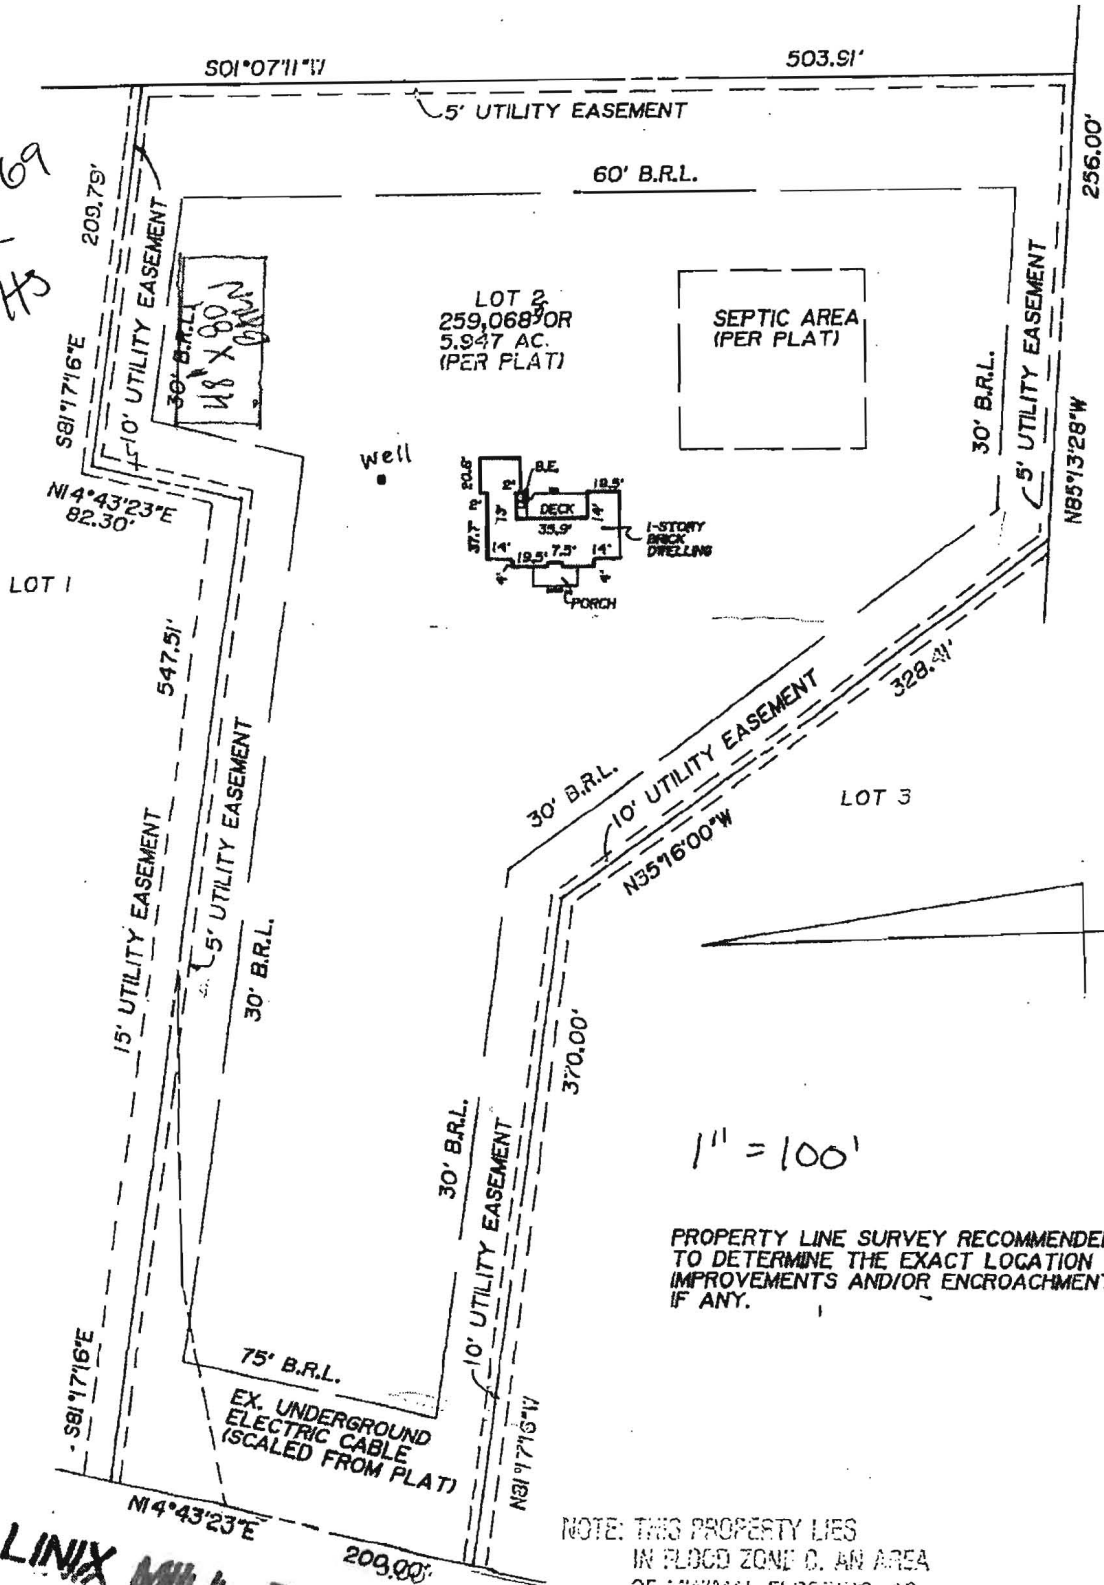

MULLINIX MILL ROAD

1" = 100'

PROPERTY LINE SURVEY RECOMMENDED TO DETERMINE THE EXACT LOCATION OF IMPROVEMENTS AND/OR ENCROACHMENTS, IF ANY.

NOTE: THIS PROPERTY LIES IN FLOOD ZONE D, AN AREA OF MINIMAL FLOODING, AS DELINEATED ON THE MAPS OF THE NATIONAL FLOOD INSURANCE PROGRAM.

