



Howard County
Health Department


Bureau of Environmental Health
7178 Columbia Gateway Drive, Columbia, MD 21046
(410) 313-2640 Fax (410) 313-2648
TDD (410) 313-2323 Toll Free 1-866-313-6300
website: www.hchealth.org

Peter L. Beilenson, M.D., M.P.H., Health Officer

May 27, 2009

MEMORANDUM

TO: Travis White
7245 Cedar Ave.
Jessup, Maryland 20794

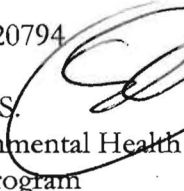FROM: Stuart F. Oster, R.S. 
Bureau of Environmental Health
Well and Septic Program

RE: 7245 Cedar Ave.
The Cedar Ext.
Map 43, Grid 8, Parcel 138
(Demolition of Existing House)

This is to advise that the Howard County Health Department recommends issuance of the demolition permit for the above referenced property.

The contractor indicates this house has been damaged by a fire. Although the house is currently connected to public water and sewer, a hand dug well still remained. This well was properly abandoned and documented on May 27, 2009.

If any other wells or septic systems are found during site work, please notify this office immediately.

C: Paul Nalley, RES Builders, Faxed to 410-242-4457
File

Stuart Oster


From: resbuilders@aol.com
Sent: Thursday, May 21, 2009 11:12 AM
To: Stuart Oster
Subject: demolition 7245 Cedar Avenue

Per our conversation I would like to request an approval notification for the demolition of a single family house located at 7245 Cedar Avenue, Jessup, MD 21075, Property owner: Travis L White.

Please send notice by email: resbuilders@aol.com or by fax: 410-242-4457. ATT: Paul Nalley

If you have any questions, please contact me, Paul Nalley, at 443-286-0255

Huge savings on HDTVs from Dell.com!

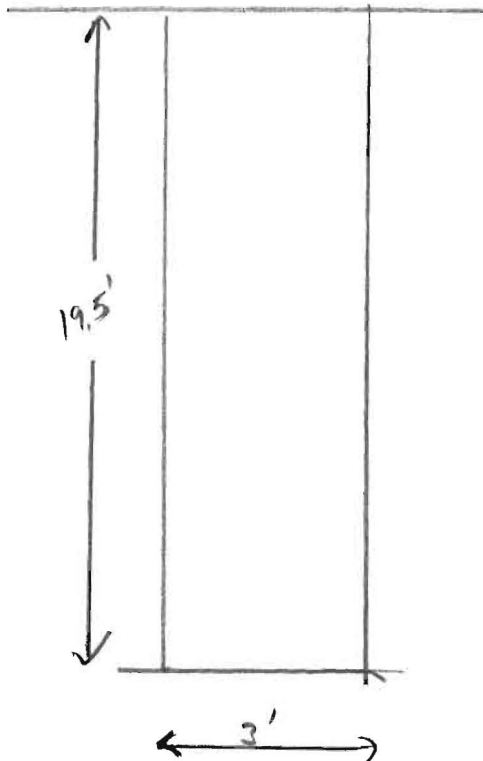

Fax 410 242 4457

$$\pi r^2 h$$

$$(3.1415)(3'^2)(19.5') = \underline{550 \text{ ft}^3} \div 27 = \underline{20 \text{ yd}^3}$$

$$20 \cdot 1.5 = \underline{30 \text{ tons steel}}$$