

DEPARTMENT OF INSPECTIONS,
 LICENSES & PERMITS
 342A COURT HOUSE DRIVE
 ELLICOTT CITY, MD 21043
 PERMITS (410) 313-2455
 INSPECTIONS (410) 313-1850

**HOWARD COUNTY
 RESIDENTIAL
 HEATING-VENTILATION-AIR
 CONDITIONING AND
 REFRIGERATION PERMIT
 APPLICATION**

HVACR PERMIT # M11000312
 BUILDING PERMIT #

BUILDING ADDRESS: 13388 Hunt Ridge Rd
Ellicott City MD 21042
 SUITE/APT:
 SUBDIVISION:
 CENSUS TRACT: SECTION: AREA:
 LOT: TAX MAP: PARCEL:
 BLOCK: ZONE:

OWNERS NAME: Anne Ryals
 ADDRESS: 13422 Crane Canyon Loop
 CITY: Colorado Springs
 STATE: Co ZIP CODE: 80921
 HOME PHONE: 443-535-8878 WORK PHONE:

PROPERTY ID: MAP COORDINATES:
 TYPE OF IMPROVEMENTS: USE:

	<u>CHECK ONE</u>	<u>HOW MANY</u>	
SINGLE FAMILY DWELLING	<input checked="" type="checkbox"/>	<u>1</u>	ZONES
SINGLE FAMILY TOWNHOUSE	<input type="checkbox"/>	___	ZONES
MULTI-FAMILY / HOTEL/MOTEL	<input type="checkbox"/>	___	ROOMS
ASSISTED LIVING HOMES (16 OR FEWER RESIDENTS)	<input type="checkbox"/>	___	ROOMS

COMPANY NAME: Supreme Air LLC
 LICENSEE NAME: Alexandros Kougiannos
 ADDRESS: 6203 Hopkinsway Rd
 CITY: Baltimore 4/7/2011
 STATE: MD ZIP CODE: 21228 O.K.
 PHONE: 410-788-1114 HVACR LICENSE NO: BB
47207

New

- Heating and Air Conditioning
- Geo Thermal System
- Heating System Only
- Ductless Mini Splits
- Other Work (Describe):
- Thru The Wall Systems

Replacement

- Heating
- Air Conditioning
- Heating and Air Conditioning

Additions and Alterations

- Heating
- Air Conditioning
- Heating and Air Conditioning

****Replacement Geo Thermal Systems are not required; However, if a tax credit is being sought a permit is required****

Zones
 Permit Fee = # of Zones x \$40 = 40
 Technology Fee (10% of Permit Fee) = 4
 Plus Application Fee \$50.00
 Total Fees Due = 94.00

Rooms
 Permit Fee = # of Rooms x \$80 = _____
 Technology Fee (10% of Permit Fee) = _____
 Plus Application Fee \$50 \$50.00
 Total Fees Due = _____

I HAVE CAREFULLY EXAMINED AND READ THIS APPLICATION AND KNOW IT IS TRUE AND CORRECT. THE WORK DESCRIBED HEREIN WILL BE PERFORMED BY A STATE HVACR LICENSED PERSON(S), AND ALL WORK WILL BE PERFORMED IN COMPLIANCE WITH APPLICABLE CODES AND STANDARDS OF HOWARD COUNTY THE STATE OF MARYLAND.

Alexandros Kougiannos 3-29-11
 SIGNATURE OF LICENSEE DATE

Alexandros Kougiannos
 PRINT NAME OF LICENSEE

Alex @ Supreme Air LLC.com
 Email Address


Make check payable to: DIRECTOR OF FINANCE OF HOWARD COUNTY

Word doc: T:\Updated Forms\hvac application
 Rev:10.2009

Validation
 Check Number: 3218
 Cash: _____
 Receipt Number: 236640

well + Septic

M11000312

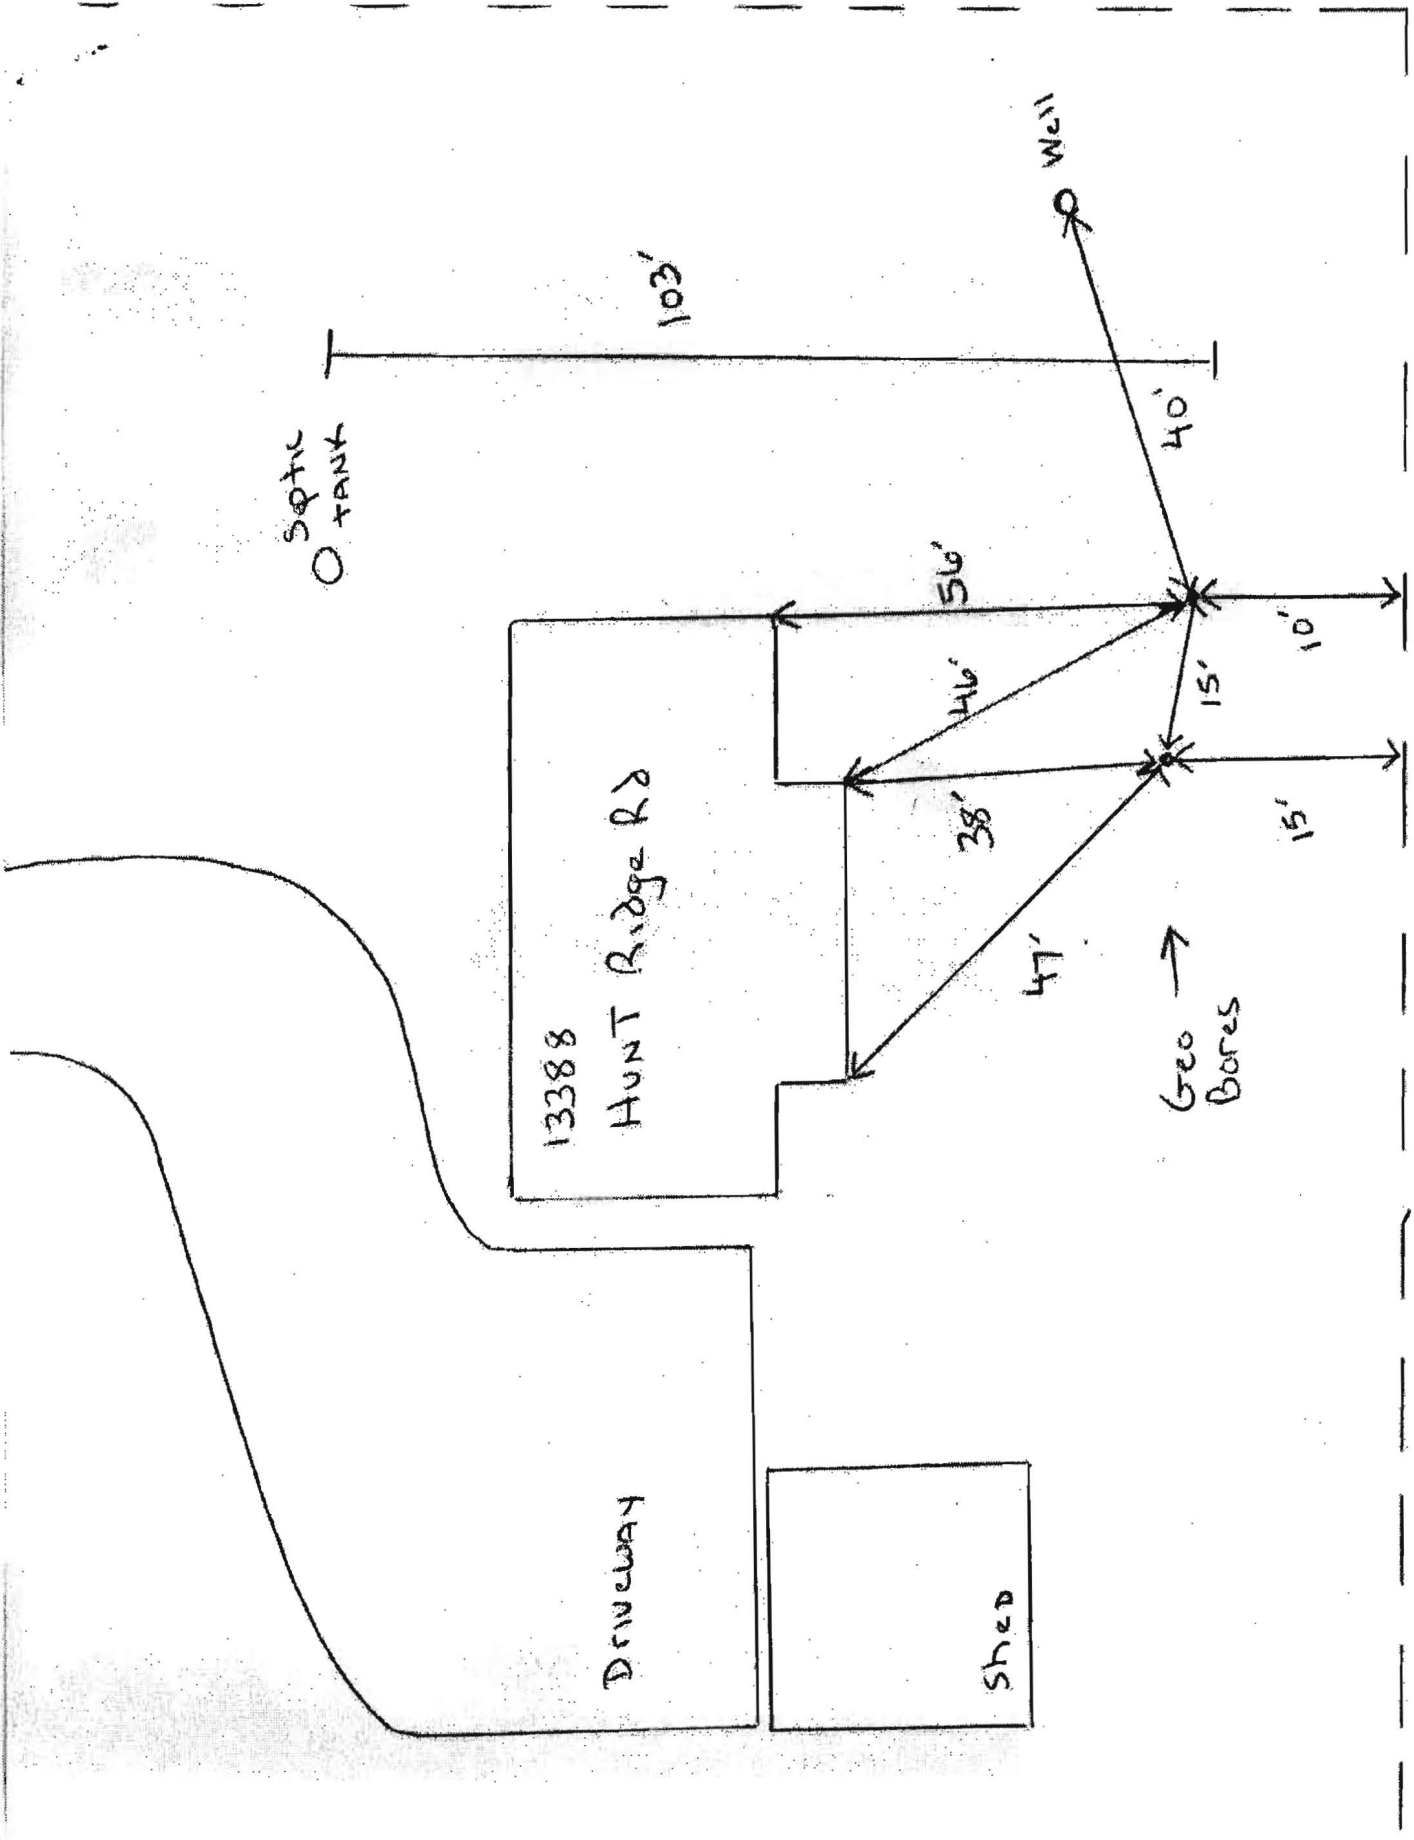

SEPTIC TANK

WELL

13388 HUNT RIDGE RD

DRIVEWAY

SHED

Geo BORES

PROP LINE (FENCE)