

APPLICATION

A 10955

P _____

SEWAGE DISPOSAL TESTING

MARYLAND STATE DEPARTMENT OF HEALTH

HOWARD COUNTY

ELLICOTT CITY

Septic Tank - 750 gallons.

DISTRICT 5

DATE 9/24/65

Dry well - 300 sq. ft. sidewall absorbent area below the inlet pipe located 18 ft from left side property line and 18 ft from right rear corner of large shed as seen when facing lot from Rte 108

TO: THE COUNTY HEALTH OFFICER
ELLICOTT CITY, MARYLAND

I, HEREBY, APPLY FOR THE NECESSARY TESTS IN ORDER TO CONSTRUCT (OR RECONSTRUCT) A SEWAGE DISPOSAL SYSTEM.

PROPERTY OWNER Sylvester Fowler

ADDRESS Highland, Maryland PHONE At 6-2458 (2458)

PROPERTY LOCATION:

SUBDIVISION _____ LOT NO. _____

ROAD AND DESCRIPTION Rt. 108, Highland - fourth house on left from Highland P.O. going north; white shingle

OCCUPANT _____ PHONE _____

PERSON TO CONSTRUCT SYSTEM _____

ADDRESS _____ PHONE _____

SIZE OF LOT 4.5 acres TYPE BLDG. 2
NUMBER OF BEDROOMS

IF NOT SINGLE RESIDENCE DESCRIBE _____

SIGNATURE OF APPLICANT *Sylvester Fowler*


APPROVED BY *J. H. Kalm...* FOR *Dry well* DATE *10/7/65*
(KIND OF SYSTEM)

REJECTED BY _____ FOR _____ DATE _____
(KIND OF SYSTEM)

HOLD PENDING FURTHER TESTS _____ DATE _____

REASONS FOR REJECTION OR HOLDING _____

THIS IS NOT A PERMIT

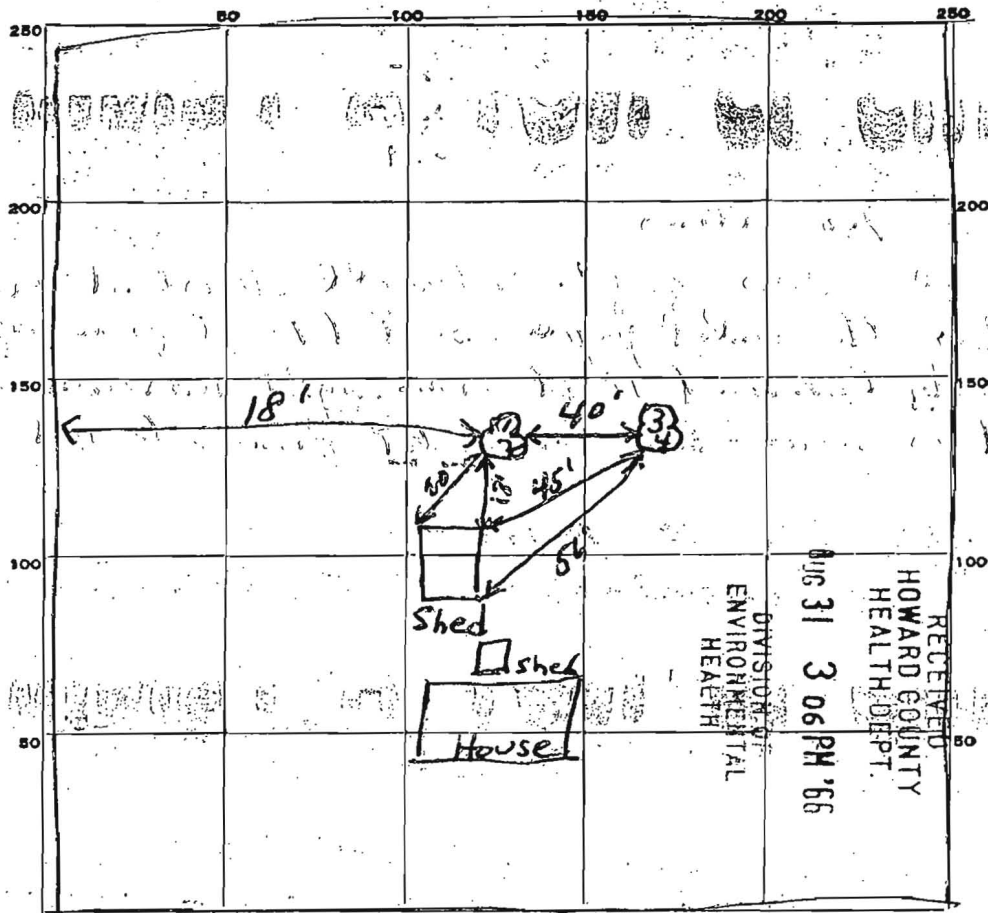

INDICATE NORTH. - NAME ADJOINING ROADWAY AS BASE LINE.

To Rte 216

Rte 108

DATE	TEST NO.	DEPTH	PRE-WET		TEST - 1" DROP		TIME
			START	STOP	START	STOP	
10/7/65	1	9'	10:10	10:12	10:12	10:16	4 min
↓	2	4'	10:10	10:13	10:13	10:18	5 min
↓	3	9'	10:17	10:19	10:19	10:22	3 min
↓	4	4'	10:12	10:14	10:14	10:17	3 min

SOIL AUGER FINDING all good loamy soil

TESTED BY JHK

REMARKS do to. L. L. L. L. L.

APPLICATION

A 10955

SEWAGE DISPOSAL TESTING

P _____

MARYLAND STATE DEPARTMENT OF HEALTH

HOWARD COUNTY

ELLICOTT CITY

DISTRICT 5

DATE 9/24/65

Septic Tank - 750 gallons.

Dry well - 300 sq. ft. sidewall absorbent area below the inlet pipe located 18 ft from left side property line and 18 ft from right rear corner of large shed as seen when facing lot from Rte 108

TO: THE COUNTY HEALTH OFFICER
ELLICOTT CITY, MARYLAND

I, HEREBY, APPLY FOR THE NECESSARY TESTS IN ORDER TO CONSTRUCT (OR RECONSTRUCT) A SEWAGE DISPOSAL SYSTEM.

PROPERTY OWNER Sylvester Fowler

ADDRESS Highland, Maryland PHONE At 6-2458 (2458)

PROPERTY LOCATION:

SUBDIVISION _____ LOT NO. _____

ROAD AND DESCRIPTION Rt. 108, Highland - fourth house on left from Highland P.O. going north; white shingle

OCCUPANT _____ PHONE _____

PERSON TO CONSTRUCT SYSTEM _____

ADDRESS _____ PHONE _____

SIZE OF LOT 4.5 acres TYPE BLDG. 2 NUMBER OF BEDROOMS _____

IF NOT SINGLE RESIDENCE DESCRIBE _____

SIGNATURE OF APPLICANT Sylvester Fowler


✓ APPROVED BY J. H. Kalmoe FOR Dry well DATE 10/7/65
(KIND OF SYSTEM)

REJECTED BY _____ FOR _____ DATE _____
(KIND OF SYSTEM)

HOLD PENDING FURTHER TESTS _____ DATE _____

REASONS FOR REJECTION OR HOLDING _____

THIS IS NOT A PERMIT

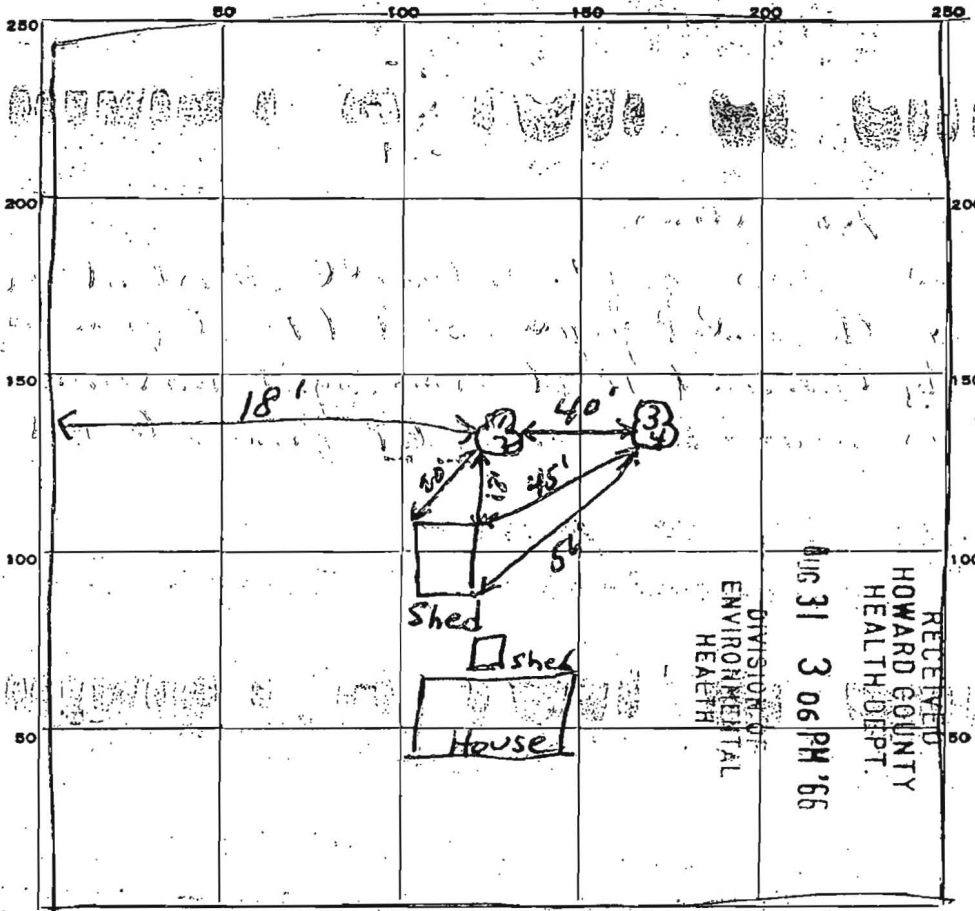

To Rte 216

Rte 108

DATE	TEST NO.	DEPTH	PRE-WET		TEST - 1" DROP		TIME
			START	STOP	START	STOP	
10/7/65	1	9'	10:10	10:12	10:12	10:16	4 min
↓	2	4'	10:10	10:13	10:13	10:18	5 min
↓	3	9'	10:17	10:19	10:19	10:22	3 min
↓	4	4'	10:12	10:14	10:14	10:17	3 min

SOIL AUGER FINDING all good loamy soil

TESTED BY JHK

REMARKS to be used