

PERMIT

SEWAGE DISPOSAL SYSTEM

DEPARTMENT OF HEALTH AND MENTAL HYGIENE

INDEX - TIME EXPIRED FOR F.C.O.P

P 47666

A REPAIR

DISTRICT _____

DATE 12/4/91

HOWARD COUNTY HEALTH DEPARTMENT
BUREAU OF ENVIRONMENTAL HEALTH
461-9933

COMPLIANCE

DATE SYSTEM APPROVED 12/10/91

INDEXED 9/8/93 C. Williams INSPECTOR RH

C. C. Cissel IS PERMITTED TO INSTALL _____ ALTER X

ADDRESS 14079 Birghton Dam Road, Clarksville, Maryland PHONE 854-2006

SUBDIVISION _____ LOT _____ ROAD 13212 Clarksville Pike

PROPERTY OWNER Mary Fowler

ADDRESS 13212 Clarksville Pike
Highland, Maryland 20777

SEPTIC TANK CAPACITY _____ GALLONS

NUMBER OF BEDROOMS _____

_____ SQUARE FEET PER BEDROOM

LINEAR FEET OF TRENCH REQUIRED _____

REPAIR - TO CONFIRM CONDITION OF EXISTING SEPTIC AND IF NEED BE, EXPAND THE EXISITNG SEPTIC SYSTEM TO SUPPORT THE PROPOSED ADDITION.
(Anticipate building permit application)

Call for inspection when ground is opened so sanitarian can recommend repair.

System covered without inspection & uncovered today for inspection.

PLANS APPROVED BY C. Williams DATE 12/09/91

COVER NO WORK UNTIL INSPECTED AND APPROVED

NEITHER THE HOWARD COUNTY COUNCIL NOR THE HEALTH DEPARTMENT IS RESPONSIBLE FOR THE SUCCESSFUL OPERATION OF ANY SYSTEM

NOTE: CLEANOUT REQUIRED EVERY 70 FEET OF SEWER LINE AND/OR AT 90° SWEEPS IN LINES FROM HOUSE TO DRAIN FIELDS, 90° ELBOWS NOT ACCEPTABLE.

NOTE: ALL PARTS OF SEPTIC SYSTEMS (I.E. TANK, DISTRIBUTION BOX TRENCHES) TO BE 100 FEET FROM WELL (UNLESS OTHERWISE SPECIFICALLY AUTHORIZED)

NOTE: IF DEEP TRENCH(ES) ARE USED CALL FOR INSPECTION BEFORE AND AFTER PLACING GRAVEL IN TRENCH(ES)

NOTE: NO DRY WELL SHALL EXCEED 15 FOOT IN DIAMETER NO ABSORPTION TRENCH TO EXCEED 100 FEET IN LENGTH

NOTE: ALL PIPE FROM HOUSE TO SEPTIC TANK MUST BE CAST IRON OR SCHEDULE 35/40 PVC OR ABS


PERMIT VOID AFTER TWO YEARS

NOTE: INSTALL STAND PIPE ON SEPTIC TANK AND DRY WELL STAND PIPES MUST BE 6 INCHES IN DIAMETER CAST IRON, CONCRETE OR TERRA COTTA OR PVA OR ABS ACCEPTED. IF TOP OF SEPTIC TANK IS DEEPER THAN 3 FEET, MANHOLE TO GRADE REQUIRED.

NOTE: DISTRIBUTION BOXES MUST HAVE BAFFLES

INSTALLER IS RESPONSIBLE FOR OBTAINING FINAL APPROVAL ON THIS PERMIT

P 47666

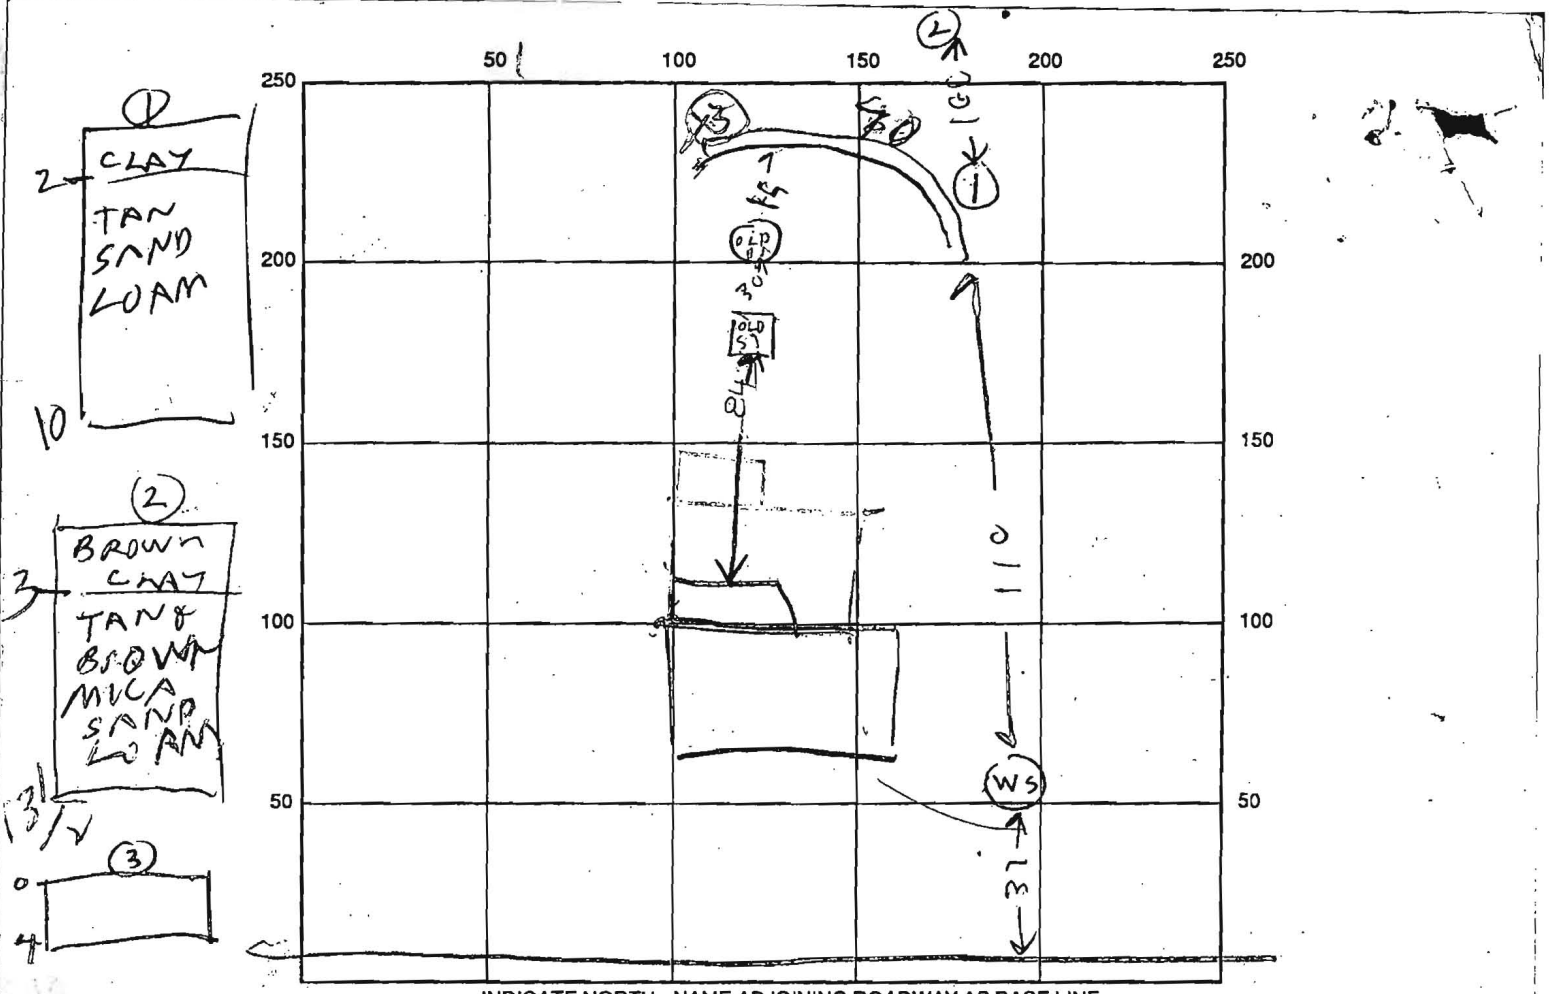

SEPTIC TANK LEVEL 750 or more CLEANOUTS OK
per old permit

DISTRIBUTION BOX LEVEL _____

DRAIN FIELD/TITLE DEPTH 10 FT. TRENCH WIDTH 2 FT. INLET DEPTH 3-4 FT.

EFFECTIVE GRAVEL DEPTH 6 FT. TOTAL LENGTH 70 FT.

NUMBER OF TRENCHES 1 ONE SIDEWALL/BOTTOM AREA 420 SQ. FT.

DRYWALL INSIDE DIAMETER _____ FT. EFFECTIVE DEPTH BELOW INLET _____ FT.

ABSORBENT AREA _____ SQ. FT.

REMARKS: 12/9/91 - End of system dug open at (1) Soil OK
10 FT deep 6 FT STONE. Other end of trench dug to stone
3 ft. Grade top stone. System is adequate for 3 bedrooms
125 x 3 = 375 sq ft but a little short for 4 bedrooms
125 x 4 = 500 sq ft. Tank capacity low but some sewer
settlement in old dry well. Not sure if it is a steel
or concrete tank R.H.

DATE SYSTEM APPROVED 12/9/91 INSPECTOR Raymond Hodges

PERMIT

SEWAGE DISPOSAL SYSTEM

DEPARTMENT OF HEALTH AND MENTAL HYGIENE

INDEX - TIME EXPIRED FOR F.C.O.P

HOWARD COUNTY HEALTH DEPARTMENT
BUREAU OF ENVIRONMENTAL HEALTH
461-9933

COMPLIANCE

P 47666

A REPAIR

DISTRICT _____

DATE 12/6/91

DATE SYSTEM APPROVED 12/10/91

INDEXED 9/8/93 C. Williams INSPECTOR RH
CB

C. C. Cissel IS PERMITTED TO INSTALL _____ ALTER

ADDRESS 14079 Birghton Dam Road, Clarksville, Maryland PHONE 854-2006

SUBDIVISION _____ LOT _____ ROAD 13212 Clarksville Pike

PROPERTY OWNER Mary Fowler

ADDRESS 13212 Clarksville Pike
Highland, Maryland 20777

SEPTIC TANK CAPACITY _____ GALLONS

NUMBER OF BEDROOMS _____

_____ SQUARE FEET PER BEDROOM

LINEAR FEET OF TRENCH REQUIRED _____

REPAIR - TO CONFIRM CONDITION OF EXISTING SEPTIC AND IF NEED BE, EXPAND THE EXISTING SEPTIC SYSTEM TO SUPPORT THE PROPOSED ADDITION.
(Anticipate building permit application)

Call for inspection when ground is opened so sanitarian can recommend repair.

System covered without inspection & uncovered today for inspection.

PLANS APPROVED BY C. Williams DATE 12/09/91

COVER NO WORK UNTIL INSPECTED AND APPROVED

NEITHER THE HOWARD COUNTY COUNCIL NOR THE HEALTH DEPARTMENT IS RESPONSIBLE FOR THE SUCCESSFUL OPERATION OF ANY SYSTEM

NOTE: CLEANOUT REQUIRED EVERY 70 FEET OF SEWER LINE AND/OR AT 90° SWEEPS IN LINES FROM HOUSE TO DRAIN FIELDS, 90° ELBOWS NOT ACCEPTABLE.

NOTE: ALL PARTS OF SEPTIC SYSTEMS (I.E. TANK, DISTRIBUTION BOX TRENCHES) TO BE 100 FEET FROM WELL (UNLESS OTHERWISE SPECIFICALLY AUTHORIZED)

NOTE: IF DEEP TRENCH(ES) ARE USED CALL FOR INSPECTION BEFORE AND AFTER PLACING GRAVEL IN TRENCH(ES)

NOTE: NO DRY WELL SHALL EXCEED 15 FOOT IN DIAMETER NO ABSORPTION TRENCH TO EXCEED 100 FEET IN LENGTH

NOTE: ALL PIPE FROM HOUSE TO SEPTIC TANK MUST BE CAST IRON OR SCHEDULE 35/40 PVC OR ABS


PERMIT VOID AFTER TWO YEARS

NOTE: INSTALL STAND PIPE ON SEPTIC TANK AND DRY WELL STAND PIPES MUST BE 6 INCHES IN DIAMETER CAST IRON. CONCRETE OR TERRA COTTA OR PVA OR ABS ACCEPTED. IF TOP OF SEPTIC TANK IS DEEPER THAN 3 FEET. MANHOLE TO GRADE REQUIRED.

NOTE: DISTRIBUTION BOXES MUST HAVE BAFFLES

INSTALLER IS RESPONSIBLE FOR OBTAINING FINAL APPROVAL ON THIS PERMIT

P 47666

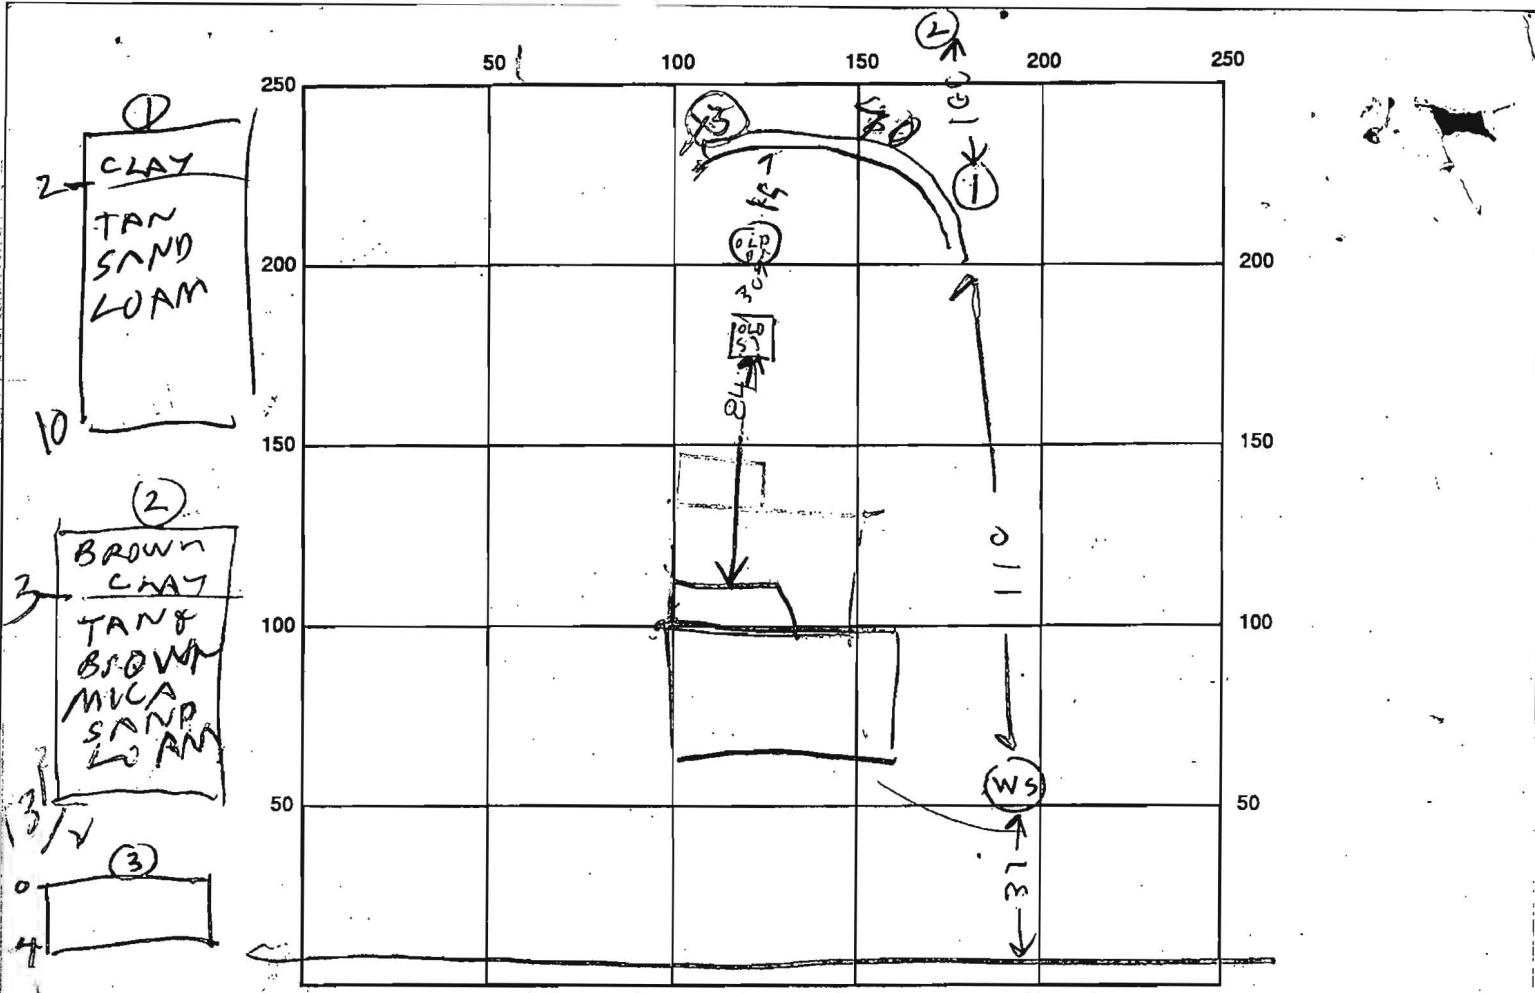

INDICATE NORTH - NAME ADJOINING ROADWAY AS BASE LINE
 ROUTE 108

SEPTIC TANK LEVEL 750 or More CLEANOUTS OK
 DISTRIBUTION BOX LEVEL per old permit
 DRAIN FIELD/TITLE DEPTH 10 FT. TRENCH WIDTH 2 FT. INLET DEPTH 3-4 FT.
 EFFECTIVE GRAVEL DEPTH 6 FT. TOTAL LENGTH 70 FT.
 NUMBER OF TRENCHES 1 ONE SIDEWALL/BOTTOM AREA 420 SQ. FT.
 DRYWALL INSIDE DIAMETER _____ FT. EFFECTIVE DEPTH BELOW INLET _____ FT.
 ABSORBENT AREA _____ SQ. FT.

REMARKS: 12/9/91 - End of system dug open at ① Soil OK
10 FT deep 6 FT STONE. Other end of trench dug to stone
3 ft Grade to stone. System is adequate for 3 bedrooms
125 x 3 = 375 sq ft but a little short for 4 bedrooms
125 x 4 = 500 sq ft. Tank capacity low but some sewer
settlement in old dry well. Not sure abt it or a steel
or concrete tank of R N
 DATE SYSTEM APPROVED 12/9/91 INSPECTOR Raymond Hodges