

HOWARD

Cree

APPROVED

WALK-THRU BUILDING PERMIT

BP# _____ A# 510979

APP. SAN HS DATE: 4-20-11


DESC. OF WORK: 12' x 12' building
820 FEET 100' 00"

E. 10
PROPERTY
FOOD 204

35' BRL

35' BRL

POOL
HOUSE
462 FEET

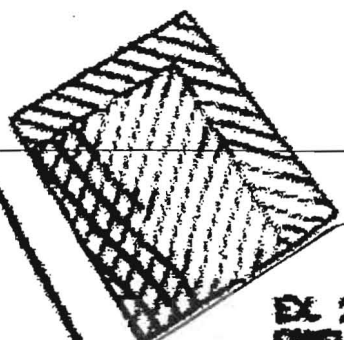

EX. 2-STORY
DWELLING



PAVLEN

670 FEET

EPA

POOL

655 FEET

BARN
SIZE DETAIL

30' BRL

35' BRL

Cattail

781.7

30' BRL



Handwritten notes and stamps in the bottom left corner, including a star symbol and some illegible text.