

Bureau of Environmental Health
 8930 Stanford Blvd. Columbia, MD 21045
 (410) 313-2640 Fax (410) 313-2648
 TDD (410) 313-2323 Toll Free 1-866-313-6300
 website: www.hchealth.org

Maura J. Rossman, M.D., Health Officer

RECEIPT DATE: 1/14/15

ONSITE SEWAGE DISPOSAL SYSTEM

P 555711

INSTALLATION
 APPROVAL

PERMIT

DATE: 2/12/15 SEC

A Repair

REPAIR

PROPERTY ADDRESS: 7413 Cherry Tree Lane

SUBDIVISION: Hopkins Meade

LOT: 39 TAX ID: _____

CONTRACTOR: Fogle's Septic Clean Inc.

EMAIL: kevin@foglesinc.com

CONTRACTOR ADDRESS: 580 Obrecht Road, Sykesville, MD 20701

PHONE: 410-795-5670

PROPERTY OWNER: Thomas Keirzkowski

EMAIL: _____

OWNER ADDRESS: 7413 Cherry Tree Lane

PHONE: 301-875-4397

SEPTIC TANK SIZE (GALLONS): _____

BAT UNIT: _____

STATIC HEAD (FEET): _____

NUMBER OF BEDROOMS: _____ HOUSE SQ. FT. _____

APPLICATION
 RATE: _____

DISTRIBUTION SYSTEM: GRAVITY FED LOW PRESSURE DOSED

TRENCHES:	LINEAR FEET REQUIRED: <u>140'</u>	INLET DEPTH: <u>5'</u>
	TRENCH WIDTH: <u>2'</u>	MAXIMUM BOTTOM DEPTH: <u>11'</u>
	MINIMUM SPACE BETWEEN TRENCHES: <u>8'</u>	EFFECTIVE AREA BEGINNING DEPTH: <u>7'</u>
LOCATION:		
NOTES:		

ISSUED BY: _____ ISSUE DATE: _____ EXPIRATION DATE: _____


*Permit Revised on 8/22/14

- NOTE: CONTRACTOR MUST SCHEDULE A PRE-CONSTRUCTION INSPECTION PRIOR TO BEGINNING ANY INSTALLATION
- NOTE: CONTRACTOR MUST SCHEDULE AN INSPECTION AND GAIN APPROVAL OF ALL COMPONENTS PRIOR TO COVERING
- NOTE: STONE MUST BE APPROVED BY HEALTH DEPARTMENT AND GRAVEL TICKET MUST BE AVAILABLE FOR REVIEW.
- NOTE: WATERTIGHT SEPTIC TANKS REQUIRED
- NOTE: ALL PARTS OF SEPTIC SYSTEM SHALL BE AT LEAST 100 FEET DOWNGRADIENT FROM ANY WATER WELL
- NOTE: MANHOLE RISERS REQUIRED ON ALL SEPTIC TANKS AND PUMP CHAMBERS
- NOTE: AN ELECTRICAL PERMIT IS REQUIRED FOR INSTALLATION OF ANY ELECTRICAL COMPONENTS OF THE SYSTEM

**NEITHER THE HOWARD COUNTY COUNCIL NOR THE HEALTH DEPARTMENT IS RESPONSIBLE FOR THE SUCCESSFUL OPERATION OF ANY SYSTEM.
 PERMITTEE RESPONSIBLE FOR OBTAINING FINAL APPROVAL ON THIS PERMIT.
 CALL 410-313-1771 TO SCHEDULE INSPECTIONS.**

30t

NOT TO SCALE

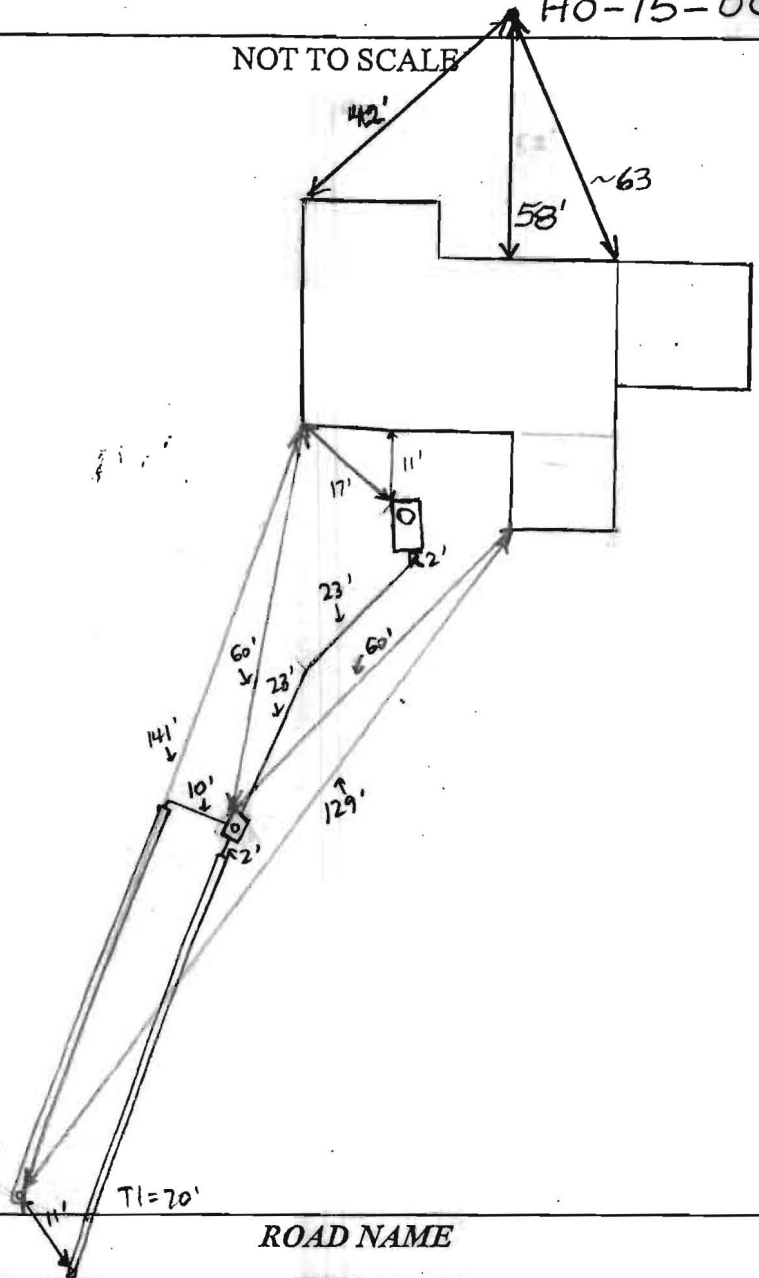

TRENCH/DRAINFIELD DATA		
WIDTH	INLET	BOTTOM
2'	5'	11'
NUMBER OF TRENCHES		2
TOTAL LENGTH		130'
ABSORPTION AREA		276' + SIDEWALL
DISTRIBUTION BOX LEVEL		YES
DISTRIBUTION BOX BAFFLE		YES
DISTRIBUTION BOX PORT		YES

EXISTING TANK:

SEPTIC TANK DATA	
SEPTIC TANK I LEVEL	YES
MANUFACTURER	
CAPACITY	1500 GAL
SEAM LOC	TOP
TANK LID DEPTH	3'
BAFFLES	YES
BAFFLE FILTER	NO
MANHOLE LOC	FRONT
6" PORT LOC	NONE
WATERTIGHT TEST	NO
SLOTTED	NO
DATE ON LID	NONE
PUMP/SEPTIC TANK LEVEL	
MANUFACTURER	
CAPACITY	
SEAM LOC	
TANK LID DEPTH	
BAFFLES	
BAFFLE FILTER	
MANHOLE LOC	
6" PORT LOC	
WATERTIGHT TEST	
SLOTTED	
DATE ON LID	


PRE-CONSTRUCTION: 1/28/2015 General trench locations marked. Contractor didn't bring transit. (BB)

INSTALLATION: 2/10/15 Existing tank uncovered + Fogle's waiting for truck to pump it out. No stone delivery yet - will wait to start trenches until stone arrives. (SC) 2/11/15 D-box installed and connected to existing tank. Manhole riser installed on tank. Fogle's digging T2 at site visit + using laser transit. (SC) 2/11/15 T2 complete and left open on ends 4.5' to stone. 2' wide. Digging T1 at time of site visit. (SC) 2/12/15 T1 complete and left open on ends. Levelled speed levelers on D-box. (SC)

FINAL INSPECTOR Sarah Collins DATE OF APPROVAL 2/12/15



Sketch of System

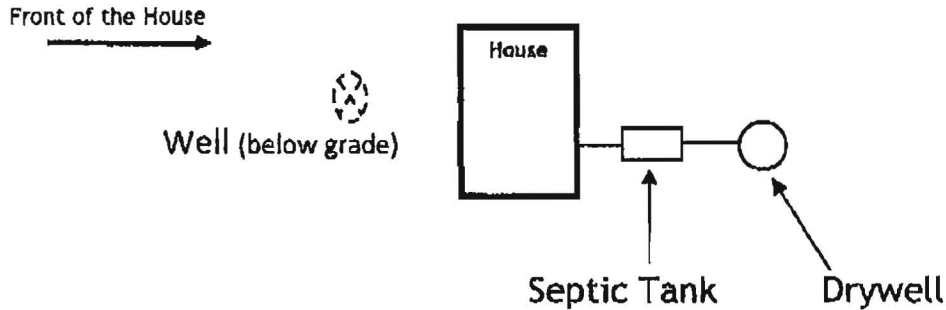

- **This report does not WARRANT nor GUARANTEE** continued functional Sewage Disposal Systems operations.
- If the entire distribution box is not within 12" of grade it is considered not accessible for the purposes of this evaluation and therefore will not be excavated. Distribution boxes will only be excavated when the necessary information can otherwise not be gathered.
- This is an inspection for an onsite sewage disposal system; also known as a septic system. If the property has a straight pipe exiting effluent above or just below grade, our testing procedures may not be able to determine this. We rely on homeowner disclosures to notify us of such unpermitted alterations.
- This is a subjective and visual inspection only, based upon many unknown and unseen factors.
- An 'Acceptable' evaluation does not mean the system will meet the local approving authority's criteria for determining compliance with state code: COMAR 26.04.02.02 D(4).
- The condition of the Sewage Disposal System is reported as and only as the day of the inspection.
- If house has been unoccupied this report may not be accurate. Little or no use of the septic system could have allowed problems to temporarily clear themselves.
- If the general ground condition is wet, this report may not be accurate, as ground moisture may cover or hide actual septic effluent on the service.
- In the above cases, it is recommended that the septic system be reevaluated in 2 to 4 months.
- Payment and/or use of this evaluation signifies understanding and acceptance of the above clauses, as well as any noted faults with the system.

Representative's Signature:		Date: 1/8/2015
Amount: \$450 (All Testing)	Check Number: Credit Card	Date Paid: 1/8/2015



HOME LAND SEPTIC CONSULTING, LLC

p:443-995-5385 | info@mdwellandseptic.com | www.homelandseptic.com

Date: January 8, 2015 Name of Evaluator: Eric Garrett Time: 11:00 AM Property Address: 7413 Cherry Tree Drive Clarksville, MD 21029 Recent Weather Conditions: 2-3" snow		Ordered By: Charlie & Jess Yocum Buyers: Charlie & Jess Yocum Homeowner Interview: The homeowner interview was sent and returned prior to the evaluation.		Occupied: <input checked="" type="checkbox"/> Yes <input type="checkbox"/> No Length of Time Vacant: N/A # of People Living in Home: 2 # of People moving in: 2 Property Age: 1966 System Age: 1966 Last Date of Cleaning: 18 Months Recomm'd Pumping Freq: 1-3 Years	
Liquid Level in Tank is: <input checked="" type="checkbox"/> Above Normal <input type="checkbox"/> Normal <input type="checkbox"/> Below Normal		Bottom Solids Depth:		Depth of Tank: 30 inches	
Depth of Tank: 30 inches		Type of Access: 10 Inch Clean Out		Depth of Tank Access: At Grade	
Maintenance appears: <input type="checkbox"/> Good <input checked="" type="checkbox"/> Fair <input type="checkbox"/> Poor		Depth to Distribution Box: N/A		Distance to Well: -100 Feet	
Effluent Filter present: <input type="checkbox"/> Yes <input checked="" type="checkbox"/> No		Previous high liquid level: <input type="checkbox"/> Yes <input checked="" type="checkbox"/> No		Were there any impermeable surfaces above the septic system (f.e. driveway)? <input type="checkbox"/> Yes <input checked="" type="checkbox"/> No	
Records Search: Records were requested but not received prior to the evaluation.					
Type of Tank: <input checked="" type="checkbox"/> Septic Tank (1 tank) <input type="checkbox"/> Aeration System <input type="checkbox"/> Other:		Tank Construction and Size: <input type="checkbox"/> Metal <input checked="" type="checkbox"/> Concrete <input type="checkbox"/> Plastic Tank Size: 1,250 gallons		Type of Absorption System: <input type="checkbox"/> Leaching Field <input type="checkbox"/> Raised Mound <input checked="" type="checkbox"/> Drywell (Number of: 1) <input type="checkbox"/> Cesspool <input type="checkbox"/> Other:	
System Component: Septic Tank		Condition: <input type="checkbox"/> Acceptable <input checked="" type="checkbox"/> Unacceptable <input type="checkbox"/> Needs Further Evaluation		Comments: The septic tank is composed of concrete and is 1,250 gallons in capacity. Access is a 10 Inch terracotta clean out at grade, septic tank is 30 inches below grade. Upon arrival the septic tank was overfull. The liquid level was at the base of the clean out. Placement of both front and back baffles could not be confirmed due to the high liquid level. Due to the limited access and depth of the septic tank it is recommended that a manhole riser be installed so that the septic tank can be properly maintained.	
Pump Present? <input type="checkbox"/> Yes <input checked="" type="checkbox"/> No		<input type="checkbox"/> Acceptable <input type="checkbox"/> Unacceptable			
Absorption System		<input type="checkbox"/> Acceptable <input checked="" type="checkbox"/> Unacceptable <input type="checkbox"/> Needs Further Evaluation		One drywell was located during the inspection. No access was found at grade. The edge of the drywell was probed and found to be heavily saturated with biomat present. The drywell is hydraulic loaded and can no longer receive fluid from the septic tank. This is causing the back-up in the septic tank. A new absorption system must be installed by a licensed contractor after a permit is pulled from the local health department. No water was introduced into the system due to the septic tank being over full.	

