

APPLICATION

FOR PERCOLATION TESTING AND SITE EVALUATION

TEST DATE(S) _____ TEST TIME _____

AP 5266⁴²

AGENCY REVIEW: _____

DATE 4/16/07

DO NOT WRITE ABOVE THIS LINE

I HEREBY APPLY FOR THE NECESSARY TESTING/EVALUATION PRIOR TO ISSUANCE OF SEWAGE DISPOSAL SYSTEM PERMIT(S) TO:

CHECK AS NEEDED:

- CONSTRUCT NEW SEPTIC SYSTEM(S)
- REPAIR/ADD TO AN EXISTING SEPTIC SYSTEM
- REPLACE AN EXISTING SEPTIC SYSTEM

CHECK AS NEEDED:

- NEW STRUCTURE(S)
- ADDITION TO AN EXISTING STRUCTURE
- REPLACE AN EXISTING STRUCTURE

CHECK ONE:

- CREATE NEW LOT(S)
- BUILD ON AN EXISTING LOT IN A SUBDIVISION
- BUILD ON AN EXISTING PARCEL OF RECORD

IS THE PROPERTY WITHIN 2500' OF ANY RESERVOIR?

- YES
- NO

THE TYPE OF STRUCTURE IS:

- RESIDENTIAL WITH 5 PROPOSED BEDROOMS IN THE COMPLETED STRUCTURE (NOTE **UNKNOWN** IF APPROPRIATE)
- COMMERCIAL (PROVIDE DETAIL OF NUMBERS AND TYPES OF EMPLOYEES/ CUSTOMERS ON ACCOMPANYING PLAN)
- INSTITUTIONAL/GOVERNMENT (PROVIDE DETAIL OF NUMBERS AND TYPES OF EMPLOYEES/USERS ON ACCOMPANYING PLAN)

PROPERTY OWNER(S) Mark Bruce

DAYTIME PHONE 410 442-8045 CELL _____ FAX _____

MAILING ADDRESS 1425 Coventry Meadow Dr Sykes MD
STREET CITY/TOWN STATE ZIP

APPLICANT Fogle's Septic Clean Inc

DAYTIME PHONE 410 795-5670 CELL _____ FAX _____

MAILING ADDRESS 580 Obrecht Rd Sykes MD
STREET CITY/TOWN STATE ZIP

APPLICANT'S ROLE: DEVELOPER BUILDER BUYER RELATIVE/FRIEND REALTOR CONSULTANT

PROPERTY LOCATION
SUBDIVISION/PROPERTY NAME Coventry Meadow LOT NO. 1

PROPERTY ADDRESS 1425 Coventry Meadow Dr Sykes
STREET TOWN/POST OFFICE


TAX MAP PAGE(S) _____ GRID _____ PARCEL(S) _____ PROPOSED LOT SIZE _____

AS APPLICANT, I UNDERSTAND THE FOLLOWING: THE SYSTEM INSTALLED SUBSEQUENT TO THIS APPLICATION IS ACCEPTABLE ONLY UNTIL PUBLIC SEWERAGE IS AVAILABLE. THIS APPLICATION IS COMPLETE WHEN ALL APPLICABLE FEES AND A SUITABLE SITE PLAN HAVE BEEN RECEIVED. I ACCEPT THE RESPONSIBILITY FOR COMPLIANCE WITH ALL M.O.S.H.A. AND "MISS UTILITY" REQUIREMENTS. APPROVAL IS BASED UPON SATISFACTORY REVIEW OF A PERC CERTIFICATION PLAN.

TEST RESULTS WILL BE MAILED TO APPLICANT. Rent A Cassell
SIGNATURE OF APPLICANT

HOWARD COUNTY HEALTH DEPARTMENT, BUREAU OF ENVIRONMENTAL HEALTH, WELL AND SEPTIC PROGRAM
3525-H ELLICOTT MILLS DRIVE, ELLICOTT CITY, MARYLAND 21043-4544 (410) 313-1771 FAX (410) 313-2648
TDD (410) 313-2323 TOLL FREE 1-877-4MD-DHMH

Coventry Meadows Drive

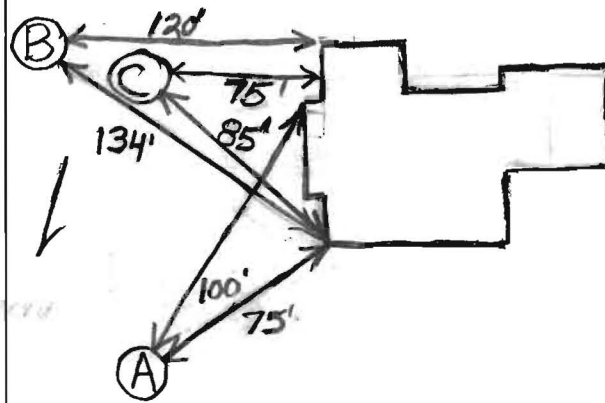

AP (A)

Light Br Heavy Cl Loam
 2'
 Or Br Heavy Cl Loam
 4.5'
 Yellow Br Si Cl Loam
 5'
 Or Br Si Cl Loam
 5.5-6'
 Wet Beige Si Loam
 Trace Rock
 10'
 Caving
 14'
 Water
 15'

(B)

Br Cl Loam
 1.5'
 Or Br Heavy Cl Loam and Sa Cl Loam
 3.5'
 Or Br Si Cl Loam
 4-4.5'
 Or Br Very Fine Sa Loam
 Trace Rock
 Throughout
 12.5'
 Caving
 15'
 Water
 16'

(C)

Br Heavy Cl Loam
 2'
 Red Br Sa Cl Loam
 3.5'
 Or Br Si Cl Loam
 5'
 Red Br Dense Fine Sa Loam
 Trace Rock
 9.5'
 Caving
 12.5'
 Water

DATE	TEST #	DEPTH	START	BREAK 1" DROP	STOP 2" DROP	TIME OF 2nd INCH	P/F/H
4/24/07	A	7'/15" V	10:48	11:29	41 for 1st inch		F
	B	5'/16" V	12:30	12:49	1:16	27	P
		6.5'	1:28	1:37:30	1:53	15 1/2	P
	C	5'/25" V	Slow				
		6.5'	2:37:30	2:55	3:17	22	

REMARKS Keep trenches at or above hole (C)
 SANITARIAN B. Baker BACKHOE Fogles OTHERS M. Bruce
 TEST HOLES USED IN SDA B+C AVG. PERC TIME _____ SQ. FT/BR _____
 TRENCH WIDTH _____ INLET DEPTH _____ MAX. BOT DEPTH _____ EFFECTIVE S/W _____

COVENTRY

add extra 40' of travel
Here for 4 beds (4 beds
200 liter FT)

EXISTING PRIVATE
SEPTIC EASEMENT

MEADOWS

ADD ET
HERE

(4)



300



30415.91N - 130.43'

LOT 2

EX. TREE LINE

R-47300

12'

REVISED SEPTIC
EASEMENT

5100 2000 GALLON
SEPTIC TANK

PROP. DISTRIBUTION
BOX

30

DKL

N 05° 44' 20" W 250.31'

7 OF
LAND

BP: 4157445

Plans OK B. Hodges

9/18/92



54.2'

54.2'

7 02° 45' 42" W

EX. 100 YEAR