

LAYOUT _____ INSP 4 _____
INSP 2 _____ INSP 5 _____
INSP 3 _____ INSP 6 _____

ISSUE DATE: 3/3/2010

PERMIT - Repair

P 532532

APPROVAL DATE: 3/5/10

A Repair

Tax ID # 5383188

ON-SITE SEWAGE DISPOSAL SYSTEM HOWARD COUNTY HEALTH DEPARTMENT BUREAU OF ENVIRONMENTAL HEALTH

Ronnie Heaps

IS PERMITTED TO INSTALL ALTER

ADDRESS: 425 Obrecht Road, Sykesville, 21784 PHONE NUMBER: 443-277-7526

SUBDIVISION: Hallmark LOT NUMBER: 40

ADDRESS: 7390 Hallmark Rd PROPERTY OWNER: John Connors

SEPTIC TANK CAPACITY (GALLONS): Ex OUTLET BAFFLE FILTER REQUIRED

PUMP CHAMBER CAPACITY (GALLONS): N/A COMPARTMENTED TANK REQUIRED

NUMBER OF BEDROOMS: 4 APPLICATION RATE: 1.2

SQUARE FOOTAGE OF HOUSE: N/A *Inlet @ 4' 2' wide.*
Bottom @ 9'

LINEAR FEET OF TRENCH REQUIRED: 140

TRENCHES:	Trenches to be 2 feet wide. Inlet 4 feet below original grade. Bottom maximum depth 9 feet below grade. Effective area begins at 6 feet below original grade. 5 feet of stone below distribution pipe.
LOCATION:	<u>H10-79-2611</u>
NOTES:	Manhole access needs to be installed on the tank. Pump and collapse ex. dry well.


PLANS APPROVED: K. Wolf DATE: 3/3/2010

- NOTE: PERMIT VOID AFTER 2 YEARS
- NOTE: CONTRACTOR RESPONSIBLE FOR SCHEDULING A PRE-CONSTRUCTION INSPECTION FOR ALL INSTALLATIONS
- NOTE: WATERTIGHT SEPTIC TANKS REQUIRED
- NOTE: ALL PARTS OF SEPTIC SYSTEM SHALL BE 100 FEET FROM ANY WATER WELL
- NOTE: MANHOLE RISERS REQUIRED ON ALL SEPTIC TANKS AND PUMP CHAMBERS

NEITHER THE HOWARD COUNTY COUNCIL OR THE HEALTH DEPARTMENT IS RESPONSIBLE FOR THE SUCCESSFUL OPERATION OF ANY SYSTEM PERMITTEE RESPONSIBLE FOR OBTAINING FINAL APPROVAL ON THIS PERMIT CALL 410-313-1771 FOR INSPECTION OF SEPTIC SYSTEM

HO-73-2641

NOT TO SCALE

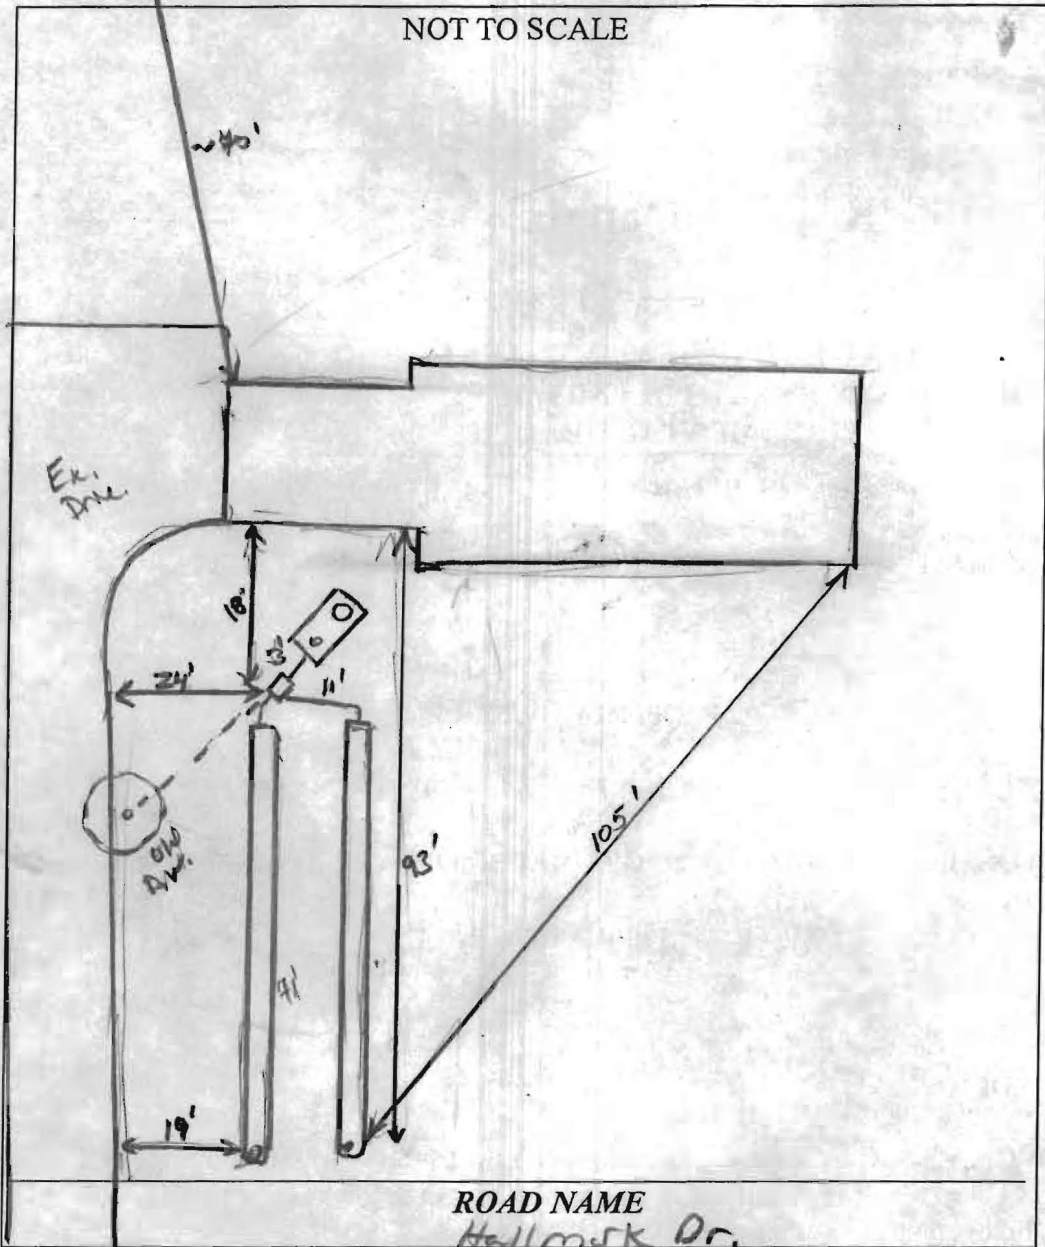

TRENCH/DRAINFIELD DATA		
WIDTH	INLET	BOTTOM
2'	4'	9'
NUMBER OF TRENCHES		2
TOTAL LENGTH		140'
ABSORPTION AREA		280' ± SW
DISTRIBUTION BOX LEVEL		Yes
DISTRIBUTION BOX BAFFLE		Yes
DISTRIBUTION BOX PORT		NO

SEPTIC TANK DATA	
SEPTIC TANK I LEVEL	Yes
MANUFACTURER	?
CAPACITY	1250? GAL
SEAM LOC	mid
TANK LID DEPTH	2'
BAFFLES	Yes
BAFFLE FILTER	—
MANHOLE LOC	Front
6" PORT LOC	Rear
WATERTIGHT TEST	—
SLOTTED	NO
DATE ON LID	—
PUMP/SEPTIC TANK LEVEL	
MANUFACTURER	—
CAPACITY	— GAL
SEAM LOC	—
TANK LID DEPTH	—
BAFFLES	—
BAFFLE FILTER	—
MANHOLE LOC	—
6" PORT LOC	—
WATERTIGHT TEST	—
SLOTTED	—
DATE ON LID	—

ROAD NAME
Hallmark Dr.

PRE-CONSTRUCTION:

3/3/10 Install 2x70' trenches slightly off contour (keeping bottoms level).

INSTALLATION:

3/5/10 New D box inst, 2 trenches installed as instructed. old DW pumped and collapsed. Stone moderately dirty (ie. fines, clay, silt).

FINAL INSPECTOR R. Way DATE OF APPROVAL 3/5/10