

PUB. SEWER STATUS VERIFIED BY \_\_\_\_\_

ISSUE DATE: 06/07/10

APPROVAL DATE: 6/30/10

# PERMIT

## MINOR SEPTIC REPAIR

P \_\_\_\_\_

A REPAIR \_\_\_\_\_

Tax ID # \_\_\_\_\_

### ON-SITE SEWAGE DISPOSAL SYSTEM

### HOWARD COUNTY HEALTH DEPARTMENT

### BUREAU OF ENVIRONMENTAL HEALTH

Freedom Septic IS PERMITTED TO INSTALL  ALTER

ADDRESS: \_\_\_\_\_ PHONE NUMBER: 410-795-2947

SUBDIVISION: \_\_\_\_\_ LOT NUMBER: \_\_\_\_\_

ADDRESS: 6209 Guilford Road PROPERTY OWNER: Josh Yolgay Suca

SEPTIC TANK CAPACITY (GALLONS): \_\_\_\_\_

PUMP CHAMBER CAPACITY (GALLONS): \_\_\_\_\_

NUMBER OF BEDROOMS: 3

SQUARE FOOTAGE (OF HOUSE): \_\_\_\_\_

LINEAR FEET OF TRENCH REQUIRED: \_\_\_\_\_

TRENCHES:	Trench to be feet wide. Inlet at feet below original grade. Bottom maximum depth feet below original grade. Effective area begins at feet below original grade. feet of stone below the distribution pipe.
LOCATION:	To replace broken pipe between septic tank and distribution system.
ADDITIONAL NOTES:	


PLANS APPROVED: \_\_\_\_\_ DATE: \_\_\_\_\_

- NOTE: PERMIT VOID AFTER 2 YEARS
- NOTE: CONTRACTOR RESPONSIBLE FOR SCHEDULING A PRE-CONSTRUCTION INSPECTION FOR ALL INSTALLATIONS
- NOTE: WATERTIGHT SEPTIC TANKS REQUIRED
- NOTE: ALL PARTS OF SEPTIC SYSTEM SHALL BE 100 FEET FROM ANY WATER WELL
- NOTE: MANHOLE RISERS REQUIRED ON ALL SEPTIC TANKS AND PUMP CHAMBERS

**NEITHER THE HOWARD COUNTY COUNCIL OR THE HEALTH DEPARTMENT IS RESPONSIBLE FOR THE SUCCESSFUL OPERATION OF ANY SYSTEM PERMITTEE RESPONSIBLE FOR OBTAINING FINAL APPROVAL ON THIS PERMIT CALL 410-313-2640 FOR INSPECTION OF SEPTIC SYSTEM**

NOT TO SCALE

well??

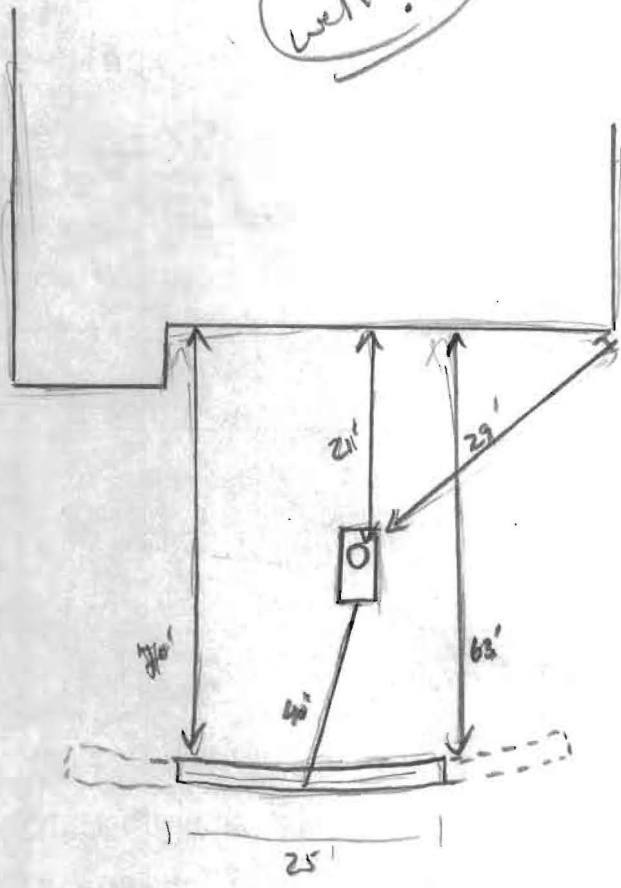

Orwellford Rd.  
ROAD NAME

**TRENCH/DRAINFIELD DATA**

WIDTH	INLET	BOTTOM
3'	4'	?
NUMBER OF TRENCHES		1
TOTAL LENGTH		?
ABSORPTION AREA		?
DISTRIBUTION BOX LEVEL		?
DISTRIBUTION BOX BAFFLE		•
DISTRIBUTION BOX PORT		

**SEPTIC TANK DATA**

SEPTIC TANK I LEVEL	Yes
MANUFACTURER	?
CAPACITY	1250? GAL
SEAM LOC	mid
TANK LID DEPTH	6'
BAFFLES	Yes (New Rev)
BAFFLE FILTER	
MANHOLE LOC	center
6" PORT LOC	none
WATERTIGHT TEST	
SLOTTED	no
DATE ON LID	

**PUMP/SEPTIC TANK LEVEL**

MANUFACTURER	
CAPACITY	GAL
SEAM LOC	
TANK LID DEPTH	
BAFFLES	
BAFFLE FILTER	
MANHOLE LOC	
6" PORT LOC	
WATERTIGHT TEST	
SLOTTED	
DATE ON LID	

PRE-CONSTRUCTION:

INSTALLATION: 6/30/10 Site insp. confirmed tree roots had clogged the trench. Installed new 4" schedule 40 w/ new 4" into trench. Approximately 25' of trench dug up and exposed. Contractor explained that the trench contained in both directions approx. 15' or so.

FINAL INSPECTOR H. Wap DATE OF APPROVAL 6/30/10