

APPLICATION

A 29047

P _____

SEWAGE DISPOSAL TESTING

STATE OF MARYLAND - DEPARTMENT OF HEALTH AND MENTAL HYGIENE

HOWARD COUNTY HEALTH DEPARTMENT
ENVIRONMENTAL HEALTH SERVICES
P. O. BOX 476, ELLICOTT CITY, MARYLAND 21043
TELEPHONE: 465-5000, EXT. 356

DISTRICT 5th

DATE 10/16/78

TO: THE COUNTY HEALTH OFFICER
ELLICOTT CITY, MARYLAND

I, HEREBY, APPLY FOR THE NECESSARY TEST IN ORDER TO CONSTRUCT (OR RECONSTRUCT) A SEWAGE DISPOSAL SYSTEM:

PROPERTY OWNER ~~Tridelphia Mill Farms Partnership~~ STEPHEN CLARK

@ Richard Hallowell
ADDRESS Sandy Spring, Md. 20860 PHONE 286-2988

PROPERTY LOCATION: 13911 Hallowell Ct Final #2

SUBDIVISION Tridelphia Mill Farms LOT NO. 2 - Sheet 1

ROAD AND DESCRIPTION On N & S sides of Tridelphia Mill Rd 1,500' E of Greenbridge Rd, Dayton

SIZE OF LOT 3.5 acres TYPE BLDG 4 bedrm, single family dwg.
NUMBER OF BEDROOMS

IF NOT SINGLE RESIDENCE DESCRIBE _____

THE SYSTEM INSTALLED UNDER THIS APPLICATION IS ACCEPTABLE ONLY UNTIL PUBLIC FACILITIES BECOME AVAILABLE:

SIGNATURE OF APPLICANT Richard Hallowell

APPROVED BY _____ FOR _____ DATE _____
(KIND OF SYSTEM)

REJECTED BY _____ FOR _____ DATE _____
(KIND OF SYSTEM)

HOLD PENDING FURTHER TESTS _____ DATE _____


REASONS FOR REJECTION OR HOLDING _____

BLDG. PERMIT SIGNED
AND RETURNED 4-16-87

DP 11264

8/2/87

THIS IS NOT A PERMIT

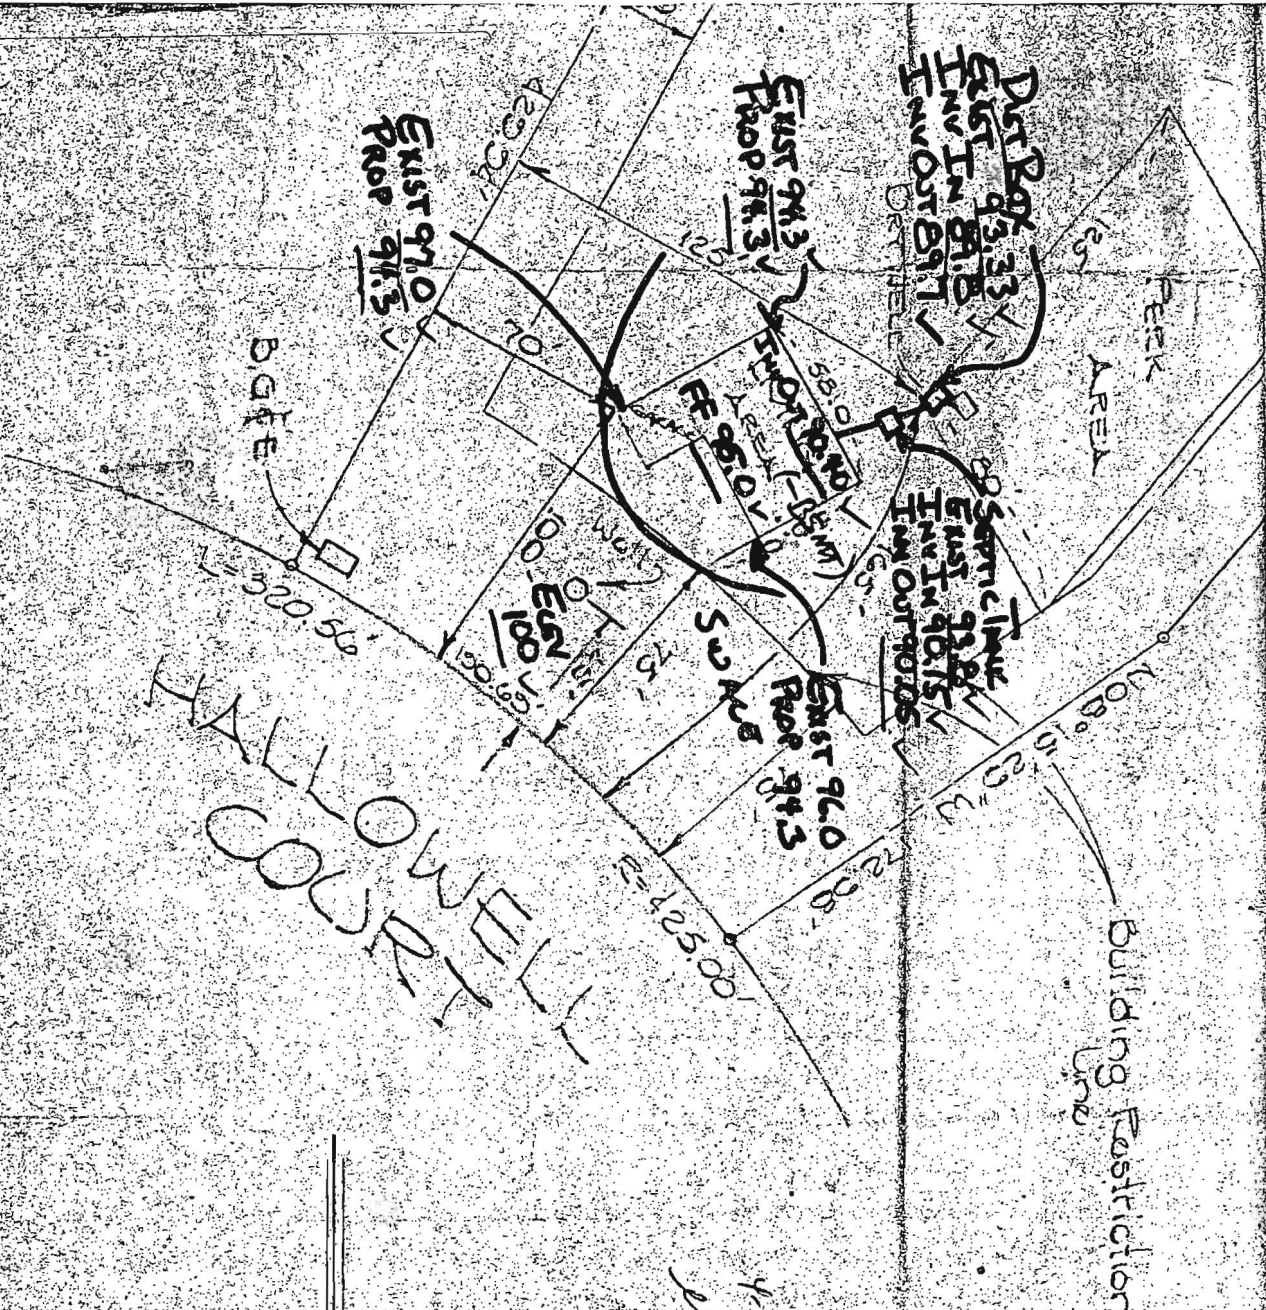

THAT COME WITH

4/16/87
 [Signature]
 S. [Signature]

BLDG. PERMIT SIGNED
 AND RETURNED 4/16-87

SP 11264

[Signature]

SCALE: 1" = 60'