

PUB. SEWER STATUS VERIFIED BY \_\_\_\_\_

ISSUE DATE: 11/13/06

P 525635

APPROVAL DATE: 12/11/06

# PERMIT

A REPAIR

Tax ID # 03-293866

## ON-SITE SEWAGE DISPOSAL SYSTEM HOWARD COUNTY HEALTH DEPARTMENT BUREAU OF ENVIRONMENTAL HEALTH

Fogles Septic Clean, Inc. IS PERMITTED TO INSTALL  ALTER

ADDRESS: 580 Obrecht Road PHONE NUMBER: 410-795-5670

SUBDIVISION: \_\_\_\_\_ LOT NUMBER: \_\_\_\_\_

ADDRESS: 12680 Old Frederick Road PROPERTY OWNER: Joseph Renehan

SEPTIC TANK CAPACITY (GALLONS): \_\_\_\_\_

*\* Bring gravel to @ least 6' or higher for safety.*

PUMP CHAMBER CAPACITY (GALLONS): \_\_\_\_\_

NUMBER OF BEDROOMS: 3

*- Inlet shallow as possible*

SQUARE FEET PER BEDROOM: 180'

*- Bottom @ 11'*

LINEAR FEET OF TRENCH REQUIRED: 135


*- Trenches 2' wide.*

TRENCHES:	Trench to be <u>2</u> feet wide. Inlet <u>2</u> feet below original grade. Bottom maximum depth <u>11</u> feet below original grade. Effective area begins at <u>Inlet</u> feet below original grade. <u>2</u> feet of stone below distribution pipe.
LOCATION:	<i>Install trenches on contour. Start 1st trench directly below tree. Stay 5-10' from Driveway. Keep 100' from neighbors well. Connect Gray water system to Ex. S.T.</i>
PURPOSE:	Existing septic system has failed. Call for inspection when ground is opened so sanitarian can recommend repair. <i>Pump / collapse old Dry well.</i>

PLANS APPROVED: BB / KW DATE: 11/20/06

- NOTE: PERMIT VOID AFTER 2 YEARS
- NOTE: CONTRACTOR RESPONSIBLE FOR SCHEDULING A PRE-CONSTRUCTION INSPECTION FOR ALL INSTALLATIONS
- NOTE: WATERTIGHT SEPTIC TANKS REQUIRED
- NOTE: ALL PARTS OF SEPTIC SYSTEM SHALL BE 100 FEET FROM ANY WATER WELL
- NOTE: MANHOLE RISERS REQUIRED ON ALL SEPTIC TANKS AND PUMP CHAMBERS

**NEITHER THE HOWARD COUNTY COUNCIL OR THE HEALTH DEPARTMENT IS RESPONSIBLE FOR THE SUCCESSFUL OPERATION OF ANY SYSTEM PERMITTEE RESPONSIBLE FOR OBTAINING FINAL APPROVAL ON THIS PERMIT CALL 410-313-2640 FOR INSPECTION OF SEPTIC SYSTEM**

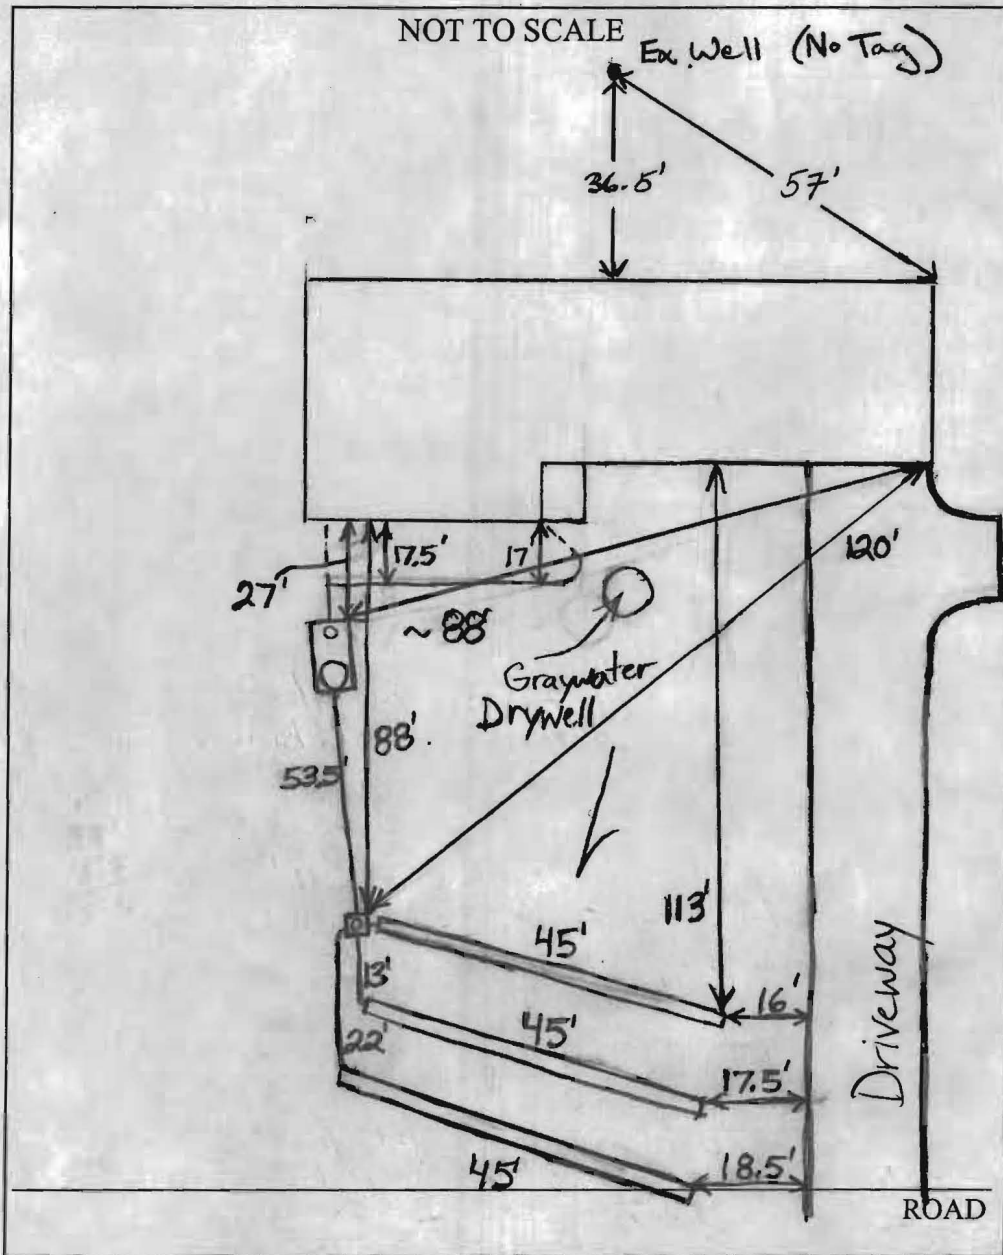

TRENCH/DRAINFIELD DATA		
WIDTH	INLET	BOTTOM
2'	6'	11'
NUMBER OF TRENCHES	3	
TOTAL LENGTH	135'	
ABSORPTION AREA	720	
DISTRIBUTION BOX LEVEL	Yes	
DISTRIBUTION BOX BAFFLE	Yes	
DISTRIBUTION BOX PORT	Yes	

SEPTIC TANK DATA	
SEPTIC TANK 1 LEVEL	Yes
CAPACITY	Existing GAL
SEAM LOC	Midseam
TANK LID DEPTH	5'-5.5'
BAFFLES	Yes
BAFFLE FILTER	No
MANHOLE LOC	Rear
6" PORT LOC	Front
WATERTIGHT TEST	No
SEPTIC TANK 2 LEVEL	N/A
CAPACITY	_____ GAL
SEAM LOC	_____
TANK LID DEPTH	_____
BAFFLES	_____
BAFFLE FILTER	_____
MANHOLE LOC	_____
6" PORT LOC	_____
WATERTIGHT TEST	_____

PRE-CONSTRUCTION \_\_\_\_\_

INSTALLATION 12/11/06 The two upper trenches have a 6' inlet. The bottom trench has a 5' inlet. Both drywells (one was for graywater) were pumped out and filled in. Graywater line was connected to septic tank. (BB)

FINAL INSPECTOR B. Baker

DATE OF APPROVAL 12/11/06