

PUB. SEWER STATUS VERIFIED BY \_\_\_\_\_

ISSUE DATE: 11/13/06

P 525636

APPROVAL DATE: 11/15/06

A REPAIR

# PERMIT

Tax ID # 05-383366

## ON-SITE SEWAGE DISPOSAL SYSTEM HOWARD COUNTY HEALTH DEPARTMENT BUREAU OF ENVIRONMENTAL HEALTH

J M Contracting LLC IS PERMITTED TO INSTALL  ALTER

ADDRESS: 309 Saddleback Trail PHONE NUMBER: 410-549-4483

SUBDIVISION: Highland Lake LOT NUMBER: 53

ADDRESS: 6605 Prestwick Drive PROPERTY OWNER: Robert McGrath

SEPTIC TANK CAPACITY (GALLONS): \_\_\_\_\_

*Trenches 3' Wide*

PUMP CHAMBER CAPACITY (GALLONS): \_\_\_\_\_

*Inlet 5.5'*

NUMBER OF BEDROOMS: 4

*Bottom 7.5'*

SQUARE FEET PER BEDROOM: 210

*Trenches 3' Wide*

LINEAR FEET OF TRENCH REQUIRED: 174'


TRENCHES:	Trench to be _____ feet wide. Inlet _____ feet below original grade. Bottom maximum depth _____ feet below original grade. Effective area begins at _____ feet below original grade. _____ feet of stone below distribution pipe.
LOCATION:	
PURPOSE:	Existing septic system has failed. Call for inspection when ground is opened so sanitarian can recommend repair.

PLANS APPROVED: \_\_\_\_\_ DATE: \_\_\_\_\_

- NOTE: PERMIT VOID AFTER 2 YEARS
- NOTE: CONTRACTOR RESPONSIBLE FOR SCHEDULING A PRE-CONSTRUCTION INSPECTION FOR ALL INSTALLATIONS
- NOTE: WATERTIGHT SEPTIC TANKS REQUIRED
- NOTE: ALL PARTS OF SEPTIC SYSTEM SHALL BE 100 FEET FROM ANY WATER WELL
- NOTE: MANHOLE RISERS REQUIRED ON ALL SEPTIC TANKS AND PUMP CHAMBERS

**NEITHER THE HOWARD COUNTY COUNCIL OR THE HEALTH DEPARTMENT IS  
RESPONSIBLE FOR THE SUCCESSFUL OPERATION OF ANY SYSTEM  
PERMITTEE RESPONSIBLE FOR OBTAINING FINAL APPROVAL ON THIS PERMIT  
CALL 410-313-2640 FOR INSPECTION OF SEPTIC SYSTEM**

NOT TO SCALE

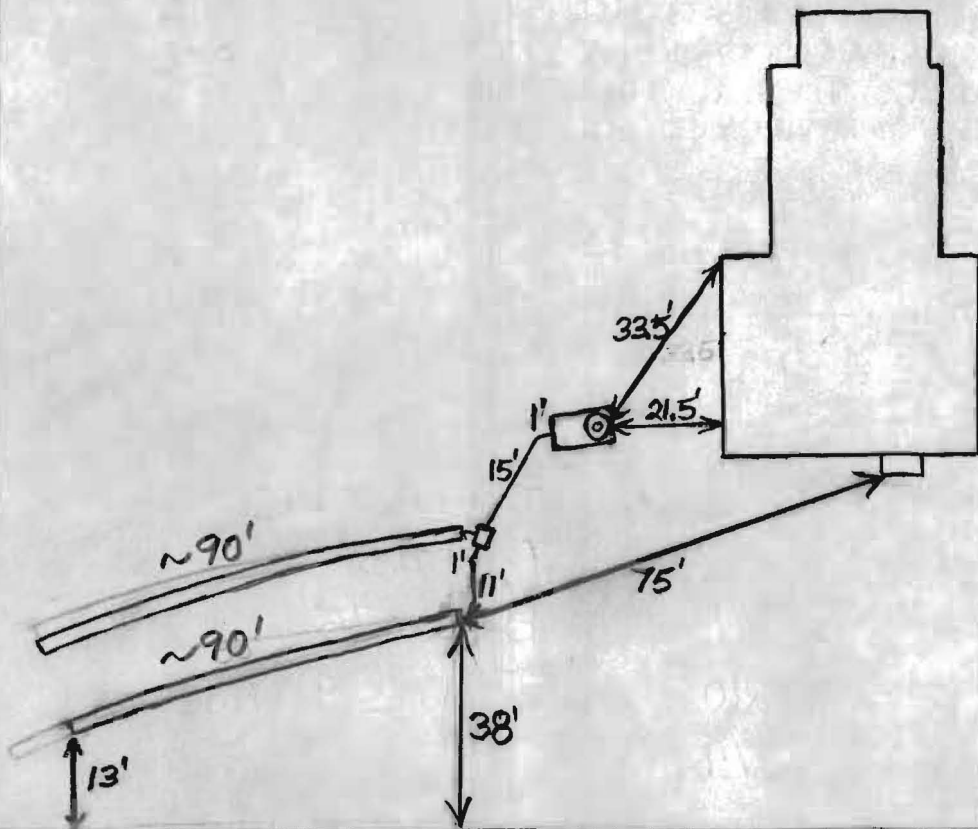

Prestwick Drive

ROAD

**TRENCH/DRAINFIELD DATA**

WIDTH	INLET	BOTTOM
3'	5.5'	7.5'

NUMBER OF TRENCHES 2

TOTAL LENGTH ~180'

ABSORPTION AREA 540 + Sidewall

DISTRIBUTION BOX LEVEL Levelers

DISTRIBUTION BOX BAFFLE Yes

DISTRIBUTION BOX PORT No

**SEPTIC TANK DATA**

SEPTIC TANK 1 LEVEL \_\_\_\_\_

CAPACITY \_\_\_\_\_ GAL

SEAM LOC Midseam

TANK LID DEPTH 1.5'-2'

BAFFLES Yes

BAFFLE FILTER No

MANHOLE LOC Front

6" PORT LOC None

WATERTIGHT TEST No

SEPTIC TANK 2 LEVEL N/A

CAPACITY \_\_\_\_\_ GAL

SEAM LOC \_\_\_\_\_

TANK LID DEPTH \_\_\_\_\_

BAFFLES \_\_\_\_\_

BAFFLE FILTER \_\_\_\_\_

MANHOLE LOC \_\_\_\_\_

6" PORT LOC \_\_\_\_\_

WATERTIGHT TEST \_\_\_\_\_

PRE-CONSTRUCTION \_\_\_\_\_

INSTALLATION 11/15/06 Trenches installed. O.K. to backfill.  
 Septic tank has roots in it and will need to be replaced.  
 Homeowner aware of problem and has agreed to install  
 new tank in near future (BB)

FINAL INSPECTOR B. Baker

DATE OF APPROVAL 11/15/06