


**SITE INSPECTION SHEET**

OWNER: ANDREW LIEBNO PHONE #: PLEASE SCHEDULE WITH ALAN @ 410-984-5093  
ADDRESS: 17000 OLD FREDERICK ROAD CONTRACTOR: FOGLED  
WELL TAG #: \_\_\_\_\_  
SUBDIVISION: \_\_\_\_\_ LOT: \_\_\_\_\_ COUNTY #: \_\_\_\_\_  
PROPOSAL: OUT OF WATER

(Repair ~~was~~ done 4/11/02 P 513600 - I did not find that paperwork)

Fence Line. - **LOCATION DIAGRAM**

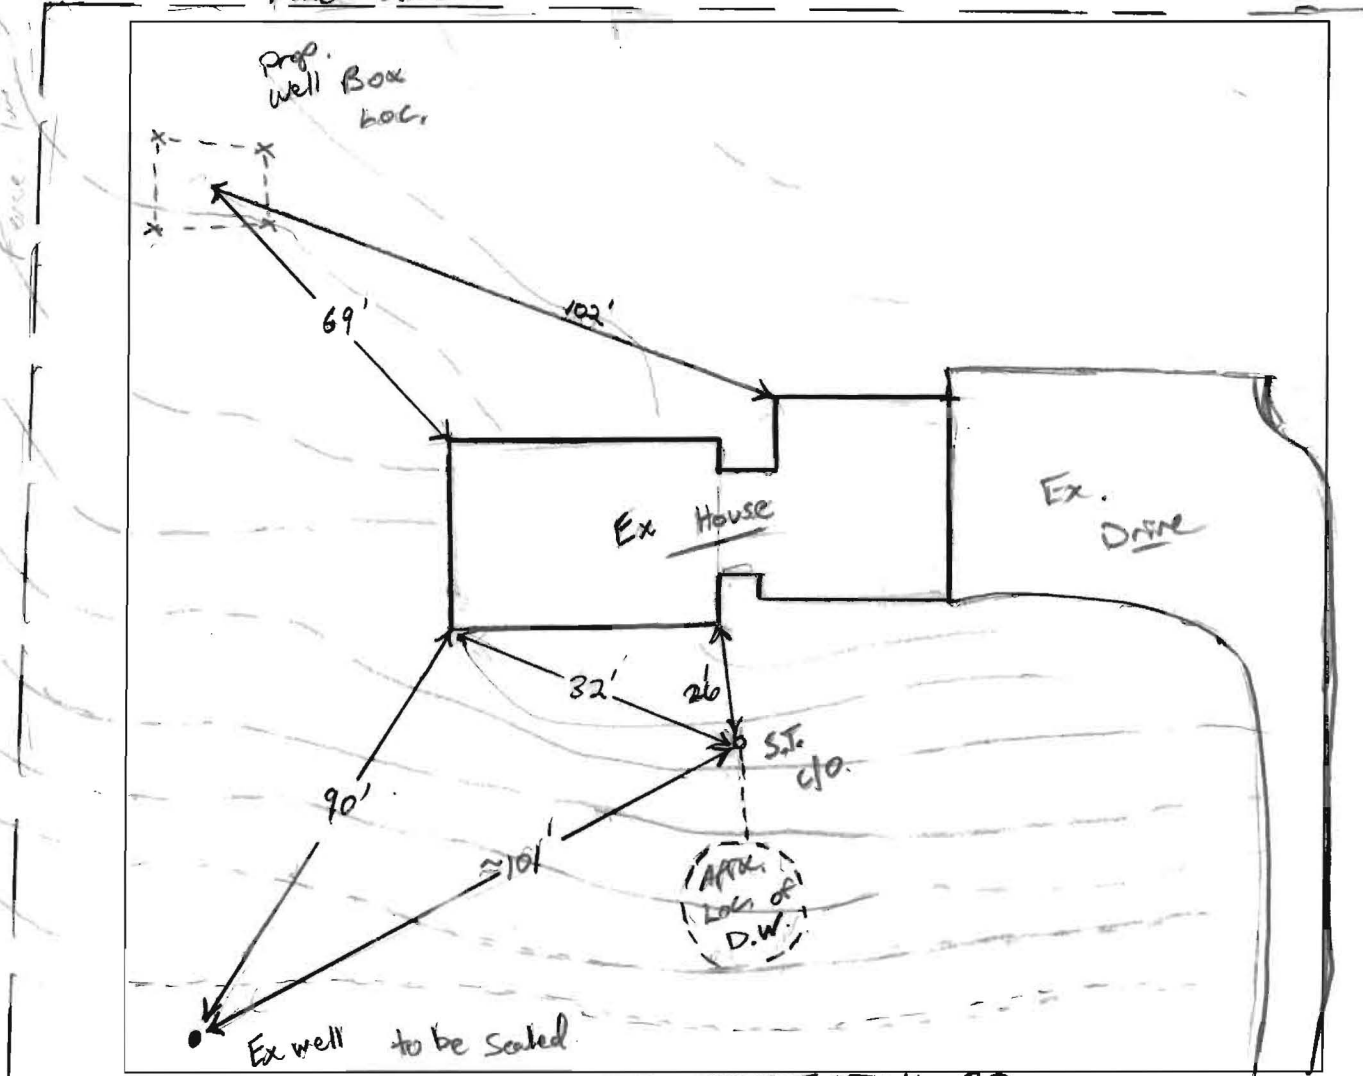

OID FREDERICK RD.

COMMENTS: To maximize use of specific repair area in front yard  
well area was moved to back corner of lot. Special condition  
to seal off upper strata / upper fracture w/ approx. amount of  
casing to be determined in field @ time of drilling.

DATE: 11/14/07 INSPECTOR: J. Wolf