

APPLICATION

SEWAGE DISPOSAL TESTING

MARYLAND STATE DEPARTMENT OF HEALTH

HOWARD COUNTY

ELLICOTT CITY

DISTRICT 5th

DATE 3/29/73

A 18192

P _____

TO: THE COUNTY HEALTH OFFICER
ELLICOTT CITY, MARYLAND

I, HEREBY, APPLY FOR THE NECESSARY TESTS IN ORDER TO CONSTRUCT OR RECONSTRUCT A SEWAGE DISPOSAL SYSTEM.

PROPERTY OWNER R. Drawbaugh, Sarah P. Ansell, Harriett S. Gibson

ADDRESS _____ PHONE Ansell - 652-1728

PROPERTY LOCATION:

SUBDIVISION Route 32 Clarksville, Md Liber 193, Folio 344, Parcel 163, Map 34, Block 12

ROAD AND DESCRIPTION MacAdam

OCCUPANT _____ PHONE _____

PERSON TO CONSTRUCT SYSTEM _____

ADDRESS _____ PHONE _____

SIZE OF LOT 1.83 Acres TYPE BLDG. 3-4 BedRm
NUMBER OF BEDROOMS

IF NOT SINGLE RESIDENCE DESCRIBE _____

SIGNATURE OF APPLICANT Raymond E Greenstreet

APPROVED BY _____ FOR _____ DATE _____
(KIND OF SYSTEM)

REJECTED BY _____ FOR _____ DATE _____
(KIND OF SYSTEM)


HOLD PENDING FURTHER TESTS _____ DATE _____

REASONS FOR REJECTION OR HOLDING _____

THIS IS NOT A PERMIT

AG 121

MONTANA

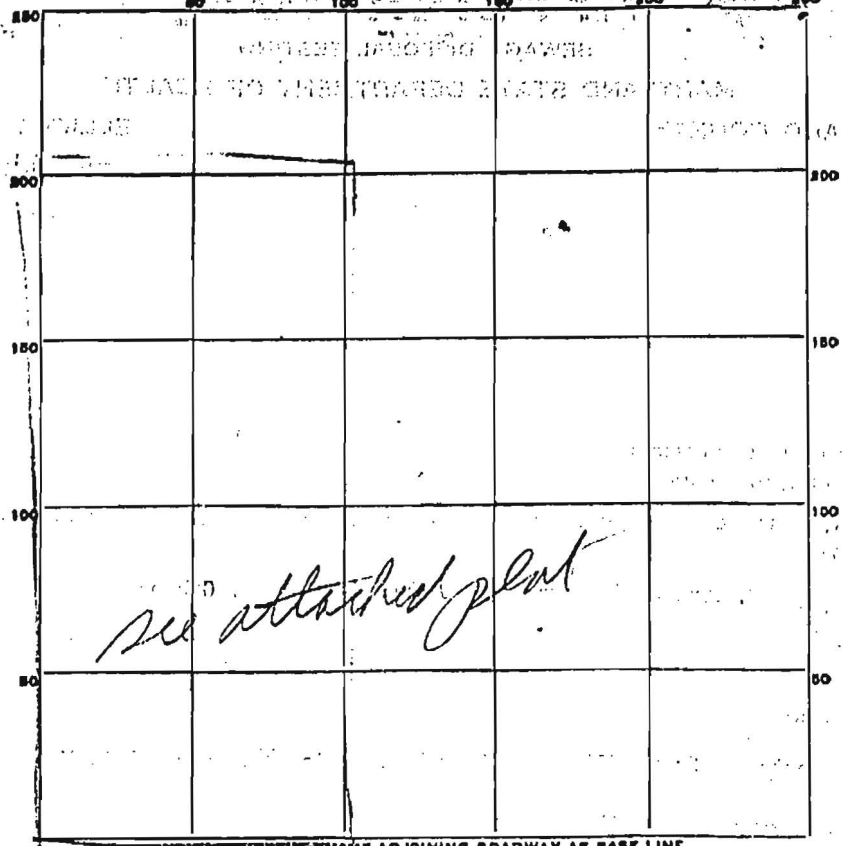

INDICATE NORTH - NAME ADJOINING ROADWAY AS BASE LINE.

ROUTE 32


20 min. org.

DATE	TEST NO.	DEPTH	PRE-WET		TEST - 1" DROP		TIME
			START	STOP	START	STOP	
4/15/73	①	6 1/2	7 02	7 20	litter		30
	2	17	TOP 5 FT BOT 4 FT		CLAY SANDY ROCK		1.2
	③	4	2 25	2 35	litter perc		30
	4	10 1/2	2 25	2 10	2 20	2 29	1.
	⑤	5 1/2	2 45	2 15	litter perc		30
	6	10	TOP 5 FT BOT 4 FT		CLAY SANDY		
	7	10 1/2	2 50	2 32	2 52	2 56	4
	8	5	2 56	3 05	3 05	3 25	20
Same loc	9	6	3 08	3 15	3 15	3 35	20
4/16/73	10	10	TOP 5 FT BOT 4 FT		LAY AND SAND		

SOIL AUGER FINDING

TESTED BY R. J. [unclear] 4/16/73


REMARKS

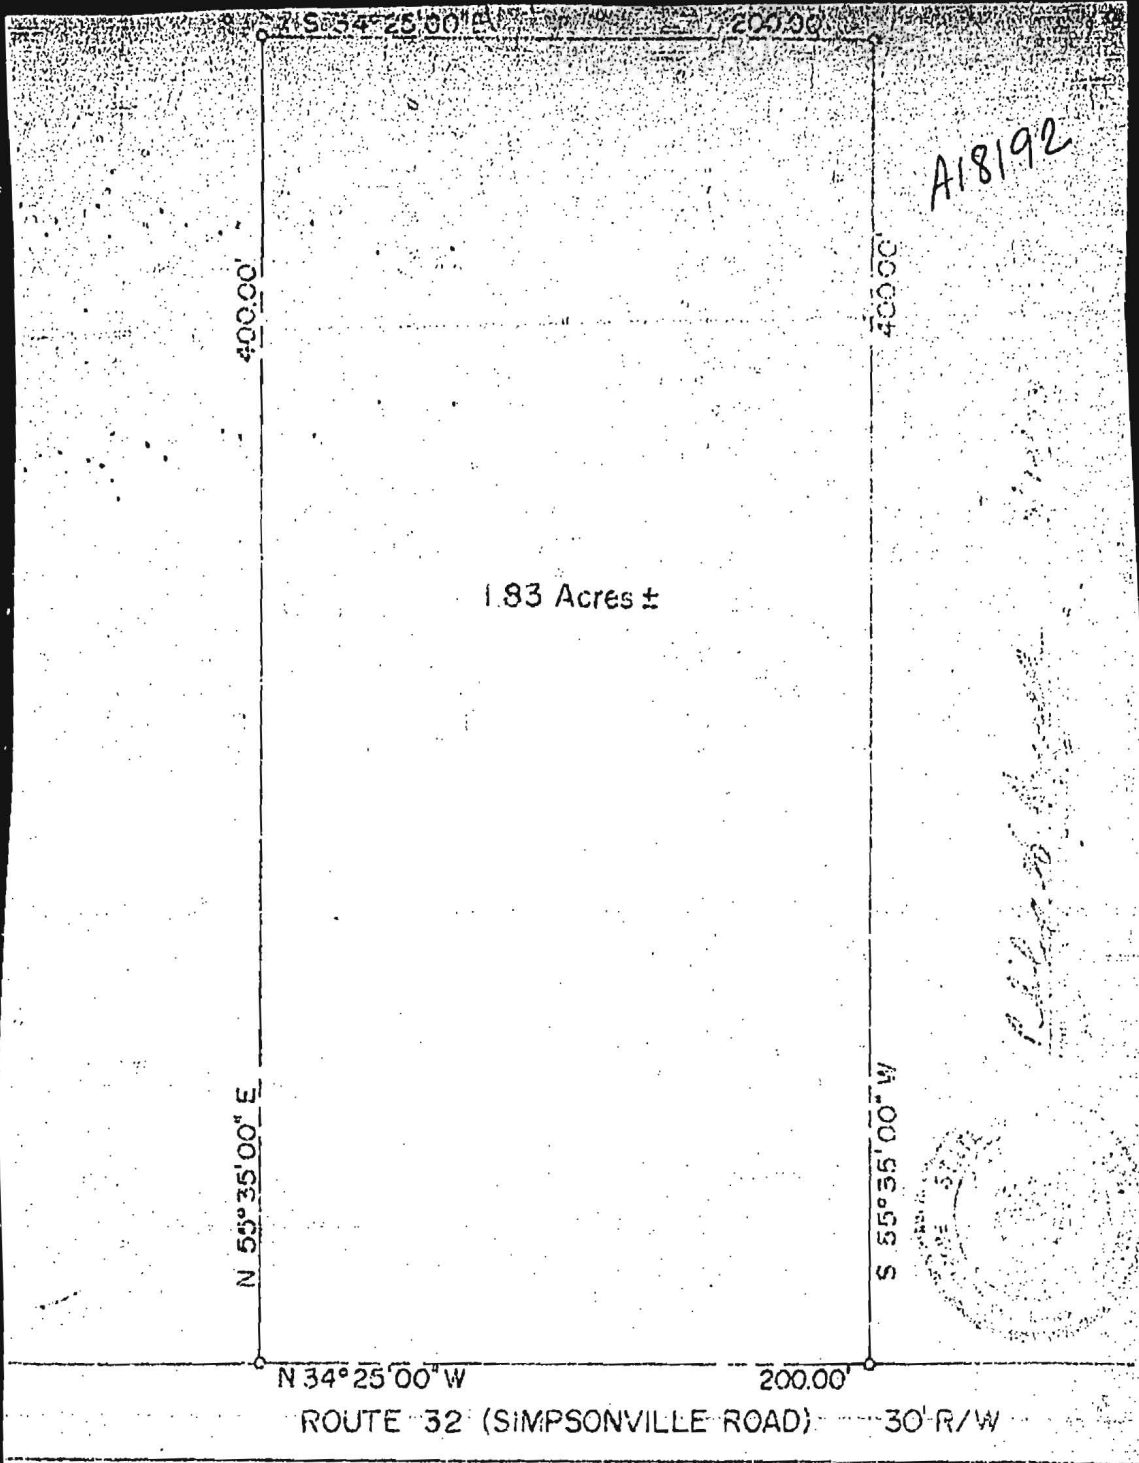

A18192



Approved for private use and plat by
[Signature] 4/24/22
 County Clerk, Jefferson County, MO

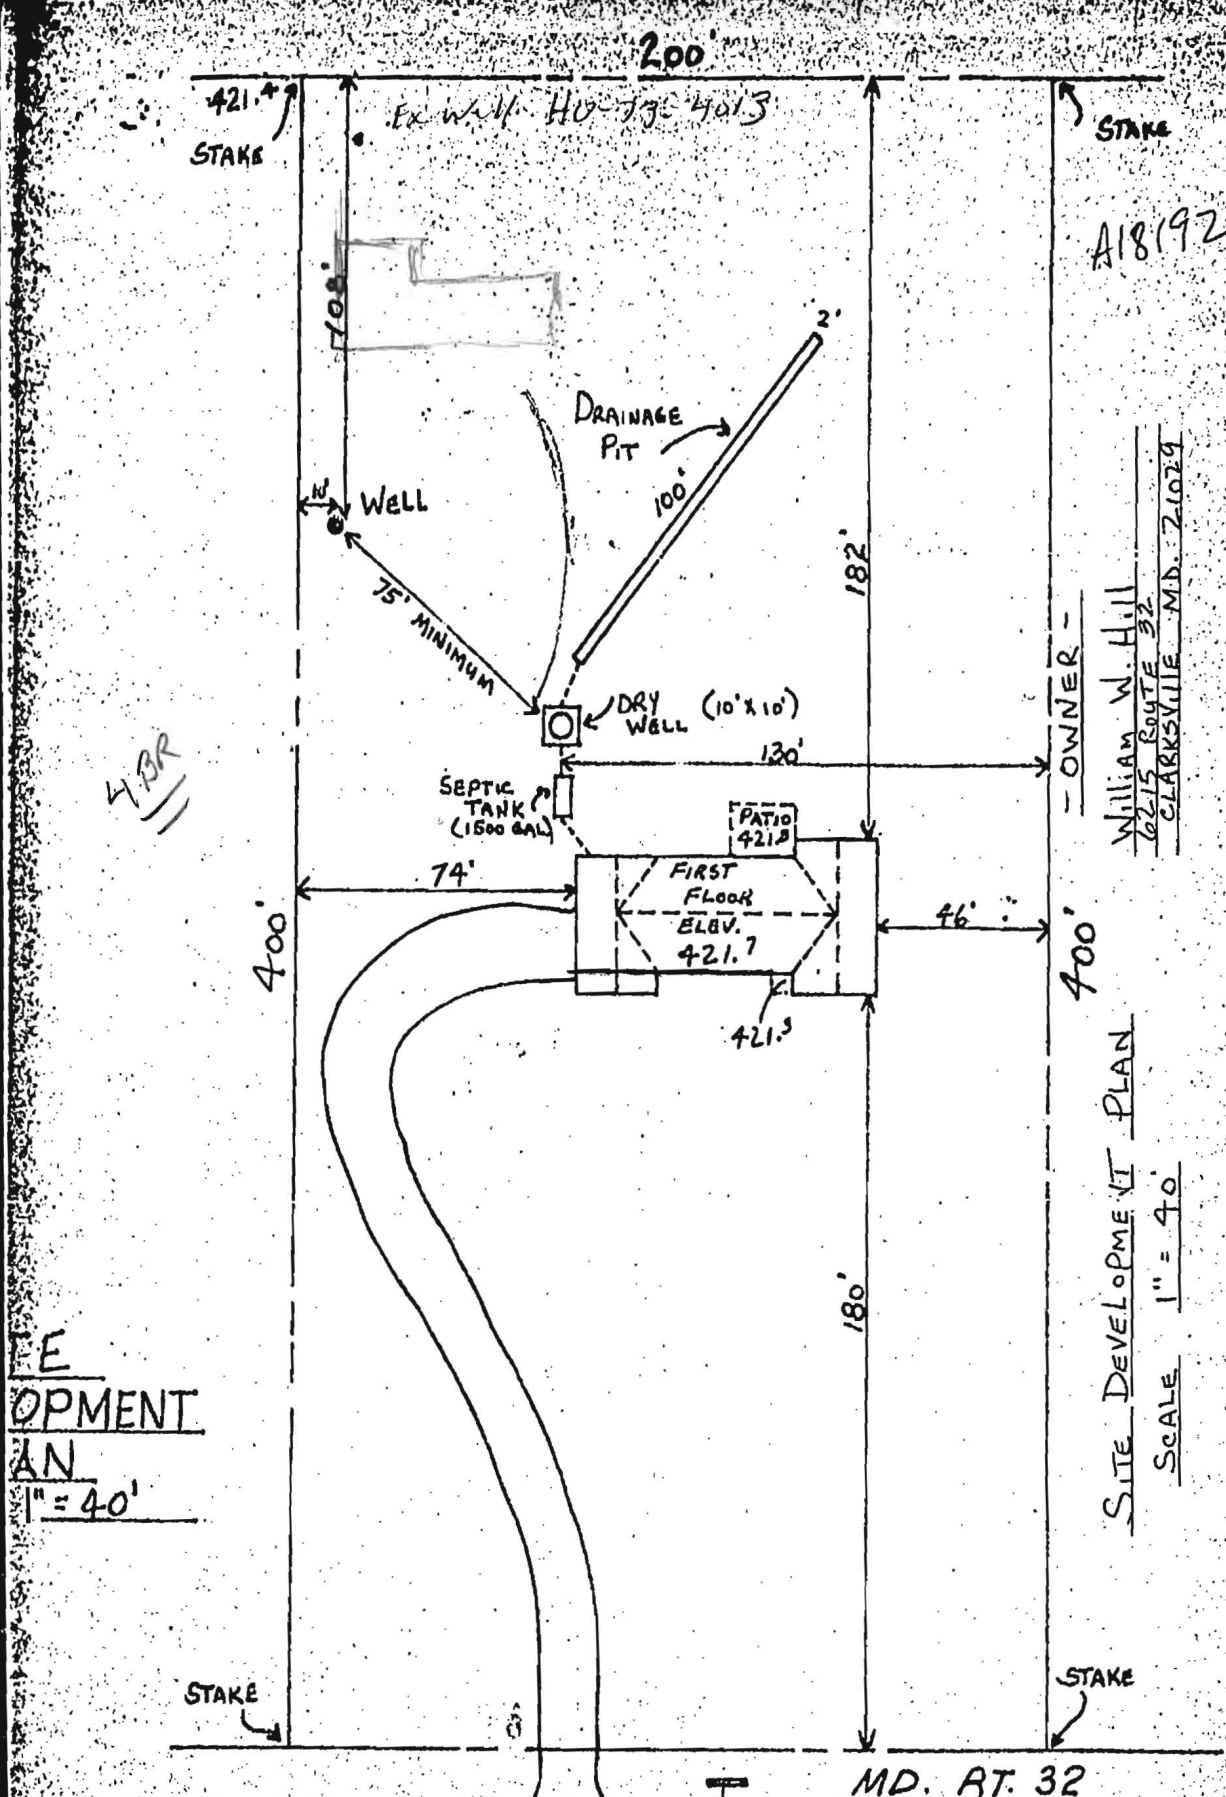

4/BR

DEVELOPMENT PLAN
1" = 40'

A18192

OWNER -
William W. Hill
6215 ROUTE 32
CLARKSVILLE, MD. 21029

SITE DEVELOPMENT PLAN
SCALE 1" = 40'

MD. RT. 32