



APPLICATION

FOR PERCOLATION TESTING AND SITE EVALUATION

TEST DATE(S) _____ TEST TIME _____ A/P _____

AGENCY REVIEW: _____ DATE _____

DO NOT WRITE ABOVE THIS LINE

I HEREBY APPLY FOR THE NECESSARY TESTING/EVALUATION PRIOR TO ISSUANCE OF SEWAGE DISPOSAL SYSTEM PERMIT(S) TO:

CHECK AS NEEDED:

- CONSTRUCT NEW SEPTIC SYSTEM(S)
- REPAIR/ADD TO AN EXISTING SEPTIC SYSTEM
- REPLACE AN EXISTING SEPTIC SYSTEM

CHECK AS NEEDED:

- NEW STRUCTURE(S)
- ADDITION TO AN EXISTING STRUCTURE
- REPLACE AN EXISTING STRUCTURE

CHECK ONE:

- CREATE NEW LOT(S)
- BUILD ON AN EXISTING LOT IN A SUBDIVISION
- BUILD ON AN EXISTING PARCEL OF RECORD

IS THE PROPERTY WITHIN 2500' OF ANY RESERVOIR?

- YES
- NO

THE TYPE OF STRUCTURE IS:

- RESIDENTIAL WITH _____ PROPOSED BEDROOMS IN THE COMPLETED STRUCTURE (NOTE **UNKNOWN** IF APPROPRIATE)
- COMMERCIAL (PROVIDE DETAIL OF NUMBERS AND TYPES OF EMPLOYEES/ CUSTOMERS ON ACCOMPANYING PLAN)
- INSTITUTIONAL/GOVERNMENT (PROVIDE DETAIL OF NUMBERS AND TYPES OF EMPLOYEES/USERS ON ACCOMPANYING PLAN)

PROPERTY OWNER(S) _____

DAYTIME PHONE _____ CELL _____ FAX _____

MAILING ADDRESS _____
STREET CITY/TOWN STATE ZIP

APPLICANT _____

DAYTIME PHONE _____ CELL _____ FAX _____

MAILING ADDRESS _____
STREET CITY/TOWN STATE ZIP

APPLICANT'S ROLE: DEVELOPER BUILDER BUYER RELATIVE/FRIEND REALTOR CONSULTANT

PROPERTY LOCATION
SUBDIVISION/PROPERTY NAME _____ LOT NO. _____

PROPERTY ADDRESS _____
STREET TOWN/POST OFFICE

TAX MAP PAGE(S) _____ GRID _____ PARCEL(S) _____ PROPOSED LOT SIZE _____

AS APPLICANT, I UNDERSTAND THE FOLLOWING: THE SYSTEM INSTALLED SUBSEQUENT TO THIS APPLICATION IS ACCEPTABLE ONLY UNTIL PUBLIC SEWERAGE IS AVAILABLE. THIS APPLICATION IS COMPLETE WHEN ALL APPLICABLE FEES AND A SUITABLE SITE PLAN HAVE BEEN RECEIVED. I ACCEPT THE RESPONSIBILITY FOR COMPLIANCE WITH ALL M.O.S.H.A. AND "MISS UTILITY" REQUIREMENTS. APPROVAL IS BASED UPON SATISFACTORY REVIEW OF A PERC CERTIFICATION PLAN.


TEST RESULTS WILL BE MAILED TO APPLICANT. _____
SIGNATURE OF APPLICANT

HOWARD COUNTY HEALTH DEPARTMENT, BUREAU OF ENVIRONMENTAL HEALTH, WELL AND SEPTIC PROGRAM
3525-H ELLICOTT MILLS DRIVE, ELLICOTT CITY, MARYLAND 21043-4544 (410) 313-1771 FAX (410) 313-2648
TDD (410) 313-2323 TOLL FREE 1-877-4MD-DHMH

SITE INSPECTION SHEET


OWNER: _____ PHONE #: _____
ADDRESS: Meadow Vista Way CONTRACTOR: _____
SUBDIVISION: Clearview Egt. LOT: 22 WELL TAG #: _____
COUNTY #: _____
PROPOSAL: _____

LOCATION DIAGRAM

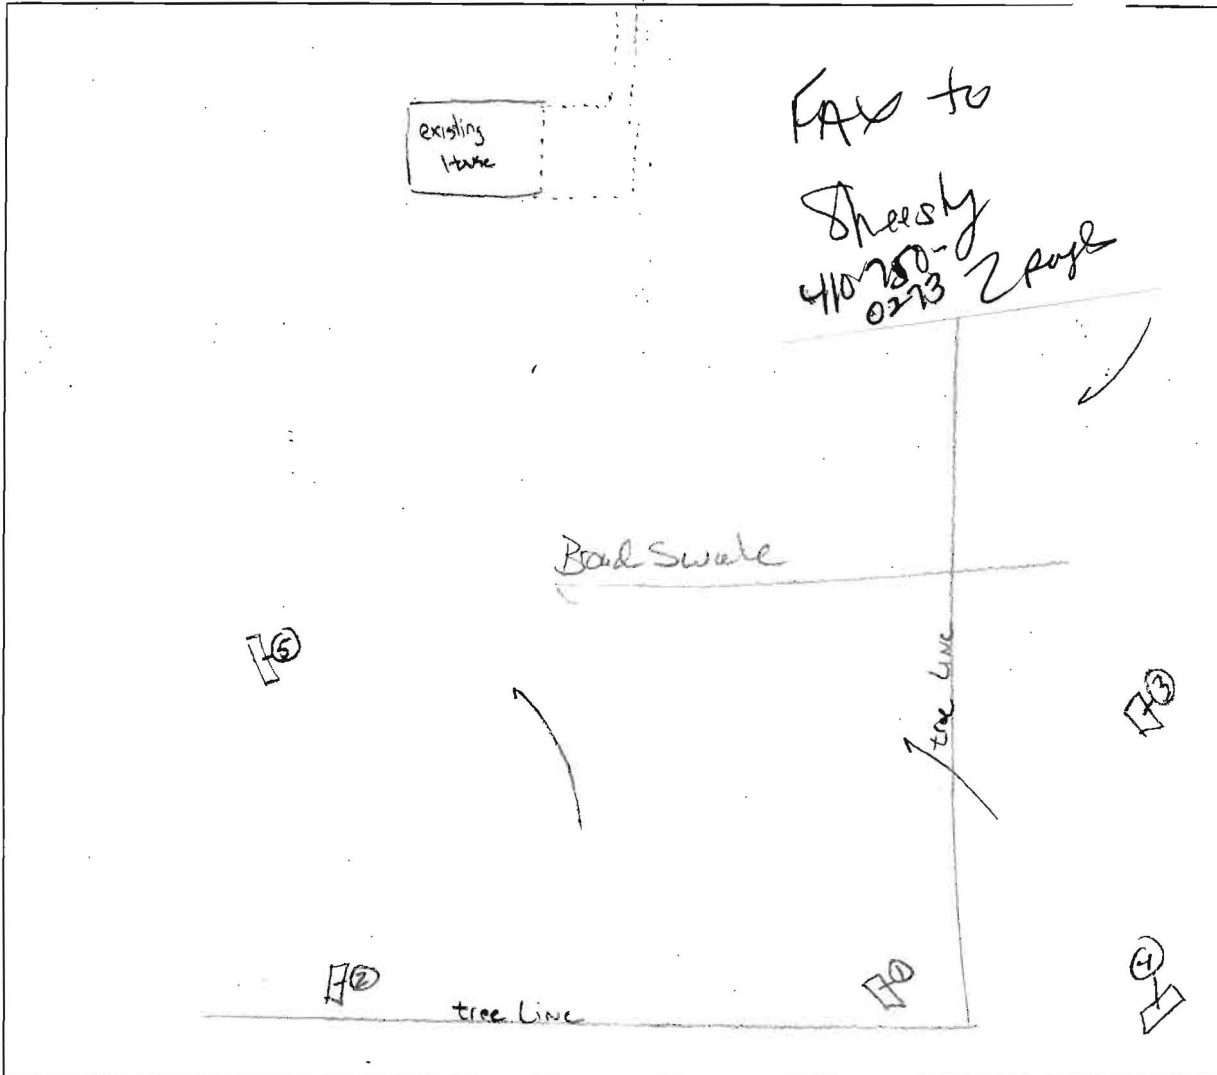

COMMENTS: See other sheet for soil descriptions.

DATE: 2/17/05 INSPECTOR: KJB w/ Bob Sheehy & Mike Johnson

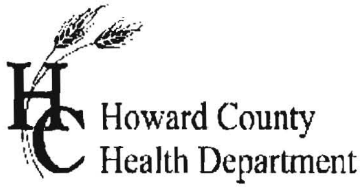

APPLICATION

FOR PERCOLATION TESTING AND SITE EVALUATION

TEST DATE(S) _____ TEST TIME _____ A# 521972

AGENCY REVIEW: _____ DATE 2/3/2005

TAX ID # 05-409063

DO NOT WRITE ABOVE THIS LINE

I HEREBY APPLY FOR THE NECESSARY TESTING/EVALUATION PRIOR TO ISSUANCE OF SEWAGE DISPOSAL SYSTEM PERMIT(S) TO:

CHECK AS NEEDED:

- CONSTRUCT NEW SEPTIC SYSTEM(S)
- REPAIR/ADD TO AN EXISTING SEPTIC SYSTEM
- REPLACE AN EXISTING SEPTIC SYSTEM

CHECK AS NEEDED:

- NEW STRUCTURE(S)
- ADDITION TO AN EXISTING STRUCTURE
- REPLACE AN EXISTING STRUCTURE

CHECK ONE:

- CREATE NEW LOT(S)
- BUILD ON AN EXISTING LOT IN A SUBDIVISION
- BUILD ON AN EXISTING PARCEL OF RECORD

IS THE PROPERTY WITHIN 2500' OF ANY RESERVOIR?

- YES
- NO

THE TYPE OF STRUCTURE IS:

- RESIDENTIAL WITH 5 PROPOSED BEDROOMS IN THE COMPLETED STRUCTURE (NOTE **UNKNOWN** IF APPROPRIATE)
- COMMERCIAL (PROVIDE DETAIL OF NUMBERS AND TYPES OF EMPLOYEES/ CUSTOMERS ON ACCOMPANYING PLAN)
- INSTITUTIONAL/GOVERNMENT (PROVIDE DETAIL OF NUMBERS AND TYPES OF EMPLOYEES/USERS ON ACCOMPANYING PLAN)

PROPERTY OWNER(S) PETER AND MARYBETH CADDIGAN

DAYTIME PHONE 410-531-9601 CELL 202-360-9700 FAX _____

MAILING ADDRESS 11927 MEADOW VISTA WAY, CLARKSVILLE MD
STREET CITY/TOWN STATE ZIP

APPLICANT ROBERT SHEESLEY

DAYTIME PHONE 410-750-9925 CELL 443-520-5977 FAX 410-750-0273

MAILING ADDRESS 8354 CHESTNUT FARM LANE ELLICOTT CITY MD 21043
STREET CITY/TOWN STATE ZIP

APPLICANT'S ROLE: DEVELOPER BUILDER BUYER RELATIVE/FRIEND REALTOR CONSULTANT

PROPERTY LOCATION

SUBDIVISION/PROPERTY NAME CLEARVIEW ESTATES, SECTION 1 LOT NO. 22/23

PROPERTY ADDRESS 11927 MEADOW VISTA WAY CLARKSVILLE, MD
STREET TOWN/POST OFFICE

TAX MAP PAGE(S) LIBER 3993 FOLIO 101 GRID 101 PARCEL(S) 998834 PROPOSED LOT SIZE 3.0 ACRES

AS APPLICANT, I UNDERSTAND THE FOLLOWING: THE SYSTEM INSTALLED SUBSEQUENT TO THIS APPLICATION IS ACCEPTABLE ONLY UNTIL PUBLIC SEWERAGE IS AVAILABLE. THIS APPLICATION IS COMPLETE WHEN ALL APPLICABLE FEES AND A SUITABLE SITE PLAN HAVE BEEN RECEIVED. I ACCEPT THE RESPONSIBILITY FOR COMPLIANCE WITH ALL M.O.S.H.A. AND "MISS UTILITY" REQUIREMENTS. APPROVAL IS BASED UPON SATISFACTORY REVIEW OF A PERC CERTIFICATION PLAN.

TEST RESULTS WILL BE MAILED TO APPLICANT. Robert W Sheesley
SIGNATURE OF APPLICANT

HOWARD COUNTY HEALTH DEPARTMENT, BUREAU OF ENVIRONMENTAL HEALTH, WELL AND SEPTIC PROGRAM
3525-H ELLICOTT MILLS DRIVE, ELLICOTT CITY, MARYLAND 21043-4544 (410) 313-1771 FAX (410) 313-2648
TDD (410) 313-2323 TOLL FREE 1-877-4MD-DHMH

TRANSMITTAL:

TO: Mr. John Boris
Bureau of Environmental Health
Howard County Health Department

FROM: Robert W. Sheesley
Eco Sense, Inc.
8354 Chestnut Farm Lane
Ellicott City, Md. 21043
Tele: 410-750-9925
Fax: 410-750-0273

DATE: 1/28/05

COMMENTS:

Dear John:

Enclosed are the documents and percolation test application, with accompanying check for the property that we discussed located at 11927 Meadow Vista Way, in Clarksville. The property is identified as Lot 22, Clearview Estates, Section 1, Plat Book 8940, Parcel ID-998834, and is owned by Peter and Mary Beth Caddigan. Refer to the copy of the document identifying the recorded Lot 22 which is included.

As you may recall, the Caddigans wish to subdivide there lot of 5.7 acres into two lots. In order to accomplish this subdivision, the Caddigan's have entered into an agreement with their neighbors at 11921 Meadow Vita Way, Lot 23, John and Maria Ruiz to purchase a 0.3 acre section of at the rear of their property to achieve a 3 acre lot size to meet the County requirement of a 3 acre lot size minimum for the new lot. Refer to the proposed letter of agreement and tax map included with this submittal.

We are applying for a date to conduct soil evaluations and percolation testing on the rear of Lot 23, and on Lot 22, if necessary to locate a 10,000 squar foot sewage reserve are for the new lot.

Please review this request and contact me if there are any questions.

Bob Sheesley

cc: Pete Caddigan

January 10, 2005

Mr. Robert W. Sheesley
Environmental Consultants
8354 Chestnut Farm Lane
Ellicott City, Md. 21043

Dear Bob,

This letter serves as formal notification that I have reached a verbal agreement with my neighbors, Jose and Maria Ruiz, to purchase a portion of their property and begin the next step in the process of subdividing my lot. The Ruiz's own Lot #23 and have granted permission to access their property, in the area that will be purchased, for the purpose of conducting perc testing. Please schedule this testing at your earliest convenience.

Regards,



Peter J. Caddigan

SITE INSPECTION SHEET

OWNER: _____ PHONE #: _____


ADDRESS: Meadow Vista Way CONTRACTOR: _____

WELL TAG #: _____

SUBDIVISION: Clearview Egt. LOT: 22 COUNTY #: _____

PROPOSAL: _____

LOCATION DIAGRAM

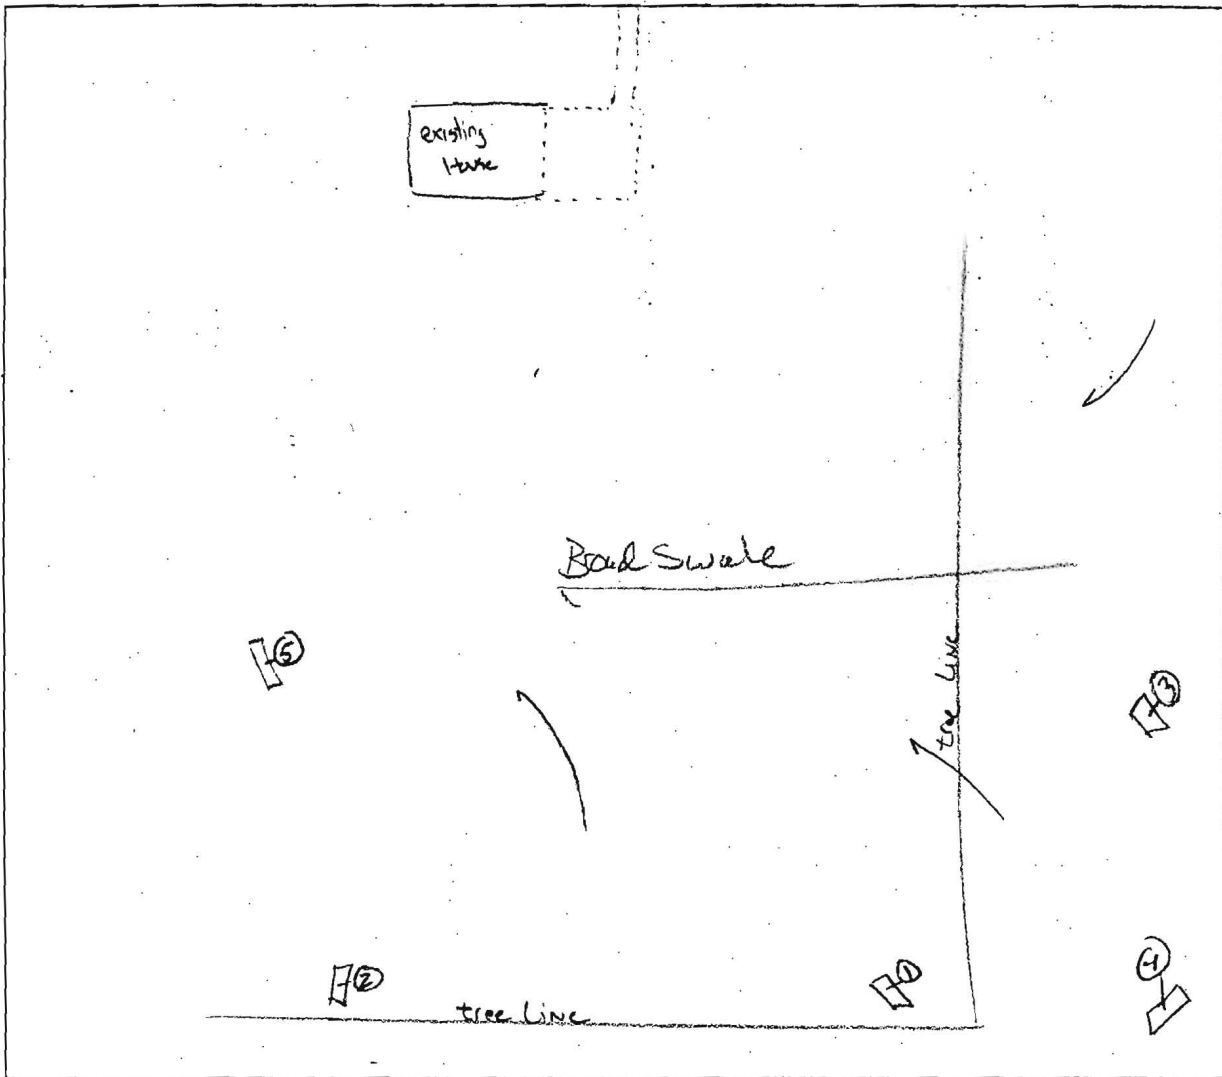

COMMENTS: See other sheet for soil descriptors.

DATE: 2/17/05 INSPECTOR: KJB w/ Bob Steady + Mike Johnson