

5/5/72
Ready
1972
5/26/72

16961
P 26961

PERMIT

SEWAGE DISPOSAL SYSTEM

MARYLAND STATE DEPARTMENT OF HEALTH

HOWARD COUNTY

ELLICOTT CITY

DISTRICT 5

INDEXED

DATE 4/26/72

Donald G. Perlette

IS PERMITTED TO INSTALL ALTER X

ADDRESS 6575 Route 32, Clarksville, Md.

PHONE 766-2140

A SEWAGE DISPOSAL SYSTEM LOCATED AT

SUBDIVISION

ROAD

12598 Route 216
Highland, Md.

LOT

PROPERTY OWNER

Mr. Carl Kemmerer

725-6603

ADDRESS

SPECIFICATIONS

DRAIN FIELD _____ DEPTH _____ FEET, BOTTOM AREA _____ SQ. FT.

SEEPAGE PITS _____ ABSORBENT SIDE-WALL AREA _____ SQ. FT.

SEPTIC TANK CAPACITY _____ GALLONS

FOR GARBAGE GRINDER, INCREASE DISPOSAL AREA 22% & TANK CAPACITY 50%.

OTHER REPAIR - Call for inspection when ground is opened up and sanitation

will recommend repair system.

Tile Field 300 sq ft bottom area
Use 1 ft. bucket width - install 3 FT to 4 FT
leaving gravel with 1 FT of gravel

PLANS APPROVED BY Frank P. Nida


DATE 4/26/72

Plan & New tile field old tank
FILL SEPTIC TANK AND DISTRIBUTION BOX WITH WATER BEFORE CALLING FOR AN INSPECTION. COVER NO WORK UNTIL INSPECTED AND APPROVED. Soil unsatisfactory for

NEITHER THE HOWARD COUNTY COMMISSIONERS NOR THE HEALTH DEPARTMENT IS RESPONSIBLE FOR THE SUCCESSFUL OPERATION OF ANY SYSTEM.

Topsoil CL
 yellowish-brown CL
 grey > grey & white
 gravel CL
 bottom
 probably pushed water table
 in well screen

Hole B
 6" Dia
 1' Bed CL
 3' Red HL
 4' 5" Red-brown Red
 SL
 6" Top FSL
 (Mudstone)
 11"

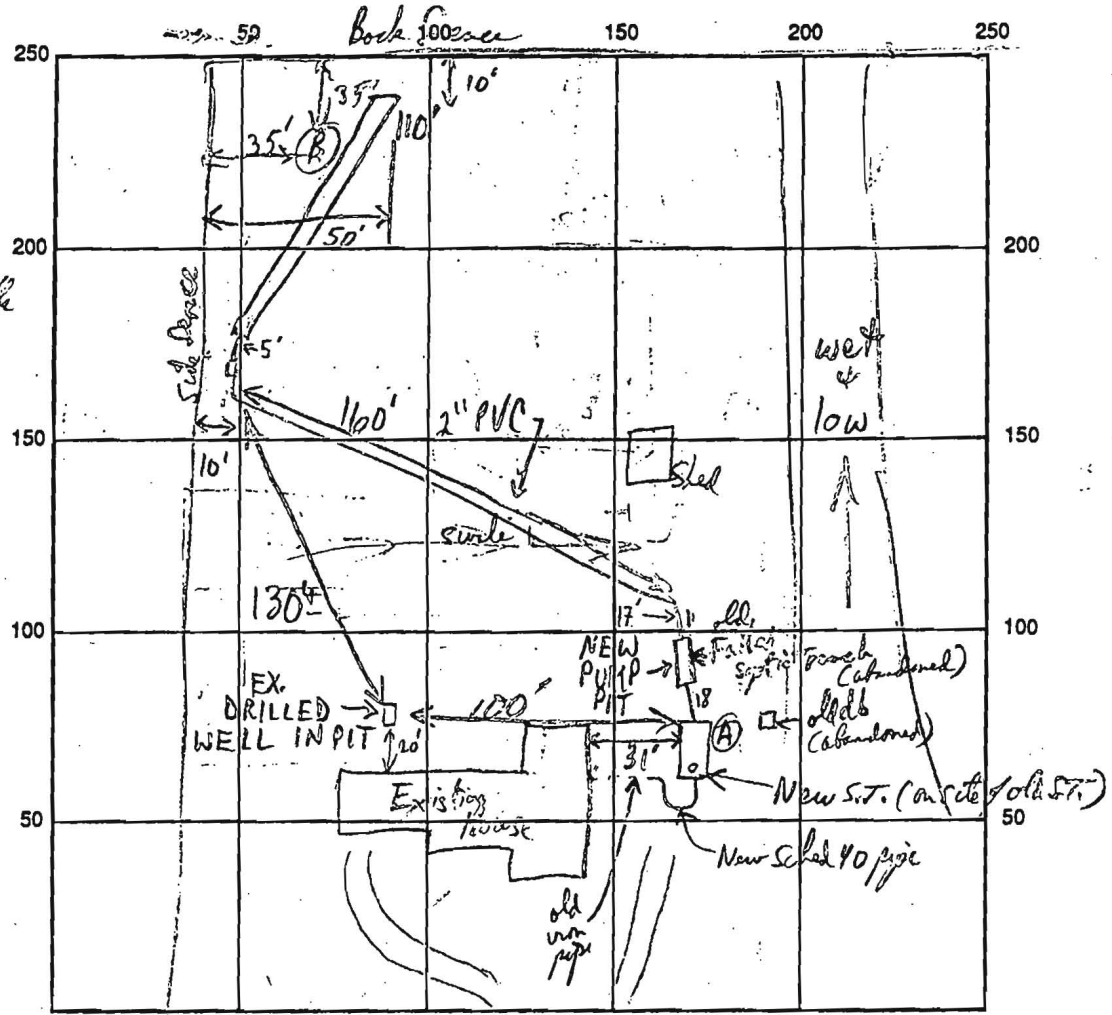

TO HIGHLAND

RT. 216

INDICATE NORTH - NAME ADJOINING ROADWAY AS BASE LINE

SEPTIC TANK LEVEL 1500 GAL - 1 CHAMBER ^{TOP SEAMED} CLEANOUTS STV MH TO BE PLACED ON PUMP PIT
 Pump Chamber 1000 GAL - TOP SEAMED
 DISTRIBUTION BOX LEVEL

DRAIN FIELD/TITLE DEPTH 9 FT. TRENCH WIDTH 2-3 FT. INLET DEPTH 3 FT.
 EFFECTIVE GRAVEL DEPTH 6 FT. TOTAL LENGTH 110 FT.
 NUMBER OF TRENCHES 1 ONE SIDEWALL/BOTTOM AREA 660 SQ. FT.
 DRYWALL INSIDE DIAMETER FT. EFFECTIVE DEPTH BELOW INLET FT.
 ABSORBENT AREA 660 SQ. FT.

REMARKS: 10/8/96 existing Dist box & Septic Tank on low side of lot Next to ^{origin} Flood Plain/Baile soils. As a result water table problems. I advised Contractor of Need for Top Seamed tank and probable pump system to higher ground ^{10/8/96} RJP


10/10/96 Glayed soils at Septic Tank hole and failed old Septic drainfield trench eliminate lower gravel bed repair. Suitable conventional soils found at Highland near test hole B. Septic Tank replacement OK & cover 10/10/96 ^{RJP}

10/17/96 TRENCH/TANKS OK TO COVER; HOLD FOR PUMP INSP (MR)

12/11/99 No ^{septic} pump test performed as of this date - file indexed but not

DATE SYSTEM APPROVED Just Date INSPECTOR 2/25/04 approved AWR

2/25/04 Pump ~~test~~ Alarm tests OK.

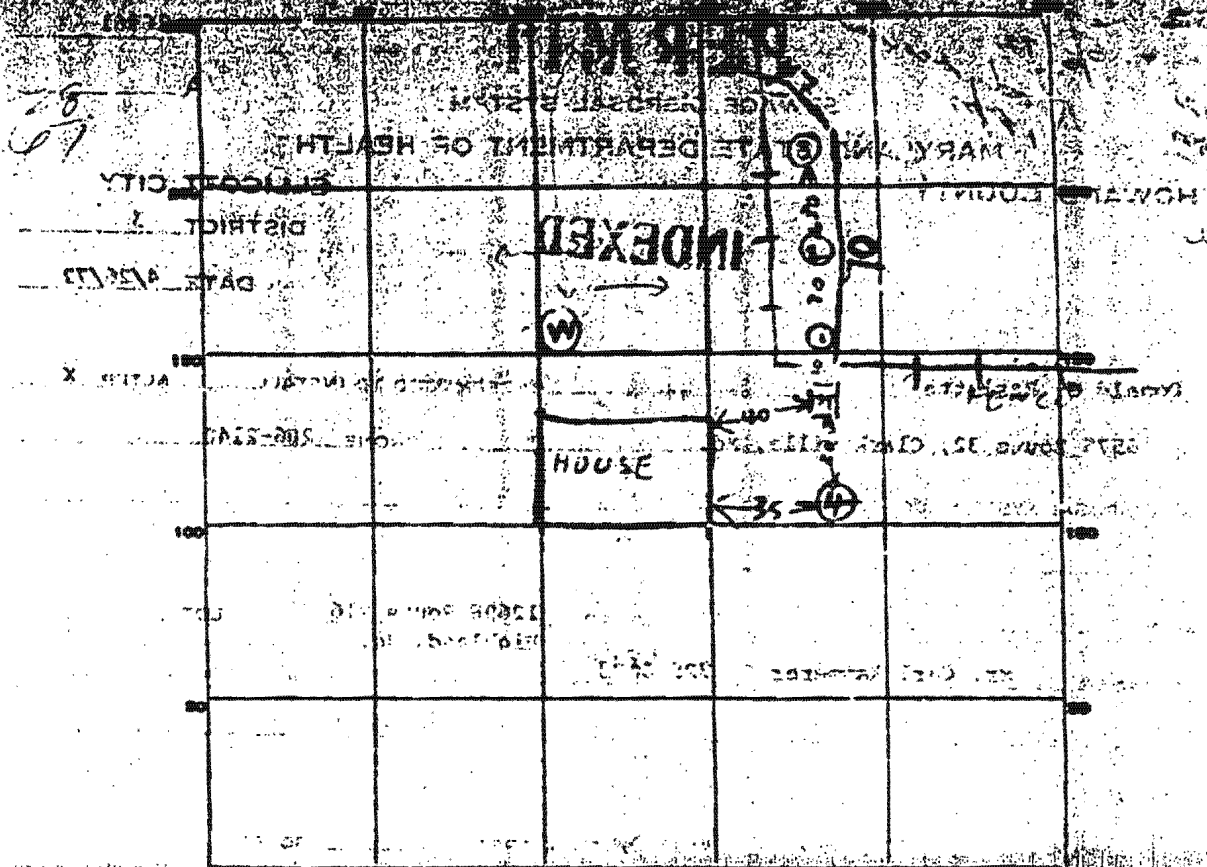

INDICATE NORTH - NAME ADJOINING ROADWAY AS BASE LINE.

PERMIT CARD _____

SEPTIC TANK LEVEL Old car used CLEANOUTS _____

DISTRIBUTION BOX LEVEL _____

TILE FIELD, DEPTH 3 FT. TRENCH WIDTH 3 FT.

GRAVEL DEPTH 12 IN. TOTAL LENGTH 117 FT.

NUMBER OF TRENCHES 1 TOTAL BOTTOM AREA 35

SEEPAGE PITS, INSIDE DIAMETER _____ FT. DEPTH BELOW INLET _____ FT.

ABSORBENT AREA _____ SQ. FT.

REMARKS 5/2/72 - Hold 7 FT deep All Fall Undergrnd Water TRENCHES
Hold 2 - 3 FT deep Clay sand max Hold 3 - 7 FT deep Clay sand max Undergrnd
with 4 FT of gravel (10' by 6' 7' deep) All moist clay
Ground unsat. refractory for after 5 water at level
5/2/72 - 70 FT of ditch dug 3 FT wide
OK. Put stones & cover part of ditch when needed
5/3/72 Not completed R.T.