

PUB. SEWER STATUS VERIFIED BY _____

ISSUE DATE: 11/17/08

PERMIT

P 529597

APPROVAL DATE: 1/27/09

A REPAIR

Tax ID # 05377528

ON-SITE SEWAGE DISPOSAL SYSTEM HOWARD COUNTY HEALTH DEPARTMENT BUREAU OF ENVIRONMENTAL HEALTH

Fogle's Septic Clean IS PERMITTED TO INSTALL ALTER

ADDRESS: 580 Obrecht Rd. PHONE NUMBER: 410-795-5670

SUBDIVISION: _____ LOT NUMBER: _____

ADDRESS: 13516 Argo Drive PROPERTY OWNER: Schannie

SEPTIC TANK CAPACITY (GALLONS): 2000

PUMP CHAMBER CAPACITY (GALLONS): —

NUMBER OF BEDROOMS: 4

SQUARE FEET PER BEDROOM: _____

LINEAR FEET OF TRENCH REQUIRED: 168

TRENCHES:	Contractor to install 3x55' trenches on contour. Trenches to be 3' wide, inlet varying from 18" - 2' below grade, bottoms at 3'.
LOCATION:	Trench locations to be determined in field at time of Layout inspection.
ADDITIONAL NOTES:	Septic tank may be upgraded to a 2000g tank size if under homeowner's approval to do so in lieu of a possible addition. If so, a 20' setback to proposed additions will need to be maintained for bp approval.

PLANS APPROVED: Kevin Wolf DATE: 10/23/2008

- NOTE: PERMIT VOID AFTER 2 YEARS
- NOTE: CONTRACTOR RESPONSIBLE FOR SCHEDULING A PRE-CONSTRUCTION INSPECTION FOR ALL INSTALLATIONS
- NOTE: WATERTIGHT SEPTIC TANKS REQUIRED
- NOTE: ALL PARTS OF SEPTIC SYSTEM SHALL BE 100 FEET FROM ANY WATER WELL
- NOTE: MANHOLE RISERS REQUIRED ON ALL SEPTIC TANKS AND PUMP CHAMBERS

NEITHER THE HOWARD COUNTY COUNCIL OR THE HEALTH DEPARTMENT IS RESPONSIBLE FOR THE SUCCESSFUL OPERATION OF ANY SYSTEM PERMITTEE RESPONSIBLE FOR OBTAINING FINAL APPROVAL ON THIS PERMIT CALL 410-313-1771 FOR INSPECTION OF SEPTIC SYSTEM

NOT TO SCALE

See As-Built
Drawing On Separate
Sheet

TRENCH/DRAINFIELD DATA

WIDTH	INLET	BOTTOM
3'	18"-3'	3'-4'
NUMBER OF TRENCHES 3		
TOTAL LENGTH 165'		
ABSORPTION AREA 495 + 8w'		
DISTRIBUTION BOX LEVEL Levelers		
DISTRIBUTION BOX BAFFLE Yes		
DISTRIBUTION BOX PORT Yes		

SEPTIC TANK DATA

SEPTIC TANK 1 LEVEL	Yes
MANUFACTURER	Bylon
CAPACITY	2000 GAL
SEAM LOC	Top
TANK LID DEPTH	2'
BAFFLES	Yes
BAFFLE FILTER	
MANHOLE LOC	Front/Rear
6" PORT LOC	none
WATERTIGHT TEST	
SLOTTED	Yes
PUMP/SEPTIC TANK LEVEL	
MANUFACTURER	
CAPACITY GAL	
SEAM LOC	
TANK LID DEPTH	
BAFFLES	
BAFFLE FILTER	
MANHOLE LOC	
6" PORT LOC	
WATERTIGHT TEST	
SLOTTED	

PRE-CONSTRUCTION

11/14/08 Install
three 55' trenches
on contour just
below perc test

hole A. Start the trenches close to the metal shed. The
property line is 70' from the shed. Install a new tank
outside of the 100' well radius. Pump out and abandon
INSTALLATION the old tank and the drywell (BB)

12/3/08 All system components installed per design. Finishing up
last trench row. Top trench inlet @ 3' bottom 4'. reed
2 trenches inlet @ 18" bottom @ 3'. OK to cover all work
when finished. (SW) Ex S.T. and D.W. pumped and collapsed.

FINAL INSPECTOR

K. Wall

DATE OF APPROVAL

1/27/09

H0-73-1641

50' 72'

13516
Argo Drive

← 22' →

42' 35'



6'

4'

89'

91'

100'

132'

90'

39'

55'

5'

9' BTE

55'

11'


9' BTE

55'

21'

Metal
Shed

NOT TO SCALE

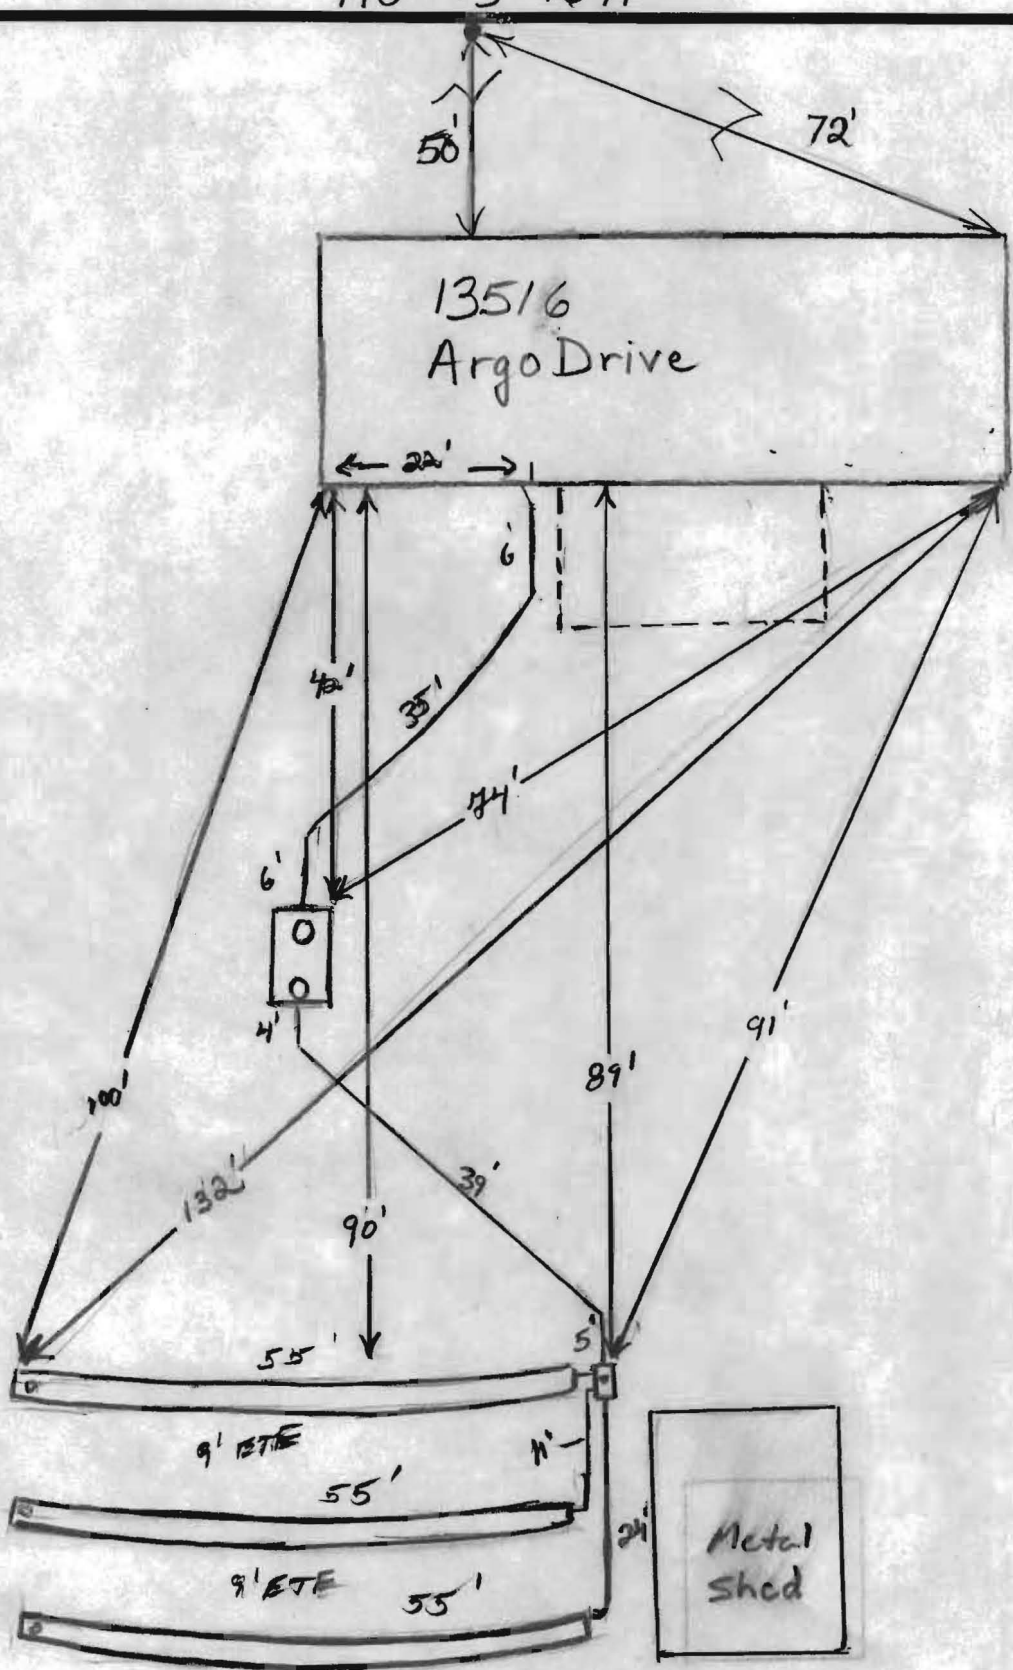

CONSUMER INFORMATION NOTES:

1. This plan is a benefit to a consumer insofar as it is required by a lender or a title insurance company or its agent in connection with contemplated transfer, financing or re-financing.
2. This plan is not to be relied upon for the establishment or location of fences, garages, buildings, or other existing or future improvements.
3. This plan does not provide for the accurate identification of property boundary lines, but such identification may not be required for the transfer of title or securing financing or re-financing.
4. Building line and/or Flood Zone information is taken from available sources and is subject to interpretation of originator.

Notes:

- 1) Flood zone "C" per H.U.D. panel No. 240044-0026B
- 2) Setback distances as shown to the principal structure from property lines are approximate. The level of accuracy for this drawing should be taken to be no greater than plus or minus 1 Foot.

N/F
J.V.BISHOP
559/496

N/F
B.M.COOK
327/216

N 01°49'14" E
17.31

N 81°49'44" E
217.14

75' Front
20' Rear
20' Sides

LOT 12

64,066.5 ±

Maggie
Gregg
Schanne
LOT 13
21036
301-596-9637

N 46°11'40" W

458.49

SEPTIC AREA

OPEN METAL SHED

Prop. Future Garage

30x40

LOT 11

wh

S 34°52'40" E

354.58



CONC. WALK

FRAME DECK

64.2

SPLIT LEVEL BRICK & FRAME # 13516

23.1

16.0

CONC. PORCH

CONC. WALK

GRAVEL D/W

85.7

WELL

73-1641

75' B.R.L.

100'

LOCATION DRAWING

LOT 12, BLOCK C

LINDEN CHAPEL HILLS

(SECTION 4)

HOWARD COUNTY, MARYLAND

A=115.09

R=582.68

ARGO DRIVE

(50' R/W)

SURVEYOR'S CERTIFICATE

"THE INFORMATION SHOWN HEREON HAS BEEN BASED UPON THE RESULTS OF A FIELD INSPECTION PURSUANT TO THE DEED OR PLAT OF RECORD. EXISTING STRUCTURES SHOWN HAVE BEEN FIELD LOCATED BASED UPON MEASUREMENTS FROM PROPERTY MARKERS FOUND OR FROM EVIDENCE OF LINES OF APPARENT OCCUPATION."

Jeffrey A. Foster
MARYLAND PROPERTY LINE SURVEYOR REG. NO. 587

REFERENCES

PLAT BK.
PLAT NO. 3329
LIBER
FOLIO



SNIDER & ASSOCIATES
SURVEYORS - ENGINEERS
LAND PLANNING CONSULTANTS
2 Professional Drive, Suite 216
Gaithersburg, Maryland 20879
301/948-5100, Fax 301/948-1288

DATE OF LOCATIONS	SCALE: 1" = 50'
WALL CHECK:	DRAWN BY: E.M.G.
HSE. LOC.: 02-11-02	JOB NO.: 2002-0583