

02-325241

B 1	1937	SEQUENCE NO. (MDE USE ONLY)	STATE OF MARYLAND APPLICATION FOR PERMIT TO DRILL WELL 533280 please type	STATE PERMIT NUMBER HO-95-1926 fill in this form completely
-----	------	-----------------------------	---	---

**OWNER INFORMATION**

Date Received (APA) 6/7/2010

8 MM DD YY 13

15 Last Name Wirth Owner Kary J. First Name 34

36 Street or RFD 10233 Glastonbury Rd 55

57 Town Ellicott City Md 70 State Md 72 Zip 21042 76

**LOCATION OF WELL**

B 3

8 COUNTY Howard 21

23 SUBDIVISION Burleigh Manor 42

SECTION 3 44 46 LOT 408 48 50

52 NEAREST TOWN Ellicott City 71

MILES FROM TOWN (enter 0 if in town) 0 73 M I 76 77 78

**DRILLER INFORMATION**

Driller's Name Marshal Arnette M S D 106 76 License No. 81

Firm Name Alled Environmental Services

Address PO Box 1242, Millersville, Md 21108

Signature Marshal Arnette Date 6/13/10

**WELL LOCATION**

B 4

1 2 DIRECTION OF WELL FROM TOWN (CIRCLE BOX)

11 NEAR WHAT ROAD 10233 Glastonbury Rd 30

ON WHICH SIDE OF ROAD (CIRCLE APPROPRIATE BOX)

34 125 37 DISTANCE FROM ROAD

ENTER FT OR MI 38 39

TAX MAP: 24 BLK: 13 PARCEL 766

**WELL INFORMATION**

B 2

APPROX. PUMPING RATE (GAL. PER MIN.) 8 12

AVERAGE DAILY QUANTITY NEEDED (GAL. PER DAY) 14 20

**USE FOR WATER (CIRCLE APPROPRIATE BOX)**

D DOMESTIC POTABLE SUPPLY & RESIDENTIAL IRRIGATION

F FARMING (LIVESTOCK WATERING & AGRICULTURAL IRRIGATION)

I INDUSTRIAL, COMMERCIAL, DEWATERING

P PUBLIC WATER SUPPLY WELL

T TEST, OBSERVATION, MONITORING

G GEO-THERMAL 2 Closed Loops

**NOT TO BE FILLED IN BY DRILLER HEALTH DEPARTMENT APPROVAL**

Howard (13) Public

COUNTY NAME COUNTY NO.

STATE SIGNATURE \_\_\_\_\_ INSERT S → 41

DATE ISSUED 6/18/2010 Brian Baker 6/18/2011

43 MM DD YY 48 CO SIGNATURE EXP. DATE

NORTH GRID 520 000 EAST GRID 838 000

50 55 57 63

APPROXIMATE DEPTH OF WELL 300 FEET 24 28

APPROXIMATE DIAMETER OF WELL 6 INCH 30 37

**METHOD OF DRILLING (circle one)**

BORED (or Augered) JETTED Jetted & DRIVEN

30 AIR-ROTary AIR-PERcussion ROTARY (Hydraulic Rotary)

37 CABLE REverse-ROTary DRive-POINT

other \_\_\_\_\_

**REPLACEMENT OR DEEPEMED WELLS (CIRCLE APPROPRIATE BOX)**

N THIS WELL WILL NOT REPLACE AN EXISTING WELL

Y THIS WELL WILL REPLACE A WELL THAT WILL BE ABANDONED AND SEALED

S THIS WELL WILL REPLACE A WELL THAT WILL BE USED AS A STANDBY-CONTACT LOCAL APPROVING AUTHORITY FOR POLICY ON STANDBY WELLS

D THIS WELL WILL DEEPEM AN EXISTING WELL

PERMIT NUMBER OF WELL TO BE REPLACED OR DEEPEMED (IF AVAILABLE) 41 \_\_\_\_\_ 52

**Not to be filled in by driller (MDE OR COUNTY USE ONLY)**

APPROP. PERMIT NUMBER \_\_\_\_\_ G \_\_\_\_\_

PERMIT No. HO-95-1926

70 71 72 73 74 75 76 77 78 79

SHOW MAJOR FEATURES OF BOX & LOCATE WELL WITH AN X

SOURCES OF DRILLING WATER

1. Driller Well
- 2.
- 3.

WRITE THE BOX NUMBER X FROM THE MAP HERE

E 630 838

N 520

000 000


DRAW A SKETCH BELOW SHOWING LOCATION OF WELL IN RELATION TO NEARBY TOWNS AND ROADS AND GIVE DISTANCE FROM WELL TO NEAREST ROAD JUNCTION

**SPECIAL CONDITIONS**

NOTE: APPROVING AUTHORITIES SHOULD USE SUPPLEMENTARY SHEET IF NEEDED

When Starting Drout Tremie Pipe Must Be Near Bottom of Borehole

# ALLIED WELL DRILLING SITE PLAN

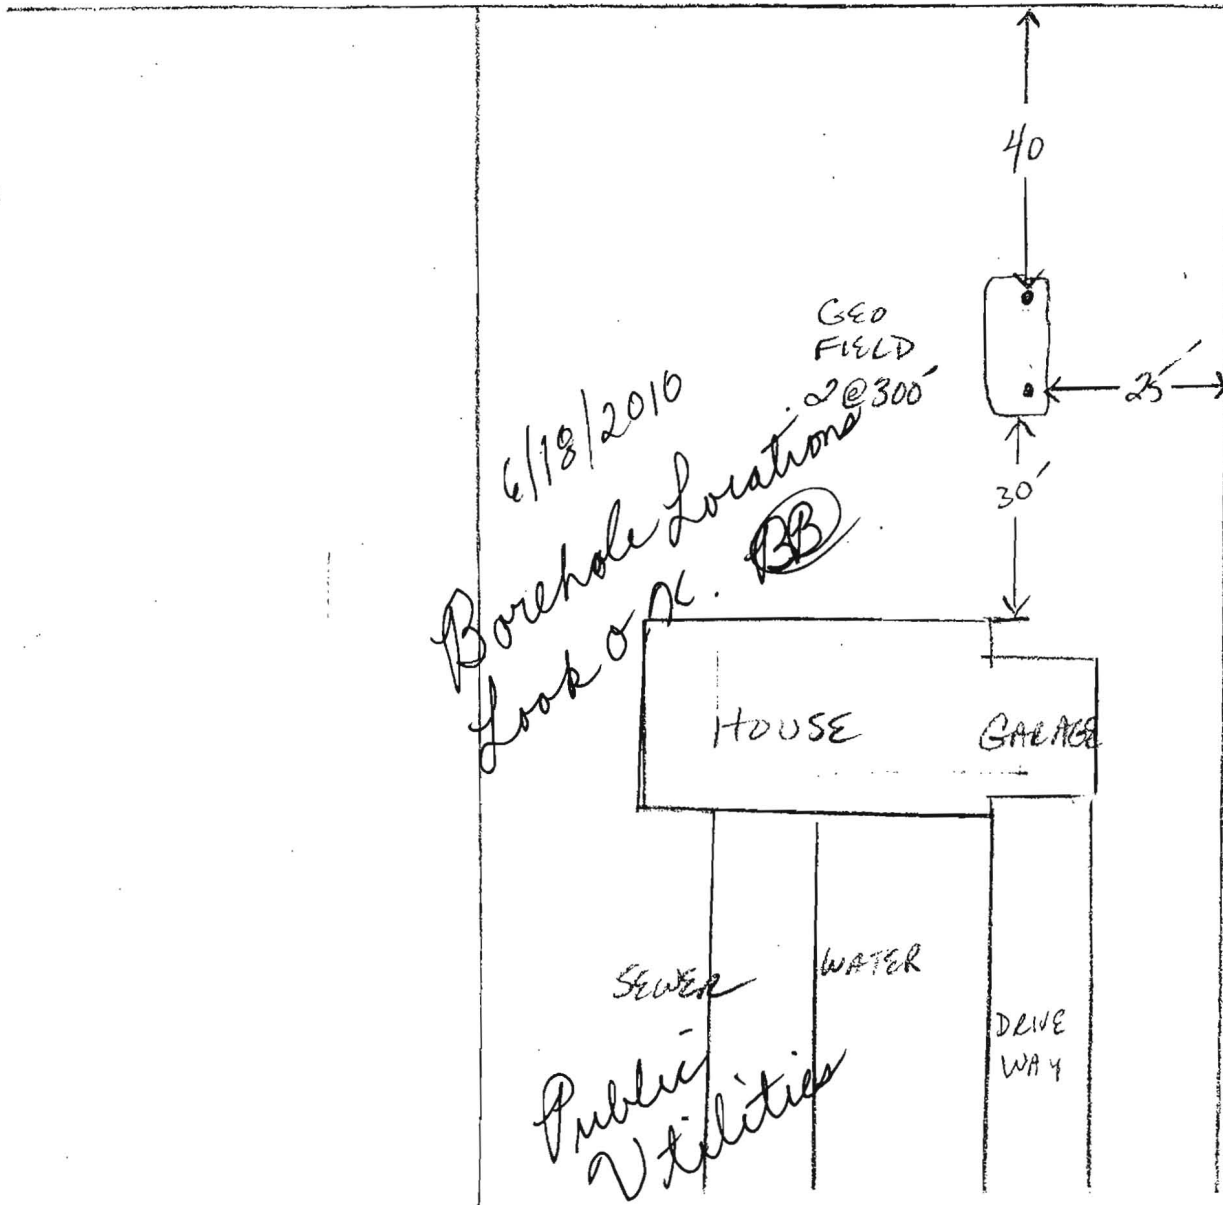

NEIGHBORING TAG #'S: \_\_\_\_\_

DISTANCE FROM HOUSE: 30 TREES NEARBY: \_\_\_\_\_  
 FROM SEPTIC: N/A UTILITY ISSUES: \_\_\_\_\_  
 FROM SEWER: 50+ MATS NECESSARY: \_\_\_\_\_  
 FROM PROPERTY LINE: 25 ACCESS FOR H/U: \_\_\_\_\_  
 FROM STREET: \_\_\_\_\_  
 COMMENTS: \_\_\_\_\_

PERSON COMPLETING FORM: SANTLY - ATTACHED