
WATER WELL ABANDONMENT-SEALING REPORT FORM

SUBMIT COPIES OF COMPLETED FORM TO:

- * COUNTY ENVIRONMENTAL AGENCY (contact MDE, WMA if address needed)
- * WELL OWNER
- * MDE, WATER MANAGEMENT ADMINISTRATION, WELL PROGRAM

OK
5/27/15 SC

DATE WELL ABANDONED: Feb 24 2015 (month/day/year)

* PERMIT NUMBER OF ABANDONED WELL (if any) N/A

* PERMIT NUMBER OF REPLACEMENT WELL: N/A


* PERSON ABANDONING WELL: Ralph E. Mayne WELL DRILLER'S LICENSE NUMBER: 117

CIRCLE: MWD / MSD / MGD

* OWNER'S NAME: Daniel Bertram Berman

* WELL LOCATION:
COUNTY: Howard
NEAREST TOWN: Woodstock 21163
TAX MAP BLOCK PARCEL
SUBDIVISION:
SECTION: N/A LOT: N/A
STREET ADDRESS: 10344 Rt. 99

SITE LOCATION MAP

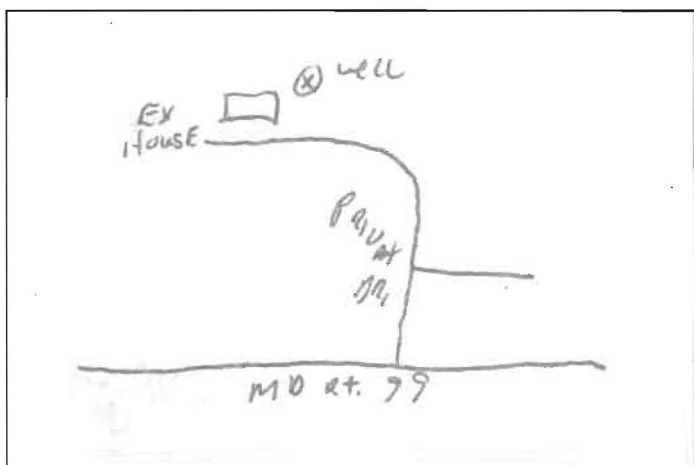

LATITUDE 3 9 . 3 1 6 2 7 -
LONGITUDE 7 6 . 8 6 1 8 2 -

* TYPE OF WELL BEING ABANDONED:
 DRILLED JETTED
 BORED HAND DUG
 OTHER (specify)

LOG OF SEALING MATERIAL

* USE CODE: DOMESTIC
 IRRIGATION MUNICIPAL/PUBLIC
 TEST/OBSERVATION INDUSTRIAL
 GEOTHERMAL

* TYPE OF CASING:
 STEEL PLASTIC
 CONCRETE OTHER (specify)

SIZE OF CASING: 6" INCHES IN DIAMETER

DEPTH OF WELL: 39 FEET DEEP

WAS ANY CASING REMOVED? YES NO
If yes, length removed, in feet:

WAS CASING RIPPED OR PERFORATED? YES NO

| MATERIAL | FEET | |
|-------------------------|----------|-----------|
| | FROM | TO |
| <u>Cement.</u> | <u>6</u> | <u>39</u> |
| VOLUME OF MATERIAL USED | | |
| <u>11 BAGS Cement.</u> | | |

