

PUB. SEWER STATUS VERIFIED BY MR

ISSUE DATE: 4/7/2004

PERMIT

P 520139 - A
UPGRADE
A ~~REPAIR~~

APPROVAL DATE: 4/9/04

ON-SITE SEWAGE DISPOSAL SYSTEM HOWARD COUNTY HEALTH DEPARTMENT BUREAU OF ENVIRONMENTAL HEALTH

Hatfields Equipment IS PERMITTED TO INSTALL ALTER

ADDRESS: 13785 Burntwoods Rd, Glenelg PHONE NUMBER: 301-854-6172

SUBDIVISION: _____ LOT NUMBER: _____

ADDRESS: 10390 Baltimore National Pike PROPERTY OWNER: ~~Norman Udoff~~

SEPTIC TANK CAPACITY (GALLONS): 1000 Glenn Mullinix

PUMP CHAMBER CAPACITY (GALLONS): —

NUMBER OF BEDROOMS: MAX 5 EMPL.

SQUARE FEET PER BEDROOM: —

LINEAR FEET OF TRENCH REQUIRED: —

TRENCHES:	Trench to be _____ feet wide. Inlet _____ feet below original grade. Bottom maximum depth _____ feet below original grade. Effective area begins at _____ feet below original grade. _____ feet of stone below distribution pipe.
LOCATION:	<u>Install tank, connect to ex. dry well.</u> <u>No other drainfield req'd</u>
PURPOSE:	To replace steel tank and evaluate existing dry well. Call for inspection when ground is opened so sanitarian can recommend repair. <u>Issued pursuant to NCU 04-001</u>

PLANS APPROVED: MR DATE: _____


- NOTE: PERMIT VOID AFTER 2 YEARS
- NOTE: CONTRACTOR RESPONSIBLE FOR SCHEDULING A PRE-CONSTRUCTION INSPECTION FOR ALL INSTALLATIONS
- NOTE: WATERTIGHT SEPTIC TANKS REQUIRED
- NOTE: ALL PARTS OF SEPTIC SYSTEM SHALL BE 100 FEET FROM ANY WATER WELL
- NOTE: MANHOLE RISERS REQUIRED ON ALL SEPTIC TANKS AND PUMP CHAMBERS

NEITHER THE HOWARD COUNTY COUNCIL OR THE HEALTH DEPARTMENT IS RESPONSIBLE FOR THE SUCCESSFUL OPERATION OF ANY SYSTEM PERMITTEE RESPONSIBLE FOR OBTAINING FINAL APPROVAL ON THIS PERMIT CALL 410-313-2640 FOR INSPECTION OF SEPTIC SYSTEM

COMMERCIAL

P 520139-A

NOT TO SCALE

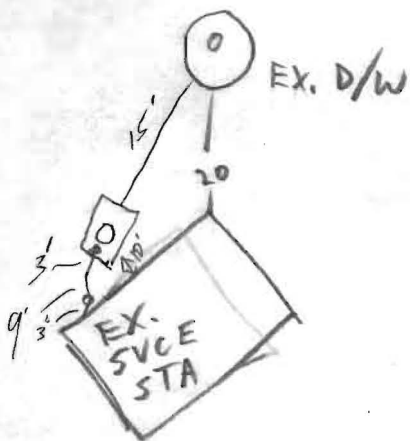

COMMON DRIVE

RT. 40

ROAD

TRENCH/DRAINFIELD DATA

WIDTH	INLET	BOTTOM
_____	_____	_____
NUMBER OF TRENCHES _____		
TOTAL LENGTH _____		
ABSORPTION AREA _____		
DISTRIBUTION BOX LEVEL _____		
DISTRIBUTION BOX BAFFLE _____		
DISTRIBUTION BOX PORT _____		

SEPTIC TANK DATA

SEPTIC TANK 1 LEVEL

CAPACITY 1000 GAL

SEAM LOC Top

TANK LID DEPTH 2'

BAFFLES

BAFFLE FILTER _____

MANHOLE LOC Center

6" PORT LOC From

WATERTIGHT TEST _____

SEPTIC TANK 2 LEVEL _____

CAPACITY _____ GAL

SEAM LOC _____

TANK LID DEPTH _____

BAFFLES N/A

BAFFLE FILTER _____

MANHOLE LOC _____

6" PORT LOC _____


WATERTIGHT TEST _____

PRE-CONSTRUCTION 4/8/04 EX. D/W ~ 10' DEEP; OK TO INSTALL TK. (MR)

INSTALLATION 4/9/04 Tank set, Building & D.W. connections made (SC)

FINAL INSPECTOR [Signature] DATE OF APPROVAL 4/9/04

COMMERCIAL

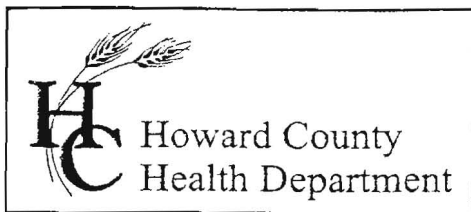

3525 H Ellicott Mills Drive, Ellicott City, MD 21043
(410) 313-2640 Fax (410) 313-2648
TDD (410) 313-2323 Toll Free 1-866-313-6300
website: www.hchealth.org

Penny E. Borenstein, M.D., M.P.H., Health Officer

March 17, 2004

TO: George Beisser, Chief
Public Service and Zoning Administration

FROM: Mark Rifkin (MR)
Well and Septic Program
Aaron Busch (AB)
Community Services Program

RE: File Number: NCU 04-001
Title: Glenn Mullinix

The Health Department has identified significant concerns that should be addressed prior to approval. These issues are listed below:

1. All currently unused storage tanks on the property are to be removed. In order to accomplish this, apply for a building permit, contact MDE to oversee the removals and contact this office after removal.
2. The well on the property must be tested for possible Volatile Organic Compound contamination. This is a requirement regardless of the status of the well as a potable supply.
3. We agree with your proposal to connect to the city water supply; please contact us when this connection is made.
4. Since the existing septic system is believed to date from original building construction, the existing septic system must be inspected and/or replaced. If the system is determined to be unacceptable, repairs or replacement will be necessary.
5. Disclosure of storage locations for all oil and solvents being stored on the property. Holding tanks may need to be utilized as discharge containment.

cc: Glenn A. Mullinix