




SITE INSPECTION SHEET

OWNER: \_\_\_\_\_ PHONE #: \_\_\_\_\_  
ADDRESS: 15312 Doe Hill Ct CONTRACTOR: Easterday  
WELL TAG #: \_\_\_\_\_  
SUBDIVISION: \_\_\_\_\_ LOT: \_\_\_\_\_ COUNTY #: 13  
PROPOSAL: Water Quality Issues

LOCATION DIAGRAM ↑

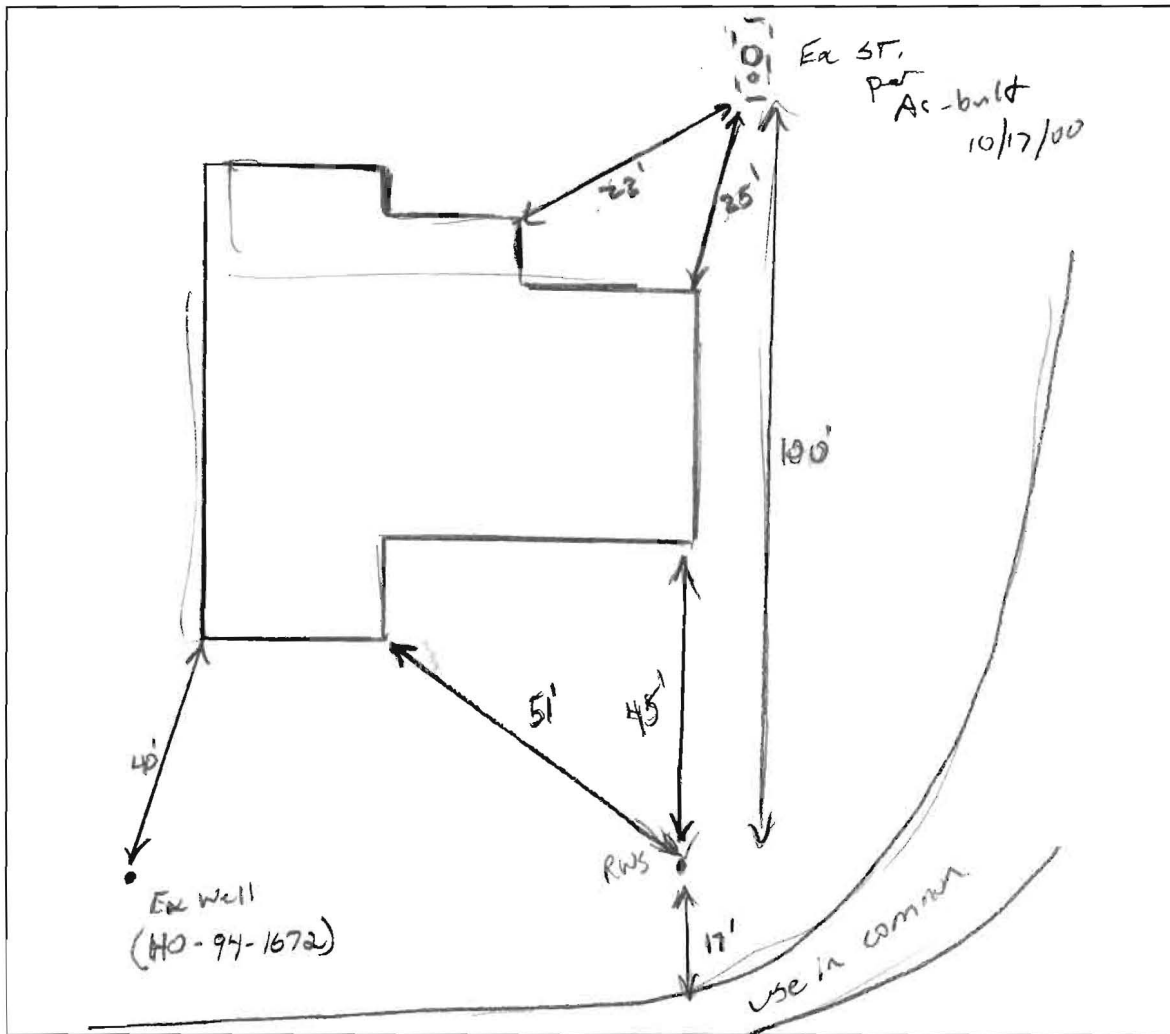

COMMENTS: \_\_\_\_\_  
1/20/15 RWS approved. Ex well may be reworked. Owner states sediment issues w/ under. Driller requested completion report for adjacent tests

DATE: 1/20/15 INSPECTOR: KW/SC