

C1 06614

SEQUENCE NO. (MDE USE ONLY) 49

STATE OF MARYLAND WELL COMPLETION REPORT

FILL IN THIS FORM COMPLETELY PLEASE PRINT OR TYPE

THIS REPORT MUST BE SUBMITTED WITHIN 45 DAYS AFTER WELL IS COMPLETED.

(THIS NUMBER IS TO BE PUNCHED IN COLS. 3-6 ON ALL CARDS)

COUNTY NUMBER A49410

ST/CO USE ONLY. DATE RECEIVED

DATE WELL COMPLETED 7/22/99

Depth of Well 2280

PERMIT NO. FROM "PERMIT TO DRILL WELL" HO-99-2278

OWNER Scheidt Susan, STREET OR RFD Paternal Gift Dr, TOWN Highland, SUBDIVISION Paternal Gift Farm, SECTION, LOT 9

WELL LOG table with columns: DESCRIPTION, FEET (FROM, TO), check if water bearing. Includes entries for Top Soil, Sand & Clay, Mica, Sand Silt, Sand Stone, etc.

GROUTING RECORD form including: WELL HAS BEEN GROUTED (Y), TYPE OF GROUTING MATERIAL (CM, BC), NO. OF BAGS (26), NO. OF POUNDS (2600), GALLONS OF WATER (156), DEPTH OF GROUT SEAL (0 to 78 ft).

CASING RECORD form including: casing types (ST, CO, PL, OT), MAIN CASING TYPE (ST), Nominal diameter (06), Total depth (92).

OTHER CASING (if used) section with diameter and depth fields.

SCREEN RECORD form including: screen type (ST, BR, HO), insert appropriate code below.

WELL HYDROFRACTURED: YES (Y), NO (N)

- CIRCLE APPROPRIATE LETTER: A (well abandoned), E (electric log), P (test well converted to production)

I HEREBY CERTIFY THAT THIS WELL HAS BEEN CONSTRUCTED IN ACCORDANCE WITH COMAR 26.04.04 "WELL CONSTRUCTION" AND IN CONFORMANCE WITH ALL CONDITIONS STATED IN THE ABOVE CAPTIONED PERMIT...

DRILLERS LIC. NO. 1 MWD 040, DRILLERS SIGNATURE: George F. Eastenlong

SITE SUPERVISOR (sign. of driller or journeyman responsible for sitework if different from permittee) Charles A. Foster


DEPTH (nearest ft.) HO 70 - 280, E A C H S R E E N, SLOT SIZE 1, 2, 3, DIAMETER OF SCREEN (56, 60), from to

GRAVEL PACK IF WELL DRILLED WAS FLOWING WELL INSERT F IN BOX 68

MDE USE ONLY (NOT TO BE FILLED IN BY DRILLER) T (E.R.O.S.) W O, TELESCOPE CASING, LOG INDICATOR, OTHER DATA

PUMPING TEST form including: HOURS PUMPED (3), PUMPING RATE (10 gal. per min.), METHOD USED TO MEASURE PUMPING RATE (Bucket), WATER LEVEL (32 ft. before, 138 ft. when pumping), TYPE OF PUMP USED (S - submersible)

PUMP INSTALLED form including: DRILLER WILL INSTALL PUMP (NO), TYPE OF PUMP INSTALLED (S), CAPACITY: GALLONS PER MINUTE (31, 35), PUMP HORSE POWER (37, 41), PUMP COLUMN LENGTH (43, 47), CASING HEIGHT (+ above, - below)

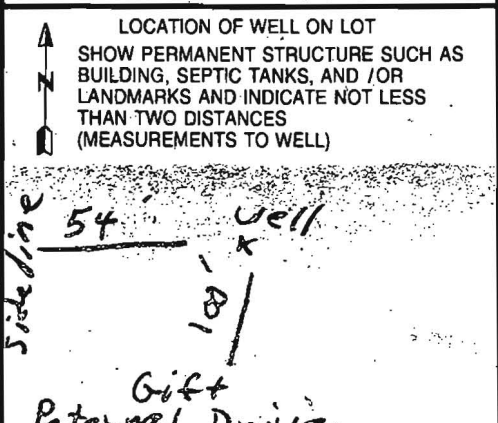

B 1 16301

SEQUENCE NO. (MDE USE ONLY)

STATE OF MARYLAND PERMIT TO DRILL WELL please print or type

STATE PERMIT NUMBER

HO-94-2278

Date Received (APA) 6/17/99

OWNER INFORMATION RN 7890


B 3 HOWARD LOCATION OF WELL CCM

Scheidt Susan 12730 Hall Shop Highland, Md. 20777

Paternal Gift Farm Highland

DRILLER INFORMATION

George F. Easterday L. Franklin Easterday, Inc. 9265 Brown Church Rd. MT. Airv. Md. 21771

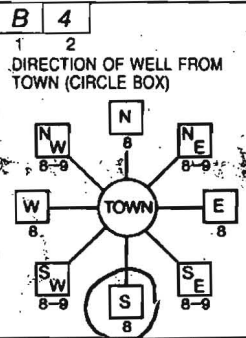

Paternal Gift Drive ON WHICH SIDE OF ROAD (CIRCLE APPROPRIATE BOX) DISTANCE FROM ROAD 100 Ft. TAX MAP: 40 BLK: 10 PARCEL: 90

B 2 WELL INFORMATION APPROX. PUMPING RATE 5 GAL. PER MIN. AVERAGE DAILY QUANTITY NEEDED 500 GAL. PER DAY

- USE FOR WATER (CIRCLE APPROPRIATE BOX) D DOMESTIC POTABLE SUPPLY & RESIDENTIAL IRRIGATION

NOT TO BE FILLED IN BY DRILLER HEALTH DEPARTMENT APPROVAL Howard A49410

APPROXIMATE DEPTH OF WELL 300 FEET

APPROXIMATE DIAMETER OF WELL 6 INCH

METHOD OF DRILLING (circle one) BORED (or Augered) AIR-PerCussion ROTARY (Hydraulic Rotary)

SHOW MAJOR FEATURES OF BOX & LOCATE WELL WITH AN X SOURCES OF DRILLING WATER 1. wells 2. 3. WRITE THE BOX NUMBER FROM THE MAP HERE E 810 N 4809

REPLACEMENT OR DEEPEMED WELLS (CIRCLE APPROPRIATE BOX) N THIS WELL WILL NOT REPLACE AN EXISTING WELL

Not to be filled in by driller (MDE OR COUNTY USE ONLY) APPROX. PERMIT NUMBER H096 GAP 007 PERMIT No. HO-94-2278

