

PUBLIC SEWER STATUS VERIFIED BY

ISSUE DATE: \_\_\_\_\_

# PERMIT

P 535154

APPROVAL DATE: 9/12/2011

A REPAIR

## Septic Repair 5406846 ON-SITE SEWAGE DISPOSAL SYSTEM HOWARD COUNTY HEALTH DEPARTMENT BUREAU OF ENVIRONMENTAL HEALTH

FOGLE'S SEPTIC CLEAN, INC. \_\_\_\_\_ IS PERMITTED TO INSTALL  ALTER

ADDRESS: 580 OBRECHT ROAD, SYKESVILLE 21784 PHONE NUMBER: 410-795-5670

SUBDIVISION: WATERMAN ESTATES LOT NUMBER: 1

ADDRESS: 12463 PETRILLO DRIVE PROPERTY OWNER: MARZIE HEID

SEPTIC TANK CAPACITY (GALLONS): N/A Trenches 3' Wide 7-75' Trenches

PUMP CHAMBER CAPACITY (GALLONS): \_\_\_\_\_ Inlet 5'

NUMBER OF BEDROOMS: 6 Bottom 7.5'-8.5'

SQUARE FEET OF HOUSE: \_\_\_\_\_ Bottom Depth to Vary

LINEAR FEET OF TRENCH REQUIRED: 525' With Elevation/Distance to Water Table

TRENCHES:	
LOCATION:	
PURPOSE:	REPAIR/REPLACE FAILING SEPTIC SYSTEM.

PLANS APPROVED: \_\_\_\_\_ DATE: \_\_\_\_\_

- NOTE: PERMIT VOID AFTER 2 YEARS
- NOTE: CONTRACTOR RESPONSIBLE FOR SCHEDULING A PRE-CONSTRUCTION INSPECTION FOR ALL INSTALLATIONS
- NOTE: WATERTIGHT SEPTIC TANKS REQUIRED
- NOTE: ALL PARTS OF SEPTIC SYSTEM SHALL BE 100 FEET FROM ANY WATER WELL
- NOTE: MANHOLE RISERS REQUIRED ON ALL SEPTIC TANKS AND PUMP CHAMBERS
- NOTE: AN ELECTRICAL PERMIT IS REQUIRED FOR INSTALLATION OF ANY ELECTRICAL COMPONENTS OF THE SYSTEM


**NEITHER THE HOWARD COUNTY COUNCIL OR THE HEALTH DEPARTMENT IS RESPONSIBLE FOR THE SUCCESSFUL OPERATION OF ANY SYSTEM PERMITTEE RESPONSIBLE FOR OBTAINING FINAL APPROVAL ON THIS PERMIT CALL 410-313-1771 FOR INSPECTION OF SEPTIC SYSTEM**

40

NOT TO SCALE

TRENCH/DRAINFIELD DATA

WIDTH 3' INLET 4.5'-5' BOTTOM 7.5'-8.5'  
 NUMBER OF TRENCHES 6  
 TOTAL LENGTH 522+  
 ABSORPTION AREA >1566+Sidewall  
 DISTRIBUTION BOX LEVEL Levelers  
 DISTRIBUTION BOX BAFFLE Yes  
 DISTRIBUTION BOX PORT Yes

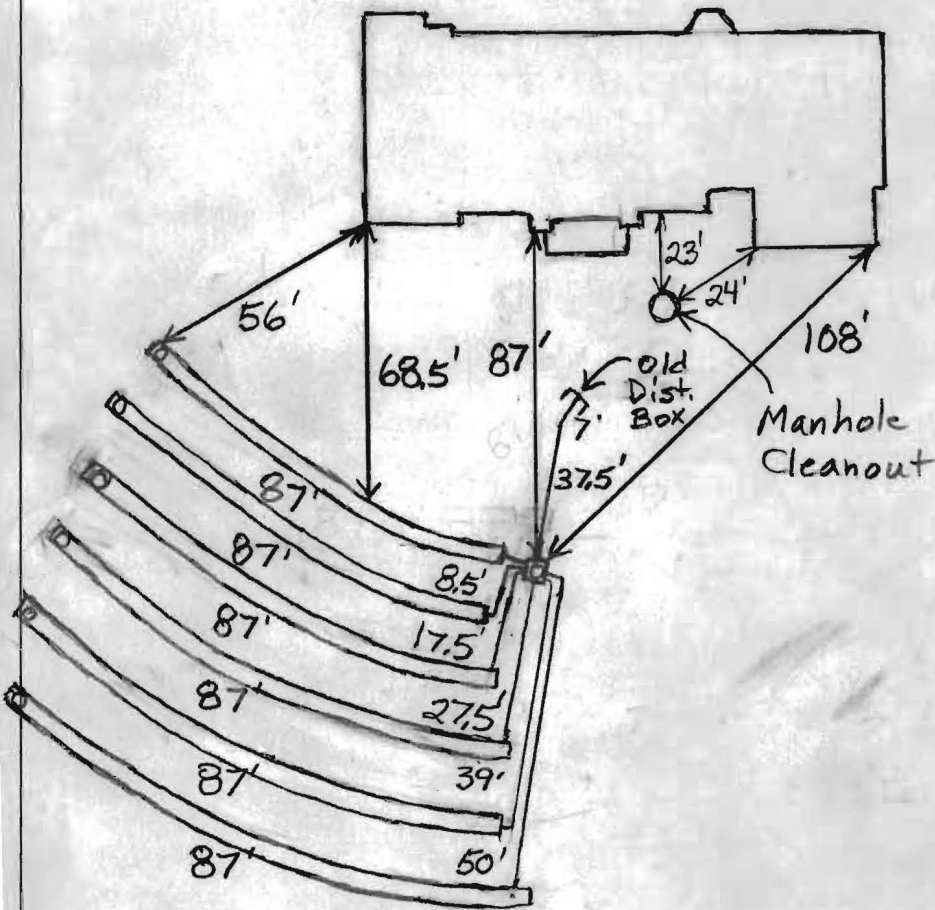

SEPTIC TANK DATA

~~SEPTIC TANK I LEVEL \_\_\_\_\_  
 MANUFACTURER \_\_\_\_\_  
 CAPACITY \_\_\_\_\_ GAL  
 SEAM LOC \_\_\_\_\_  
 TANK LID DEPTH \_\_\_\_\_  
 BAFFLES \_\_\_\_\_  
 BAFFLE FILTER \_\_\_\_\_  
 MANHOLE LOC \_\_\_\_\_  
 6" PORT LOC \_\_\_\_\_  
 WATERTIGHT TEST \_\_\_\_\_  
 SLOTTED \_\_\_\_\_  
 DATE ON LID \_\_\_\_\_  
 PUMP/SEPTIC TANK LEVEL \_\_\_\_\_  
 MANUFACTURER \_\_\_\_\_  
 CAPACITY \_\_\_\_\_ GAL  
 SEAM LOC \_\_\_\_\_  
 TANK LID DEPTH \_\_\_\_\_  
 BAFFLES \_\_\_\_\_  
 BAFFLE FILTER \_\_\_\_\_  
 MANHOLE LOC \_\_\_\_\_  
 6" PORT LOC \_\_\_\_\_  
 WATERTIGHT TEST \_\_\_\_\_  
 SLOTTED \_\_\_\_\_  
 DATE ON LID \_\_\_\_\_~~

PRE-CONSTRUCTION:

4/28/2011 Install 525' of trench in front yard between perc. test holes. Decrease trench depth as you move down hill to compensate for higher ground water. (BB)

INSTALLATION: 8/31/2011 Line run from old dist. box to new dist. box. Top trench done but only 8' depth. Make rest of second trench 8.5' deep and also trench below it. Lowest trenches to be 8' deep. Trenches being installed uphill of test hole (B). (BB)

9/1/2011 Third trench done. Starting on 4th trench. (PB)

9/12/2011 Fifth trench 8' deep. Bottom trench 7.5' deep. O.K. getting close to test hole (B). System finished. (BB)

FINAL INSPECTOR

B. Baker

DATE OF APPROVAL

9/12/2011