

APPLICATION

A _____

P _____

SEWAGE DISPOSAL TESTING

STATE OF MARYLAND - DEPARTMENT OF HEALTH AND MENTAL HYGIENE

HOWARD COUNTY HEALTH DEPARTMENT
ENVIRONMENTAL HEALTH SERVICES
P. O. BOX 476, ELLICOTT CITY, MARYLAND 21043
TELEPHONE: 463-5000, EXT. 356

DISTRICT 4th

DATE 12/2/76

TO: THE COUNTY HEALTH OFFICER
ELLICOTT CITY, MARYLAND

I, HEREBY, APPLY FOR THE NECESSARY TEST IN ORDER TO CONSTRUCT (OR RECONSTRUCT) A SEWAGE DISPOSAL SYSTEM.

PROPERTY OWNER Ben Slagle property
Evans, Hagan & Holdafer, Inc.

ADDRESS 111 John Street, 2nd Floor, Westminster PHONE _____

PROPERTY LOCATION:

SUBDIVISION _____ LOT NO. 2

ROAD AND DESCRIPTION Mullinix Road

SIZE OF LOT 1 acre +- TYPE BLDG. 3 or 4
NUMBER OF BEDROOMS _____

IF NOT SINGLE RESIDENCE DESCRIBE _____

THE SYSTEM INSTALLED UNDER THIS APPLICATION IS ACCEPTABLE ONLY UNTIL PUBLIC FACILITIES BECOME AVAILABLE.

SIGNATURE OF APPLICANT J. Carroll Hagan

BLDG. PERMIT SIGNED
AND RETURNED 8/3/77
Serial # 32734

APPROVED BY _____ FOR _____ DATE _____
(KIND OF SYSTEM)



REJECTED BY _____ FOR _____ DATE _____
(KIND OF SYSTEM)

HOLD PENDING FURTHER TESTS _____ DATE _____

REASONS FOR REJECTION OR HOLDING _____

THIS IS NOT A PERMIT

All Holes

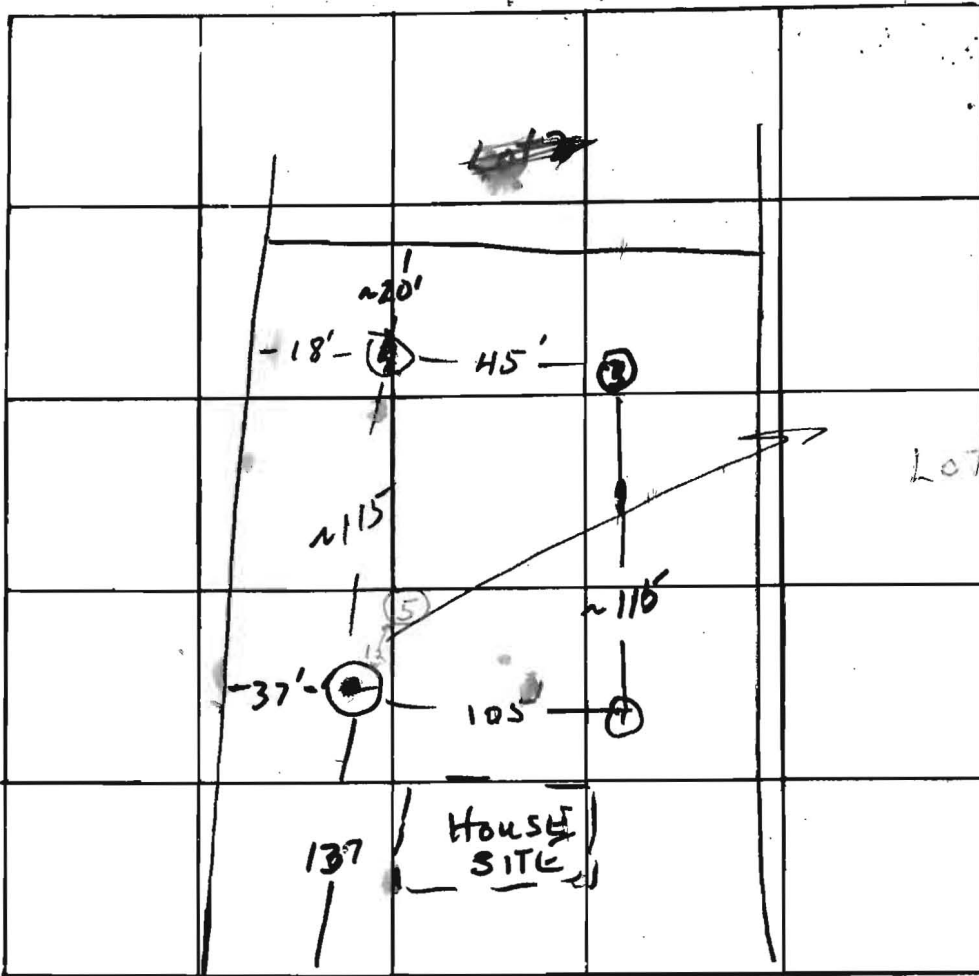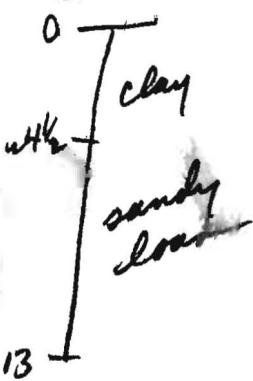

INDICATE NORTH - NAME ADJOINING ROADWAY AS BASE LINE.
A.E. MULLINIX RD

DATE	TEST NO.	DEPTH	PRE-WET		TEST - 1" DROP		TIME	
			START	STOP	START	STOP		
12/9/76	A	4 1/2	11:18	11:22	11:22	11:40	18	
	1-A	6 1/2	11:21	11:23	11:23	11:34	11	
	HIGH	2	4 1/4	11:30	11:33	11:33	11:42	9
		2-A	13	11:32	11:35	11:35	11:40	3
	LOW	3	12 1/2	VISUAL; SIMILAR		SOIL		
			5	11:48	NO PERC			
		4-A	13	11:50	11:53	11:53	12:02	9
		4-B	5 1/2	12:05	12:09	12:09	12:24	15
F.S. 7/25/77	5	13'	Clay to 4'; sandy loam below					

29
12
24
65
Stephen also present

REMARKS _____

TYPE OF SOIL Sandy loam

TESTED BY WWZ

ALSO PRESENT:

Bollinger, Stephen