

APPLICATION

SEWAGE DISPOSAL TESTING

MARYLAND STATE DEPARTMENT OF HEALTH

HOWARD COUNTY

A 15773

P _____

ELLICOTT CITY

DISTRICT 4

DATE 3/17/71

TO: THE COUNTY HEALTH OFFICER
ELLICOTT CITY, MARYLAND

I, HEREBY, APPLY FOR THE NECESSARY TESTS IN ORDER TO CONSTRUCT (OR RECONSTRUCT) A SEWAGE DISPOSAL SYSTEM.

PROPERTY OWNER Edward Clarke

ADDRESS 8890 A Town & Country Blvd., Ellicott City, Md. PHONE 465-0610

PROPERTY LOCATION:

SUBDIVISION _____ LOT NO. _____

ROAD AND DESCRIPTION 16486 A. E. Mullinix Road, Woodbine, Maryland

OCCUPANT _____ PHONE _____

PERSON TO CONSTRUCT SYSTEM _____

ADDRESS _____ PHONE _____

SIZE OF LOT 4.00 acres TYPE BLDG. Garage apartment
2 bedrooms
NUMBER OF BEDROOMS

IF NOT SINGLE RESIDENCE DESCRIBE _____

SIGNATURE OF APPLICANT Edward M. Clarke

APPROVED BY [Signature] FOR [Signature] DATE 4/9/71
(KIND OF SYSTEM)


REJECTED BY _____ FOR _____ DATE _____
(KIND OF SYSTEM)

HOLD PENDING FURTHER TESTS _____ DATE _____

REASONS FOR REJECTION OR HOLDING _____

THIS IS NOT A PERMIT

1880

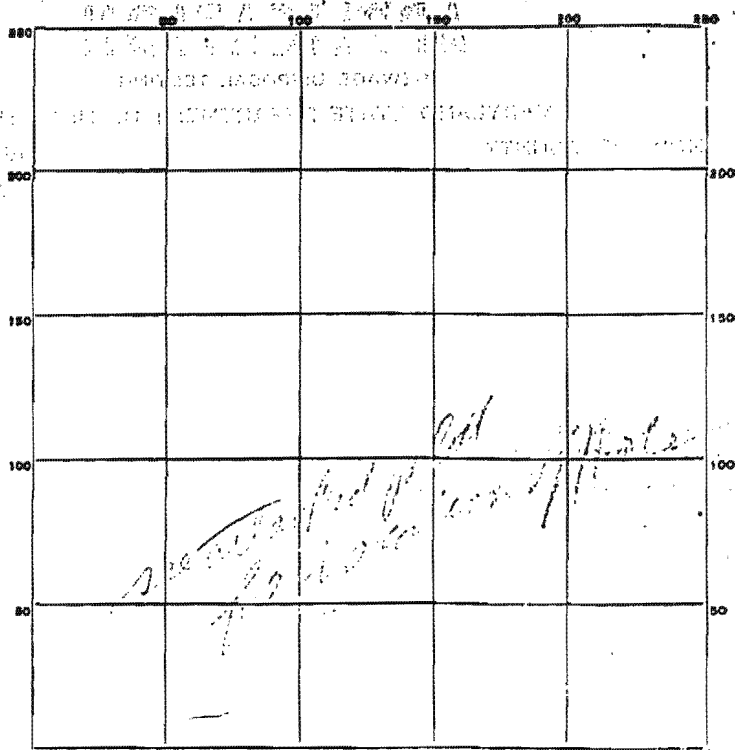

INDICATE NORTH - NAME ADJOINING ROADWAY AS BASE LINE.

DATE	TEST NO.	DEPTH	PRE-WET		TEST - 1" DROP		TIME
			START	STOP	START	STOP	
4/2/71	1	11	12.31	12.36	12.32	12.52	20
	2	5	12.30			1.05	3
	3	11	12.45	12.53	12.53	1.10	17
	4	11	12.46	12.46	12.46	12.49	1

SOIL AUGER FINDING _____
 TESTED BY: [Signature]
 REMARKS: _____

1880