

APPLICATION

PERCOLATION TESTING

A 42224

P _____

HOWARD COUNTY HEALTH DEPARTMENT
BUREAU OF ENVIRONMENTAL HEALTH
P.O. BOX 476 ELLICOTT CITY, MARYLAND 21043
TELEPHONE: 461-9933

DISTRICT 5TH

DATE MAY 1988

TO: THE COUNTY HEALTH OFFICER
ELLICOTT CITY, MARYLAND

I, HEREBY, APPLY FOR THE NECESSARY TEST IN ORDER TO CONSTRUCT (OR RECONSTRUCT) A SEWAGE DISPOSAL SYSTEM.

PROPERTY OWNER BAC - MP DEVELOPMENT LIMITED PARTNERSHIP

C/O M.P. ASSOCIATES
ADDRESS 3901 NATIONAL DRIVE SUITE 100 PHONE 421-1700
BURTONSVILLE, MARYLAND 20866

PROSPECTIVE BUYER _____

ADDRESS _____ PHONE _____

PROPERTY LOCATION:

SUBDIVISION ADAMS REACH SEC. 2 LOT NO. LOT 19 Prelim.

ROAD AND DESCRIPTION 5540 Adams Ridge Road
LOCATED ON THE NORTH AND SOUTH SIDES OF

MD. ROUTE 32, WEST OF RTE 108, NORTH OF TEL DAK'S ROAD

TAX MAP 28 PARCEL # 240
BLDG. PERMIT SIGNED AND RETURNED 6-19-87
Serial # B1100258

SIZE OF LOT ± 3.3 Ac. TYPE BLDG. SFD - 3Bm
(SINGLE FAMILY DWELLING OR COMMERCIAL)

THE SYSTEM INSTALLED UNDER THIS APPLICATION IS ACCEPTABLE ONLY UNTIL PUBLIC FACILITIES BECOME AVAILABLE. I FULLY UNDERSTAND THE FEE CONNECTED WITH THE FILING OF THIS PERC TEST APPLICATION IS NON-REFUNDABLE UNDER ANY CIRCUMSTANCES. I ALSO AGREE TO COMPLY WITH ALL M.O.S.H.A. REQUIREMENTS IN TESTING THIS LOT.

[Signature]
(SIGNATURE OF APPLICANT)

APPROVED BY _____ FOR _____ DATE _____

REJECTED BY _____ FOR _____ DATE _____

HOLD PENDING FURTHER TESTS _____ DATE _____

REASONS FOR REJECTION OR HOLDING 9-23-88 Reel SATISFACTORY Hold for PCAT. Sat


THIS IS NOT A PERMIT

A-42224

LOT 11

(A) - (D)
SOIL PROFILE

0"	AP
8"	Yellow Brk Silty CLAY worm 20% frags
2.0"	
3.5"	Yellow Brown Silty loam 10% frags
12"	

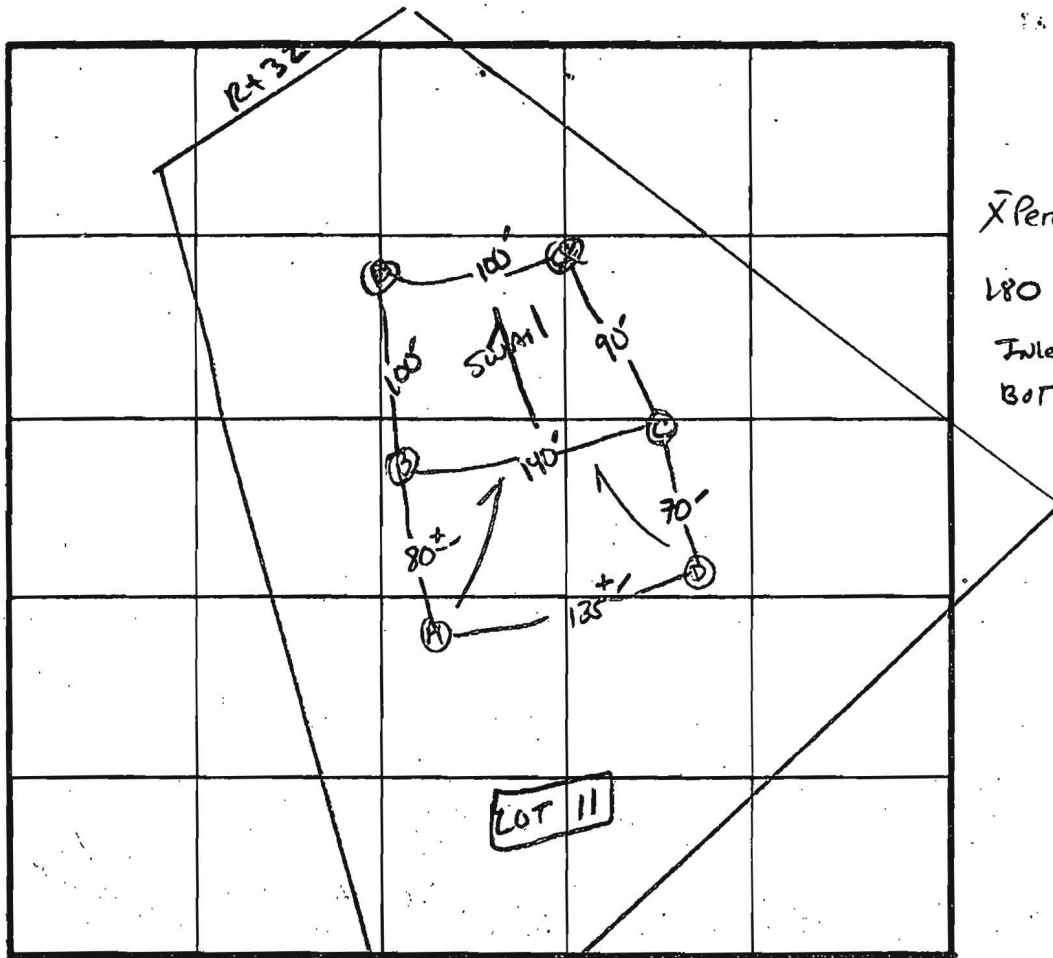

X Perc 3 min

180 #/BA

Inlet 8"

BOTTOM 8.5"

INDICATE NORTH, NAME ADJOINING ROADWAY AS BASE LINE.

↓ TO TEN OAKS

DATE	TEST NO	DEPTH	PRE-WET		TEST - 1" DROP		TIME	
			START	STOP	START	STOP		
9/23/88	✓ AS	4.5"	11:20	11:22	11:22	11:28	6 min	
		8.5"	11:19	11:20	11:20	11:22	2 min	
	✓ AV	12"	UNIFORM soil below 3.5"					
	BS	2.5"	11:29	11:30	11:30	11:32	2 min	
		12"	UNIFORM soil below 2.0"					
	CS	3"	11:33	11:34	11:34	11:36	2 min	
	CV	12"	UNIFORM soil below 3"					
	✓ DV	12"	UNIFORM soil below 3.0"					

REMARKS: Holes DIFF THAN RAT / FLIPPED-UP

TYPE OF SOIL: Chester loam

TESTED BY: S. Abel

ALSO PRESENT: Fyock & Co. Wayne

EH-12-1079