

# APPLICATION

A 41271

SEWAGE DISPOSAL TESTING

P \_\_\_\_\_

STATE OF MARYLAND - DEPARTMENT OF HEALTH AND MENTAL HYGIENE

HOWARD COUNTY HEALTH DEPARTMENT  
ENVIRONMENTAL HEALTH SERVICES  
P. O. BOX 476, ELLICOTT CITY, MARYLAND 21043  
TELEPHONE: 465-5000, EXT. 356

DISTRICT 4th

DATE 3/24/88

*Check is in*

TO: THE COUNTY HEALTH OFFICER  
ELLICOTT CITY, MARYLAND

I, HEREBY, APPLY FOR THE NECESSARY TEST IN ORDER TO CONSTRUCT (OR RECONSTRUCT) A SEWAGE DISPOSAL SYSTEM.

PROPERTY OWNER CHARLES A. SHARP JAMES & EARL Romero

ADDRESS 3779 SHARP ROAD, GLENWOOD MD. 21738 PHONE 489-4630

PROPERTY LOCATION:

*17 on Final*

SUBDIVISION SHARP FARMS, LOTS 1-16 LOT NO. X

ROAD AND DESCRIPTION N.W. OF INTERSECTION (37th Appleby Court) BETWEEN SHARP ROAD

AND SHADY LANE TAX MAP 21 Parcel 86

SIZE OF LOT 3.00 Ac ± TYPE BLDG. S.F.D. - 4 BEDROOM

NUMBER OF BEDROOMS

IF NOT SINGLE RESIDENCE DESCRIBE \_\_\_\_\_

THE SYSTEM INSTALLED UNDER THIS APPLICATION IS ACCEPTABLE ONLY UNTIL PUBLIC FACILITIES BECOME AVAILABLE.

SIGNATURE OF APPLICANT \_\_\_\_\_

APPROVED BY \_\_\_\_\_ FOR \_\_\_\_\_ DATE \_\_\_\_\_  
(KIND OF SYSTEM)

REJECTED BY \_\_\_\_\_ FOR \_\_\_\_\_ DATE \_\_\_\_\_  
(KIND OF SYSTEM)

HOLD PENDING FURTHER TESTS \_\_\_\_\_ DATE \_\_\_\_\_

REASONS FOR REJECTION OR HOLDING \_\_\_\_\_

BLDG. PERMIT SIGNED  
AND RETURNED 3/24/88  
*Serial # 57893 -*  
*SFD - 4Bom*


# THIS IS NOT A PERMIT

Arizon area

Tran line

#1  
A 41271

Shang Road

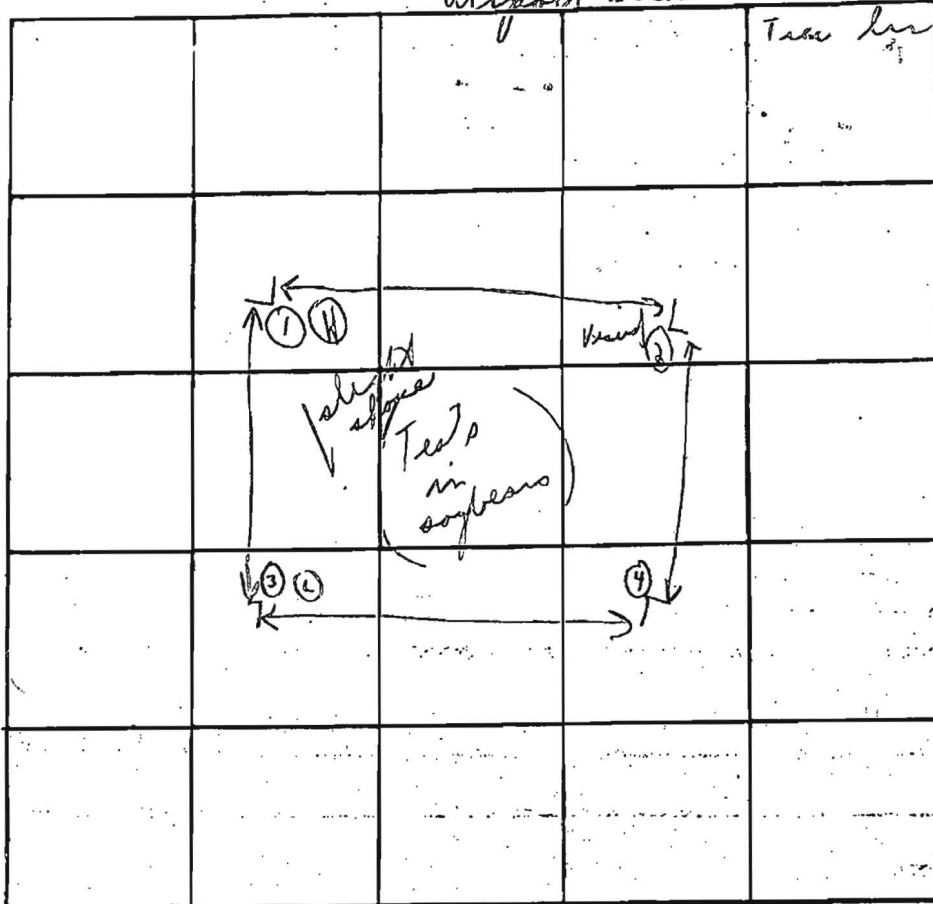

INDICATE NORTH. - NAME ADJOINING ROADWAY AS BASE LINE.

| DATE    | TEST NO. | DEPTH  | PRE-WET  |        | TEST - 1" DROP |       | TIME |
|---------|----------|--------|----------|--------|----------------|-------|------|
|         |          |        | START    | STOP   | START          | STOP  |      |
| 9/27/88 | 1A       | 3'     | 10:47    | 10:50  | 10:50          | 11:00 | 1m   |
|         | ① 1B     | 6 1/2' | 10:47    | 10:49  | 10:49          | 10:51 | 2m   |
|         | 2A       | '      |          |        | Similar to ①   |       |      |
|         | 2B       | 12'    | 10:40 AM | Visual |                |       |      |
|         | 3A       | 4 1/2' | 10:45    | 10:46  | 10:46          | 10:47 | 1m   |
|         | ② 3B     | 12'    | Visual   | loam   |                |       |      |
|         | 4A       | 4'     | 10:55    | 10:56  | 10:56          | 10:57 | 1m   |
|         | 4B       | 11'    | Visual   | loam   |                |       |      |
|         |          |        |          |        |                |       |      |
|         |          |        |          |        |                |       |      |

SOIL PROFILE  
No rock  
in any holes  
BELOW CLAY  
LOAM  
↓  
TO BOTTOM  
Holes  
①, ②, ③, ④

12 1/2

REMARKS (Tests per stake) Hold log  
(Tests per open) certified holes

TYPE OF SOIL

TESTED BY C.R.D. ALSO PRESENT: {WOODY} {SKIPPY}