


REVISED

Date: 6-19-15

Comments: ~~removed~~  
Second stove  
B15001412

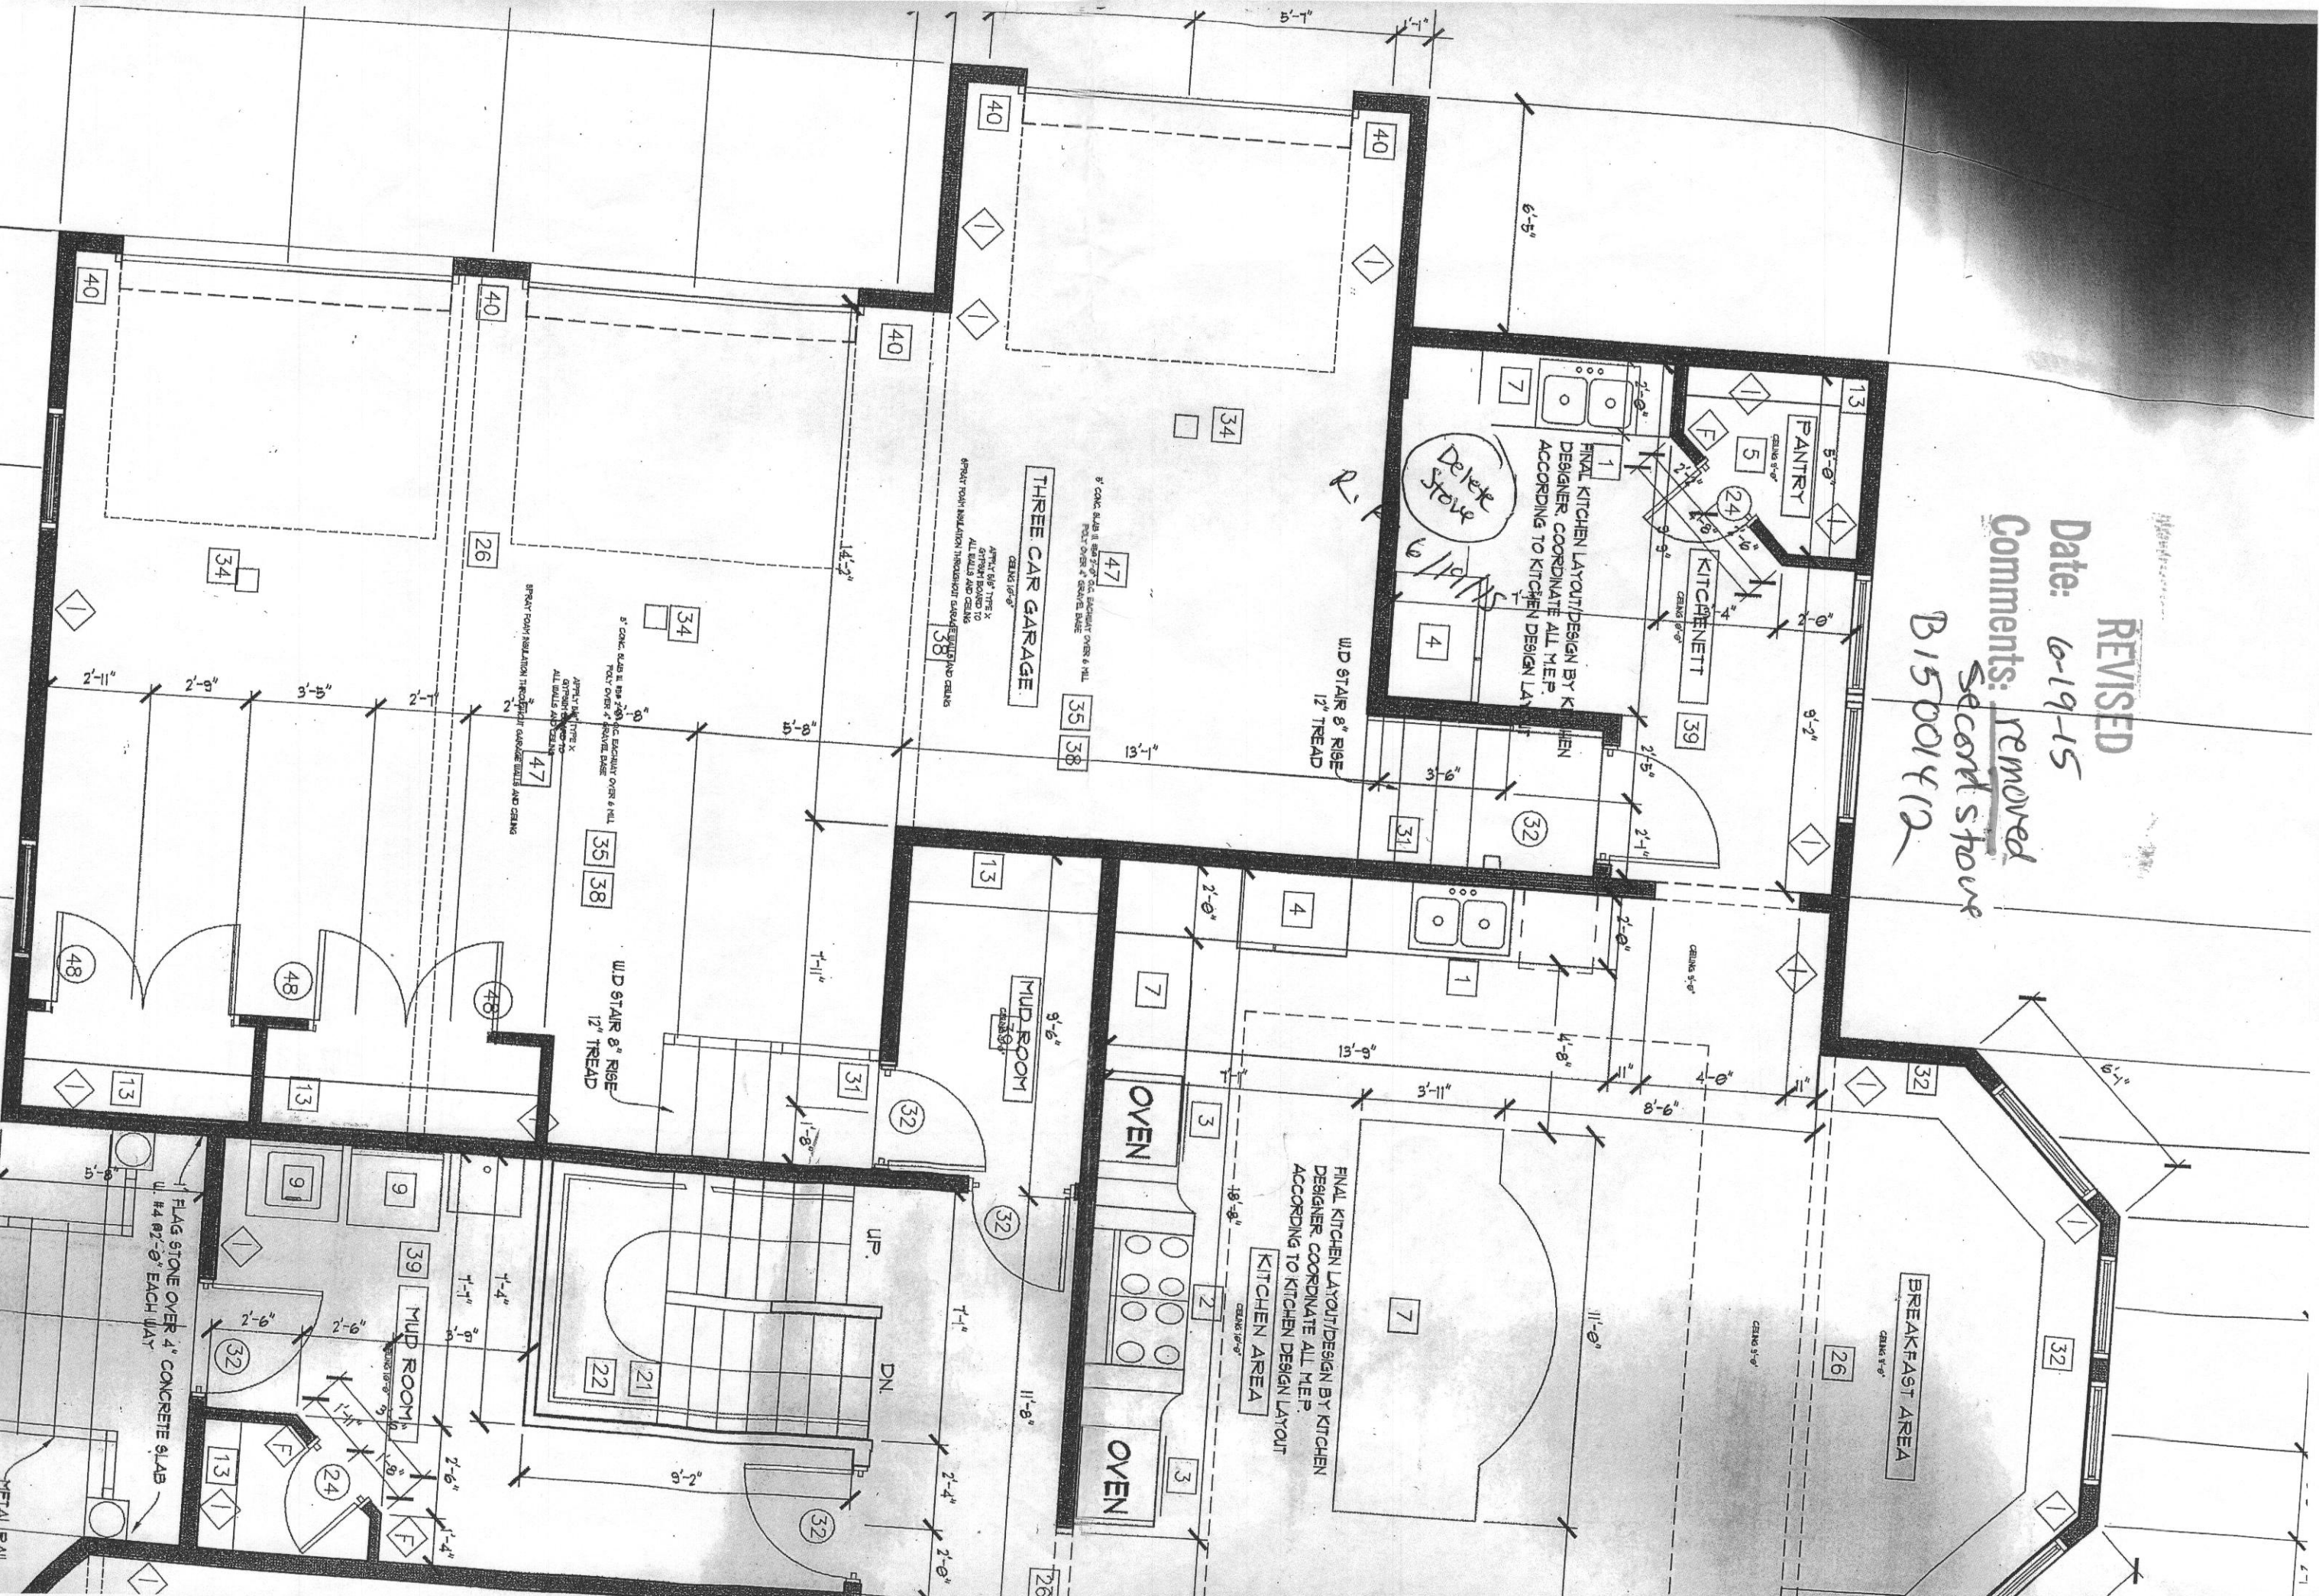

FLAG STONE OVER 4\" CONCRETE SLAB  
#4 @ 8\"-0\" EACH WAY

METAL RAIL  
PER CODE