



HEALTH

Building Permit Application

Howard County Maryland
Department of Inspections, Licenses and Permits
3430 Court House Drive
Permits: 410-313-2455
www.howardcountymd.gov

Date Received: 7/23/15

Permit No.: B15003187

Building Address: 12355 Pleasant View Cir
City: Fulton State: MD Zip Code: 20759
Sulte/Apt. # SDP/WP/BA #:
Census Tract: Subdivision: 0000
Section: Area: Lot: 29
Tax Map: 40 Parcel: 508 Grid: 6
Zoning: Map Coordinates: Lot Size:

Property Owner's Name: Jacqueline Eastey
Address: 12355 Pleasant View Cir
City: Fulton State: MD Zip Code: 20759
Phone: 410 202 71073 Fax:
Email: jacqeastey@yahoo.com

Applicant's Name & Mailing Address, (if other than stated herein)
Applicant's Name:
Address:
City: State: Zip Code:
Phone: Fax:
Email:

Existing Use: Single Family Dwelling
Proposed Use: Fuel supply for pool heater
Estimated Construction Cost: \$ 4,700
Description of Work: Install 500 gal under ground propane tank and install 95' of gas line from tank to pool heater.
Occupant or Tenant:
Was tenant space previously occupied? Yes No
Contact Name:
Address:
City: State: Zip Code:
Phone: Fax:
Email:

Contractor Company: Suburban Propane
Contact Person: Brent Stubbs
Address: 31 Derwood Cir.
City: Rockville State: MD Zip Code: 20850
License No.: 77263
Phone: 301 251 0101 Fax: 301 251 0108
Email: bstubbs@suburbanpropane.com

Engineer/Architect Company:
Responsible Design Prof.:
Address:
City: State: Zip Code:
Phone: Fax:
Email:

Commercial Building Characteristics Residential Building Characteristics
Height: 1 SF Dwelling SF Townhouse
No. of stories: Depth Width
Gross area, sq. ft./floor: 1st floor: 2nd floor:
Area of construction (sq. ft.): Basement:
Use group: Finished Basement Unfinished Basement Crawl Space Slab on Grade
Construction type: Reinforced Concrete Structural Steel Masonry Wood Frame State Certified Modular
No. of Bedrooms: Multi-family Dwelling
No. of efficiency units:
No. of 1 BR units:
No. of 2 BR units:
No. of 3 BR units:
Other Structure:
Dimensions:
Footings:
Roof:
State Certified Modular
Manufactured Home

Utilities
Water Supply
Public Private
Sewage Disposal
Public Private
Electric: Gas:
Heating System
Electric Oil
Natural Gas Propane Gas
Other:
Sprinkler System:
Yes No
Grading Permit Number:
Building Shell Permit Number:

THE UNDERSIGNED HEREBY CERTIFIES AND AGREES AS FOLLOWS: (1) THAT HE/SHE IS AUTHORIZED TO MAKE THIS APPLICATION; (2) THAT THE INFORMATION IS CORRECT; (3) THAT HE/SHE WILL COMPLY WITH ALL REGULATIONS OF HOWARD COUNTY WHICH ARE APPLICABLE THERETO; (4) THAT HE/SHE WILL PERFORM NO WORK ON THE ABOVE REFERENCED PROPERTY NOT SPECIFICALLY DESCRIBED IN THIS APPLICATION; (5) THAT HE/SHE GRANTS COUNTY OFFICIALS THE RIGHT TO ENTER ONTO THIS PROPERTY FOR THE PURPOSE OF INSPECTING THE WORK PERMITTED AND POSTING NOTICES.
Applicant's Signature: [Signature]
Print Name: Brent Stubbs
Date: 7/22/15
Email Address: BSTUBBS@SUBURBANPROPANE.COM
Title/Company:
RECEIVED JUL 23 2015

Checks Payable to: DIRECTOR OF FINANCE OF HOWARD COUNTY
\*\*PLEASE WRITE NEATLY & LEGIBLY\*\*
FOR OFFICE USE ONLY
LICENSES & PERMITS DIVISION

AGENCY DATE SIGNATURE OF APPROVAL
State Highways
Building Officials
PSZA (Zoning)
PSZA (Engineering)
Health: 8/3/15 [Signature]
Is Sediment Control approval required for issuance? Yes No
CONTINGENCY CONSTRUCTION START

DPZ SETBACK INFORMATION
Front:
Rear:
Side:
Side St.:
All minimum setbacks met? Yes No
Is Entrance Permit Required? Yes No
Historic District? Yes No
Lot Coverage for New Town Zone:
SDP/Red-line approval date:


Filing Fee \$
Permit Fee \$ 100.00
Tech Fee \$ 10.00
Exclse Tax \$
PSFS \$
Guaranty Fund \$
Add'l per Fee \$
Total Fees \$ 110.00
Sub- Total Paid \$
Balance Due \$
Check MO # 17-202864696

Distribution of Copies: White: Building Officials Green: PSZA,Zoning Yellow: PSZA,Engineering Pink: Health Gold: SHA
T:\Operations\Updated Forms\Building applmp 8.2012.docx

12355 PLEASANT VIEW DRIVE  
 FULTON, MARYLAND 20759

SCALE = 1" = 30'

KEY	
	PROPERTY LINES
	CITY STREET / DRIVE
	BUILDING PROJECT AREA
	MEASUREMENT MARKINGS
	SEPTIC AREA
	500 GALLON U/LG L.P. TANK

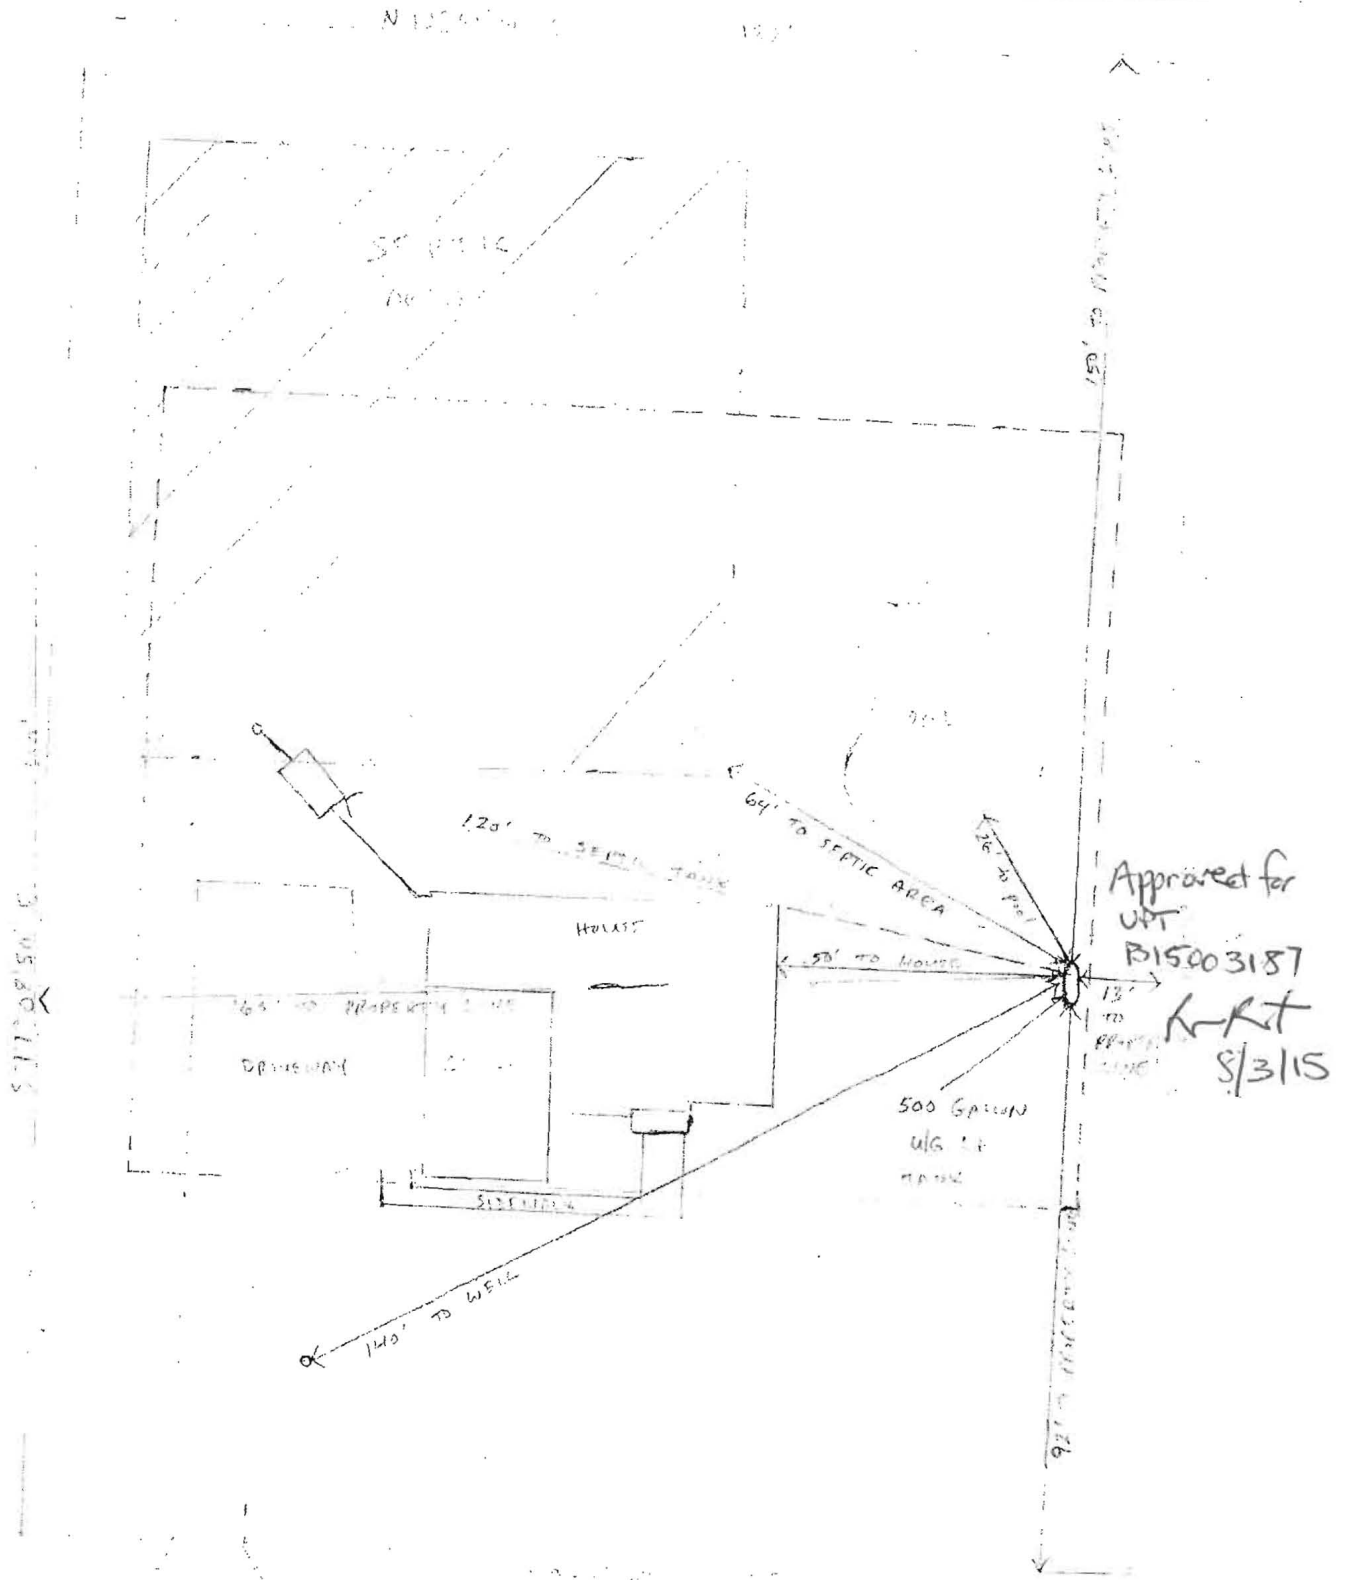

Approved for  
 UPT  
 B15003187  
 R-R-T  
 8/3/15