



# Building Permit Application

Howard County Maryland  
Department of Inspections, Licenses and Permits  
3430 Court House Drive  
Permits: 410-313-2455  
www.howardcountymd.gov

Date Received: \_\_\_\_\_

Permit No.: \_\_\_\_\_

Building Address: 13150 Brighton Dam Rd  
 City: Clarksville State: MD Zip Code: 21029  
 Suite/Apt. # \_\_\_\_\_ SDP/WP/BA #: \_\_\_\_\_  
 Census Tract: \_\_\_\_\_ Subdivision: Waterford  
 Section: 3 Area: \_\_\_\_\_ Lot: 7  
 Tax Map: \_\_\_\_\_ Parcel: \_\_\_\_\_ Grid: \_\_\_\_\_  
 Zoning: \_\_\_\_\_ Map Coordinates: \_\_\_\_\_ Lot Size: \_\_\_\_\_

Property Owner's Name: Gary + Shelby Willets  
 Address: 13150 Brighton Dam Rd  
 City: Clarksville State: MD Zip Code: 21029  
 Phone: 443-283-2861 Fax: \_\_\_\_\_  
 Email: HackNCobra@aol.com  
 Applicant's Name & Mailing Address, (if other than stated herein)  
 Applicant's Name: Shelby Willets  
 Address: \_\_\_\_\_  
 City: \_\_\_\_\_ State: \_\_\_\_\_ Zip Code: \_\_\_\_\_  
 Phone: \_\_\_\_\_ Fax: \_\_\_\_\_  
 Email: \_\_\_\_\_

Existing Use: \_\_\_\_\_  
 Proposed Use: Garage and arbour  
 Estimated Construction Cost: \$ \$6,000.00 + \$5,000.00  
 Description of Work: \_\_\_\_\_  
 Occupant or Tenant: none  
 Was tenant space previously occupied?  Yes  No  
 Contact Name: \_\_\_\_\_  
 Address: \_\_\_\_\_  
 City: \_\_\_\_\_ State: \_\_\_\_\_ Zip Code: \_\_\_\_\_  
 Phone: \_\_\_\_\_ Fax: \_\_\_\_\_  
 Email: \_\_\_\_\_

Contractor Company: \_\_\_\_\_  
 Contact Person: \_\_\_\_\_  
 Address: \_\_\_\_\_  
 City: \_\_\_\_\_ State: \_\_\_\_\_ Zip Code: \_\_\_\_\_  
 License No.: \_\_\_\_\_  
 Phone: \_\_\_\_\_ Fax: \_\_\_\_\_  
 Email: \_\_\_\_\_  
 Engineer/Architect Company: \_\_\_\_\_  
 Responsible Design Prof.: \_\_\_\_\_  
 Address: \_\_\_\_\_  
 City: \_\_\_\_\_ State: \_\_\_\_\_ Zip Code: \_\_\_\_\_  
 Phone: \_\_\_\_\_ Fax: \_\_\_\_\_  
 Email: \_\_\_\_\_

Commercial Building Characteristics	Residential Building Characteristics	
Height:	<input type="checkbox"/> SF Dwelling <input type="checkbox"/> SF Townhouse	
No. of stories:	Depth	Width
Gross area, sq. ft./floor:	1 <sup>st</sup> floor:	
Area of construction (sq. ft.):	2 <sup>nd</sup> floor:	
Use group:	Basement:	
	<input type="checkbox"/> Finished Basement	
	<input type="checkbox"/> Unfinished Basement	
	<input type="checkbox"/> Crawl Space	
	<input type="checkbox"/> Slab on Grade	
<b>Construction type:</b>	No. of Bedrooms:	
<input type="checkbox"/> Reinforced Concrete	<b>Multi-family Dwelling</b>	
<input type="checkbox"/> Structural Steel	No. of efficiency units:	
<input type="checkbox"/> Masonry	No. of 1 BR units:	
<input type="checkbox"/> Wood Frame	No. of 2 BR units:	
<input type="checkbox"/> State Certified Modular	No. of 3 BR units:	
	Other Structure:	
	Dimensions:	
<input checked="" type="checkbox"/> Roadside Tree Project Permit	Footings:	
<input type="checkbox"/> Yes <input type="checkbox"/> No	Roof:	
Roadside Tree Project Permit #	<input type="checkbox"/> State Certified Modular	
	<input type="checkbox"/> Manufactured Home	

Utilities	
<b>Water Supply</b>	
<input type="checkbox"/> Public	
<input checked="" type="checkbox"/> Private	
<b>Sewage Disposal</b>	
<input type="checkbox"/> Public	
<input checked="" type="checkbox"/> Private	
Electric:	<input type="checkbox"/> Yes <input type="checkbox"/> No
Gas:	<input type="checkbox"/> Yes <input type="checkbox"/> No
<b>Heating System</b>	
<input type="checkbox"/> Electric	<input type="checkbox"/> Oil
<input type="checkbox"/> Natural Gas	<input type="checkbox"/> Propane Gas
<input type="checkbox"/> Other:	
<b>Sprinkler System:</b>	
<input type="checkbox"/> Yes	<input type="checkbox"/> No
Grading Permit Number:	
Building Shell Permit Number:	

THE UNDERSIGNED HEREBY CERTIFIES AND AGREES AS FOLLOWS: (1) THAT HE/SHE IS AUTHORIZED TO MAKE THIS APPLICATION; (2) THAT THE INFORMATION IS CORRECT; (3) THAT HE/SHE WILL COMPLY WITH ALL REGULATIONS OF HOWARD COUNTY WHICH ARE APPLICABLE THERETO; (4) THAT HE/SHE WILL PERFORM NO WORK ON THE ABOVE REFERENCED PROPERTY NOT SPECIFICALLY DESCRIBED IN THIS APPLICATION; (5) THAT HE/SHE GRANTS COUNTY OFFICIALS THE RIGHT TO ENTER ONTO THIS PROPERTY FOR THE PURPOSE OF INSPECTING THE WORK PERMITTED AND POSTING NOTICES.

Applicant's Signature: Shelby Willets Print Name: Shelby Willets  
 Email Address: hackNCobra@aol.com Date: 22 July 2015  
 Title/Company: \_\_\_\_\_

Checks Payable to: DIRECTOR OF FINANCE OF HOWARD COUNTY  
 \*\*PLEASE WRITE NEATLY & LEGIBLY\*\*  
 -FOR OFFICE USE ONLY-


AGENCY	DATE	SIGNATURE OF APPROVAL
State Highways		
Building Officials		
PSZA (Zoning)		
PSZA (Engineering)		
Health		<u>7/22/15 Bencard</u>

Is Sediment Control approval required for issuance?  Yes  No  
 CONTINGENCY CONSTRUCTION START

DPZ SETBACK INFORMATION
Front:
Rear:
Side:
Side St.:
All minimum setbacks met? <input type="checkbox"/> Yes <input type="checkbox"/> No
Is Entrance Permit Required? <input type="checkbox"/> Yes <input type="checkbox"/> No
Historic District? <input type="checkbox"/> Yes <input type="checkbox"/> No
Lot Coverage for New Town Zone:
SDP/Red-line approval date:

Filing Fee	\$
Permit Fee	\$
Tech Fee	\$
Excise Tax	\$
PSFS	\$
Guaranty Fund	\$
Add'l per Fee	\$
Total Fees	\$
Sub- Total Paid	\$
Balance Due	\$
Check	#

*13150 Brighton Dam Rd.*

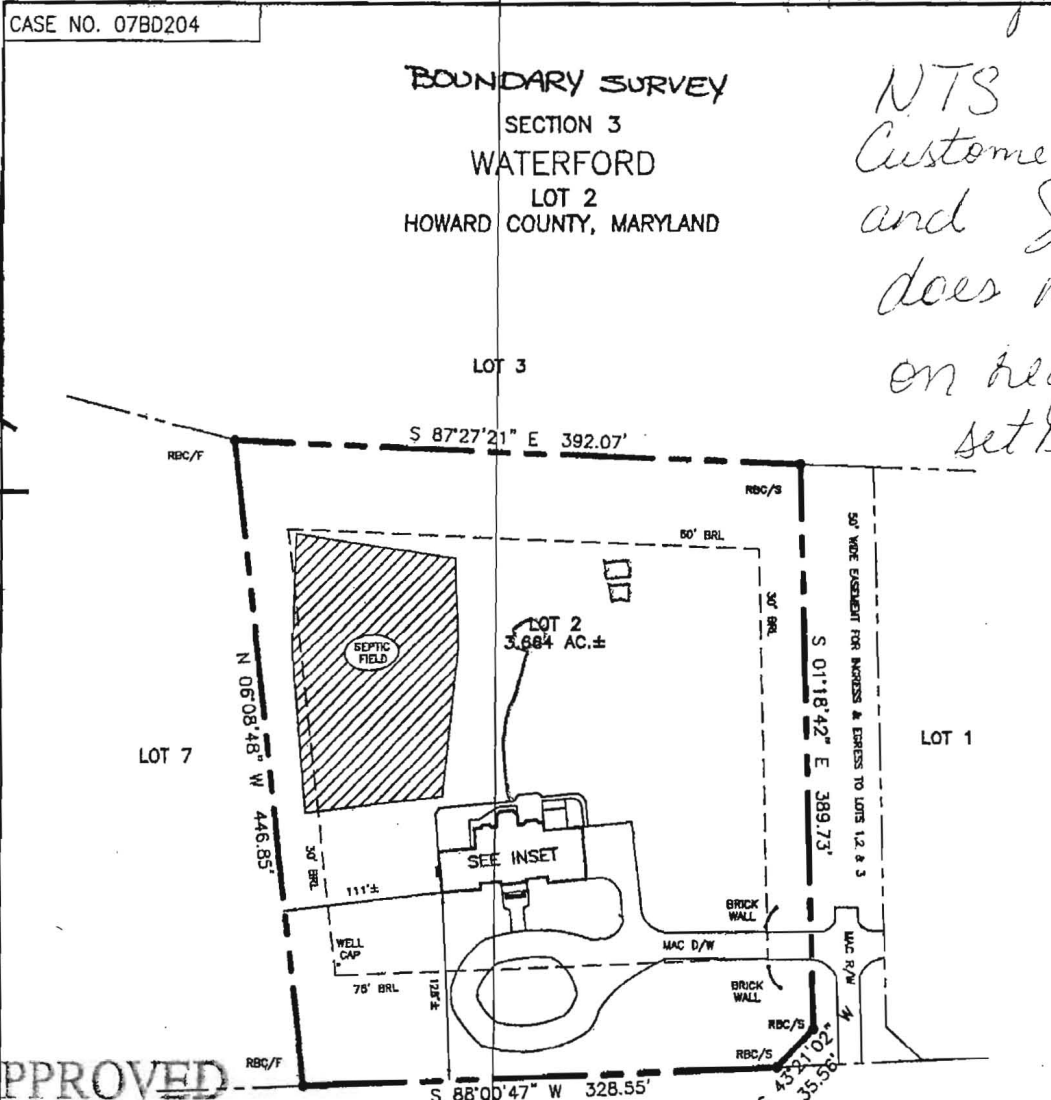


*NTS However Customers Arbor and Shed does not enforce on required setbacks*

**APPROVED**

**WALK-THRU BUILDING PERMIT**

BP# \_\_\_\_\_ A# \_\_\_\_\_  
 APP. SAND *Bernard* DATE: *7-22-15*  
 DESC. OF WORK: *Arbor and Shed*

- LEGEND**
- B/W=BAYWINDOW
  - B.R.L.=BUILDING RESTRICTION LINE
  - CONC.=CONCRETE
  - F/S=FLAGSTONE
  - O/H=OVERHANG
  - MAC.=MACADAM
  - P/W=PARTYWALL
  - W/D=WOODDECK
  - C/P=CONCRETE PORCH
  - C/S=CONCRETE STOOP
  - C/O=CLEANOUT
  - RBC/F=REBAR & CAP FOUND
  - RBC/S=REBAR & CAP SET
  - S/W=SIDEWALK
  - D/W=DRIVEWAY
  - A/W=AREAWAY
  - S/P=SCREEN PORCH
  - M/S=METAL SHED
  - FR/S=FRAME SHED
  - HSE=HOUSE
  - B&F=BRICK & FRAME
  - GR=GRAVEL
  - G=GATE
  - ST=STONE

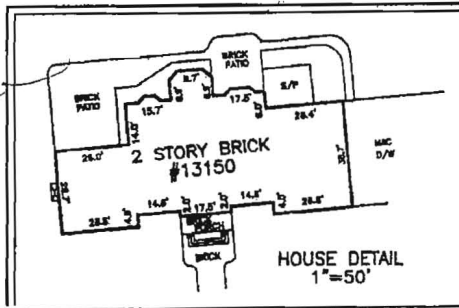

PROPERTY ADDRESS: 13150 BRIGHTON DAM ROAD

THE PROPERTY SHOWN HEREON IS LOCATED IN ZONE C (AREA OF MINIMAL FLOODING) ACCORDING TO NATIONAL FLOOD INSURANCE PROGRAM F.I.R.M. MAP COMMUNITY PANEL NO. 240044 0032B AS REVISED 12/4/86

**CERTIFICATE**  
 I HEREBY DECLARE THAT THE POSITION OF ALL THE VISIBLE EXISTING IMPROVEMENTS SHOWN ON THE ABOVE DESCRIBED PROPERTY HAVE BEEN ESTABLISHED BY PROPER SURVEY METHODS. NO TITLE REPORT HAS BEEN FURNISHED. SUBJECT TO ANY AND ALL RESTRICTIONS AND ENCUMBRANCES OF RECORD.  
 [Signature]  
 MARYLAND PROFESSIONAL SURVEYOR NO. 514

REFERENCES	
PLAT BK.	
PLAT NO.	6873
LIBER	
FOLIO	

**ALL COUNTY LOCATION SURVEYS, INC**

2813 PATENT RIVER ROAD, DAVENPORT, MD. 21035  
 PHONE (410) 708-8701 FAX (410) 708-8705

DATES:	SCALE: 1"=100'
WALL CHECK:	DRAWN BY: ACM
HSE. LOC.: 6/25/07	JOB NO.: 856-07
BOUNDARY: 7/9/07	

NO REPRODUCTION WITHOUT EXPRESSED WRITTEN PERMISSION BY ACLS, INC. © Copyright ACLS, INC.

NOTES: 1) B.R.L. information, if shown was obtained from existing record plat or was provided to ACLS, and is not guaranteed by ACLS, Inc.  
 2) Flood Zone information is subject to the interpretation of the originator.  
 3) ACLS, Inc. does not certify to unknown or unrecorded encroachments or overlaps.  
 4) Level of accuracy 0.5'±.