

# APPLICATION

A \_\_\_\_\_

P \_\_\_\_\_

SEWAGE DISPOSAL TESTING

STATE OF MARYLAND - DEPARTMENT OF HEALTH AND MENTAL HYGIENE

HOWARD COUNTY HEALTH DEPARTMENT  
ENVIRONMENTAL HEALTH SERVICES  
P. O. BOX 476, ELLICOTT CITY, MARYLAND 21043  
TELEPHONE: 465-5000, EXT. 356

DISTRICT 13th

DATE 9/9/76

TO THE COUNTY HEALTH OFFICER  
ELLICOTT CITY, MARYLAND

I, HEREBY, APPLY FOR THE NECESSARY TEST IN ORDER TO CONSTRUCT (OR RECONSTRUCT) A SEWAGE DISPOSAL SYSTEM.

PROPERTY OWNER Mr. and Mrs. Smith W. Allnutt, Jr.

ADDRESS 15288 Highland Road  
Highland, MD 20777 PHONE 938-8305

PROPERTY LOCATION:

SUBDIVISION Hi - Land Farm Estates LOT NO. 113

ROAD AND DESCRIPTION Road "A"

SIZE OF LOT 1.10 Ac TYPE BLDG. 3 or 4 bedroom  
NUMBER OF BEDROOMS

IF NOT SINGLE RESIDENCE DESCRIBE \_\_\_\_\_

THE SYSTEM INSTALLED UNDER THIS APPLICATION IS ACCEPTABLE ONLY UNTIL PUBLIC FACILITIES BECOME AVAILABLE.

SIGNATURE OF APPLICANT /s/ Margaret G. Allnutt

APPROVED BY \_\_\_\_\_ FOR \_\_\_\_\_ DATE \_\_\_\_\_  
(KIND OF SYSTEM)

REJECTED BY \_\_\_\_\_ FOR \_\_\_\_\_ DATE \_\_\_\_\_  
(KIND OF SYSTEM)

HOLD PENDING FURTHER TESTS \_\_\_\_\_ DATE \_\_\_\_\_

REASONS FOR REJECTION OR HOLDING \_\_\_\_\_

## THIS IS NOT A PERMIT

Mr & Mrs FRANK

GIANNANTONIO

13116 TENNEY DRIVE  
BELTSVILLE MD.


20705

PHONE

572-5397

PHONE 725-5772

21036

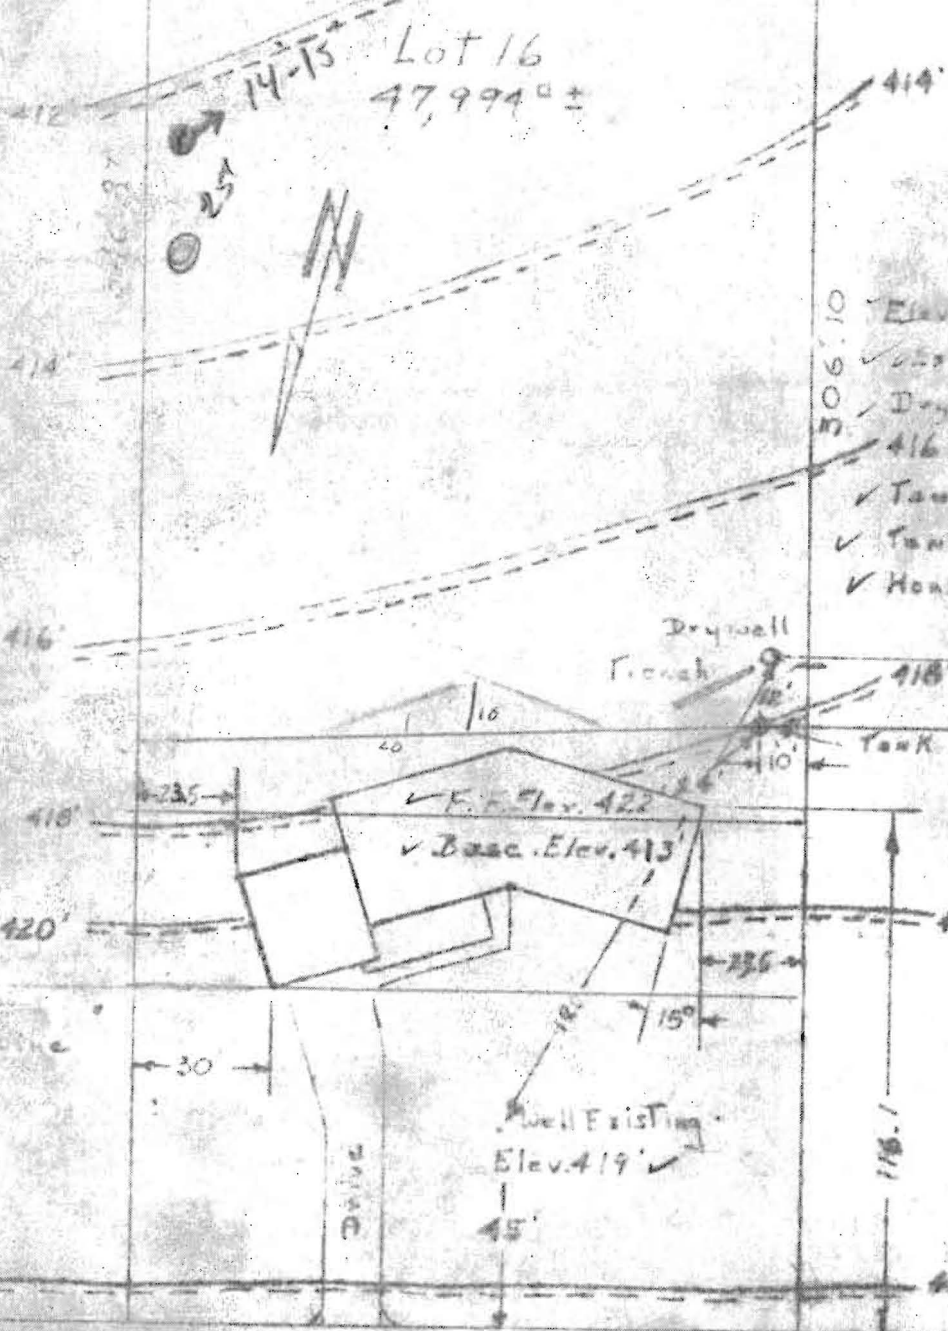

- ✓ Elev. at time of pour. 418
- ✓ Existing Elev. 418
- ✓ Drywell Elev. 414.50
- ✓ Tank Elev. Existing 418
- ✓ Tank Inv. Elev. 415
- ✓ House Inv. Elev. 415.50

Building Line

Scale 1" = 40'

Existing Elev. ———  
Finish Elev. - - - - -

17421 ALLNOTT LANE  
ALLNOTT FARMS ESTATES  
HIGHLAND, MARYLAND

OK D/DR 12/5/69