



NOTE: This Lot lies in Zone C, as shown on Flood Insurance Rate Map for Howard Co., Md., Map Panel 29 of 45, dated Dec. 4, 1986.

LOCATION OF HOUSE
 5438 AUTUMN FIELD COURT
 LOT 15
 STRAWBERRY FIELDS
 SECTION ONE AREA ONE
 LOTS 1 THRU 60
 1ST ELECTION DISTRICT
 HOWARD COUNTY, MARYLAND

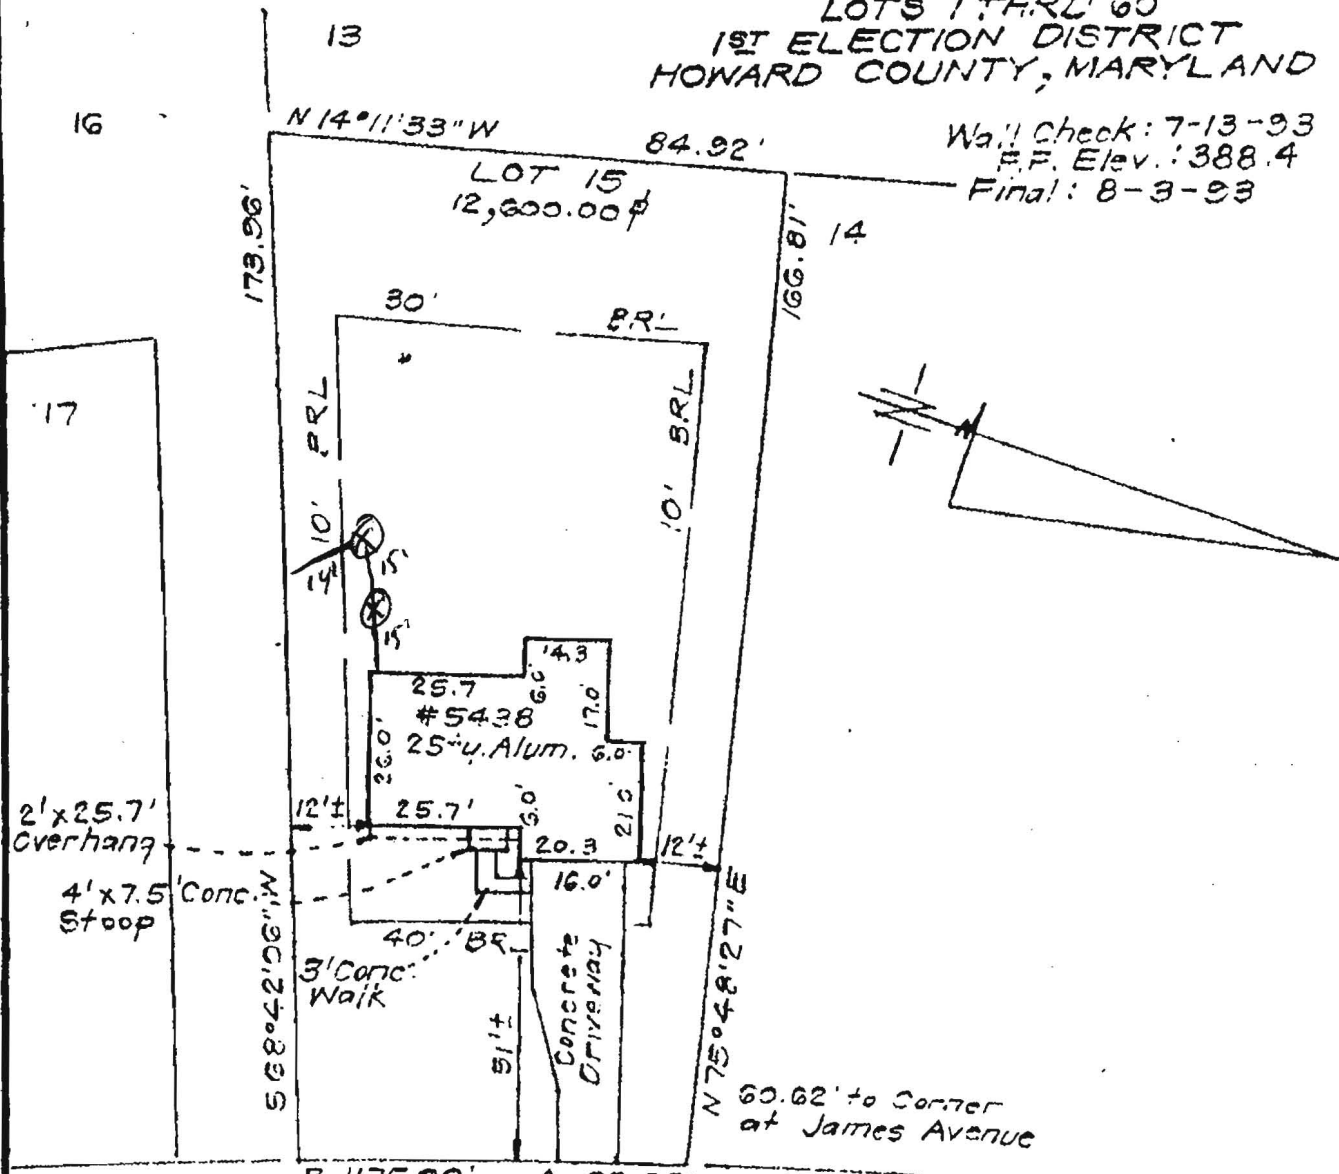

Wall Check: 7-13-93
 F.P. Elev.: 388.4
 Final: 8-3-93

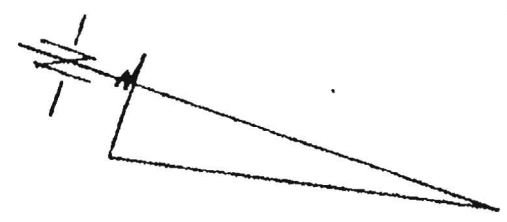

R=1175.00' A=63.68'
 AUTUMN FIELD COURT
 50' R/W

NOTE:
 This survey not to be
 used for property line
 establishment.

88-104

BRUNING 40-22 605-15-01

SURVEYOR'S CERTIFICATE

I hereby certify that the position of all existing improvements on the above described property have been carefully established by a transit-tape survey and that unless otherwise shown, there are no encroachments.

Raymond J. Leisawitz #304

Leisawitz

CLARK • FINEFROCK & SACKETT, INC.



ENGINEERS • PLANNERS • SURVEYORS
 7135 MINSTREL WAY COLUMBIA, MD. 21045
 (410) 381-7500-BALTO. • (301) 621-8100-WASH.

REFERENCE	DRAWN BY <i>KWC</i>	CHECKED BY <i>PAS</i>
Plat 89911	DATE 8-4-93	FILE NO. 4645-W
	SCALE 1"=30'	

NOTE: This Lot lies in Zone C, as shown on Flood Insurance Rate Map for Howard Co., Md., Map Panel 29 of 45, dated Dec. 4, 1986.

LOCATION OF HOUSE
 5438 AUTUMN FIELD COURT
 LOT 15
 STRAWBERRY FIELDS
 SECTION ONE AREA ONE
 LOTS 1 THRU 60
 1ST ELECTION DISTRICT
 HOWARD COUNTY, MARYLAND

Wall Check: 7-13-93
 F.F. Elev.: 388.4
 Final: 8-3-93

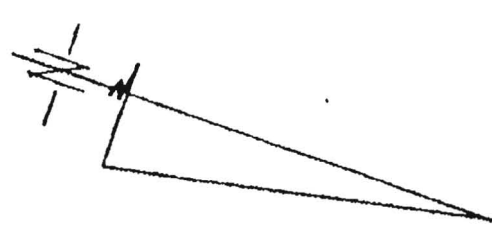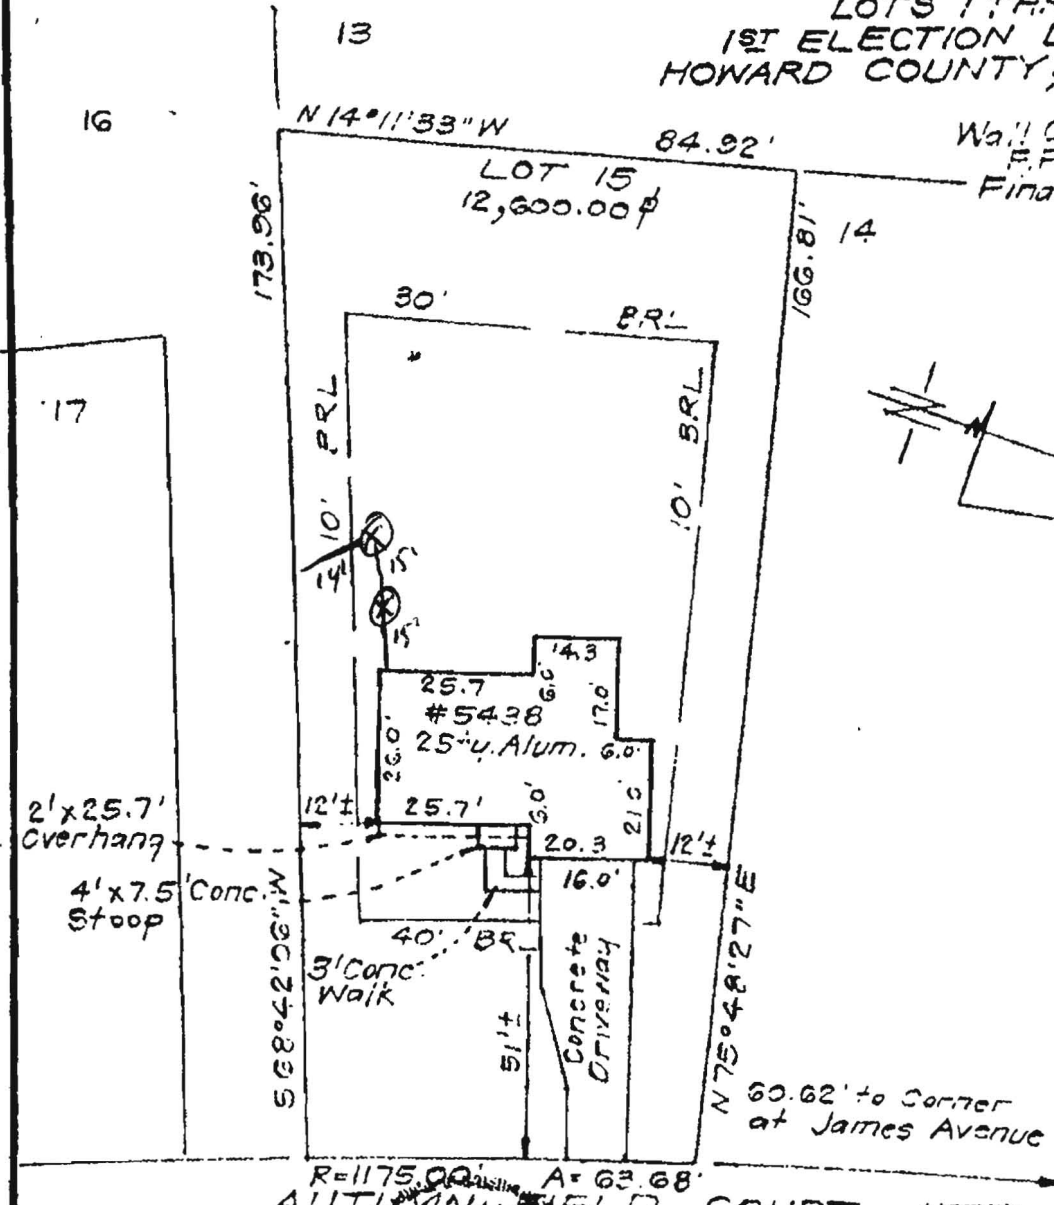

AUTUMN FIELD COURT
 50' R/W

NOTE:
 This survey not to be used for property line establishment.

88-104



BRUNING 40-22 60545-01

SURVEYOR'S CERTIFICATE
 I hereby certify that the position of all existing improvements on the above described property have been carefully established by a transit-tape survey and that unless otherwise shown, there are no encroachments.

Raymond Leisawitz #304

CLARK • FINEFROCK & SACKETT, INC.
 ENGINEERS • PLANNERS • SURVEYORS
 7135 MINSTREL WAY COLUMBIA, MD. 21045
 (410) 381-7500-BALTO. • (301) 621-8100-WASH.

REFERENCE	DRAWN BY KWC	CHECKED BY PAS
Plot 8991	DATE 8-4-93	FILE NO. 4645-W
	SCALE 1"=30'	

Leisawitz