

4/23/74 - 13' 5" vertical hole requested part 3 W. 1/2

10/10/74
9:30 A.M.

APPLICATION

A 09/11
P _____

12' SEWAGE DISPOSAL TESTING

MARYLAND STATE DEPARTMENT OF HEALTH
HOWARD COUNTY

ELLICOTT CITY
DISTRICT 5
DATE 11/23/64

Septic Tank - ¹⁰⁰⁰200 gal

Dry Well - 55' 2" depth around area below inlet pipe.

Inlet pipe must be 4' ft below grade.

Place Dry Well about 155 ft from front lot line and about 55 ft from left side line when facing lot from Brighton Road Ad.

TO: THE COUNTY HEALTH OFFICER
ELLICOTT CITY, MARYLAND

I, HEREBY, APPLY FOR THE NECESSARY TESTS IN ORDER TO CONSTRUCT OR RECONSTRUCT A SEWAGE DISPOSAL SYSTEM.

PROPERTY OWNER Herbert L. Harris
ADDRESS % Ashton Realty Co., Ashton, Md. PHONE VA 4-4822

PROPERTY LOCATION:

SUBDIVISION Hariland Hills LOT NO. 20, P1 & T1
ROAD AND DESCRIPTION Brighton Rd. Ad.

OCCUPANT _____ PHONE _____

PERSON TO CONSTRUCT SYSTEM _____
ADDRESS _____ PHONE _____

SIZE OF LOT approx. 2 acres TYPE BLDG. INDIVIDUAL RESIDENCE

IF NOT SINGLE RESIDENCE DESCRIBE _____

SIGNATURE OF APPLICANT Robert Johnson, Ashton Realty Co.
1910 Baltimore; Mr. Harland's Dry Well


APPROVED BY W. Murray FOR Dry Well DATE 11/23/64
KIND OF SYSTEM

REJECTED BY _____ FOR _____ DATE _____
KIND OF SYSTEM

HOLD PENDING FURTHER TESTS _____ DATE _____

REASONS FOR REJECTION OR HOLDING _____

THIS IS NOT A PERMIT

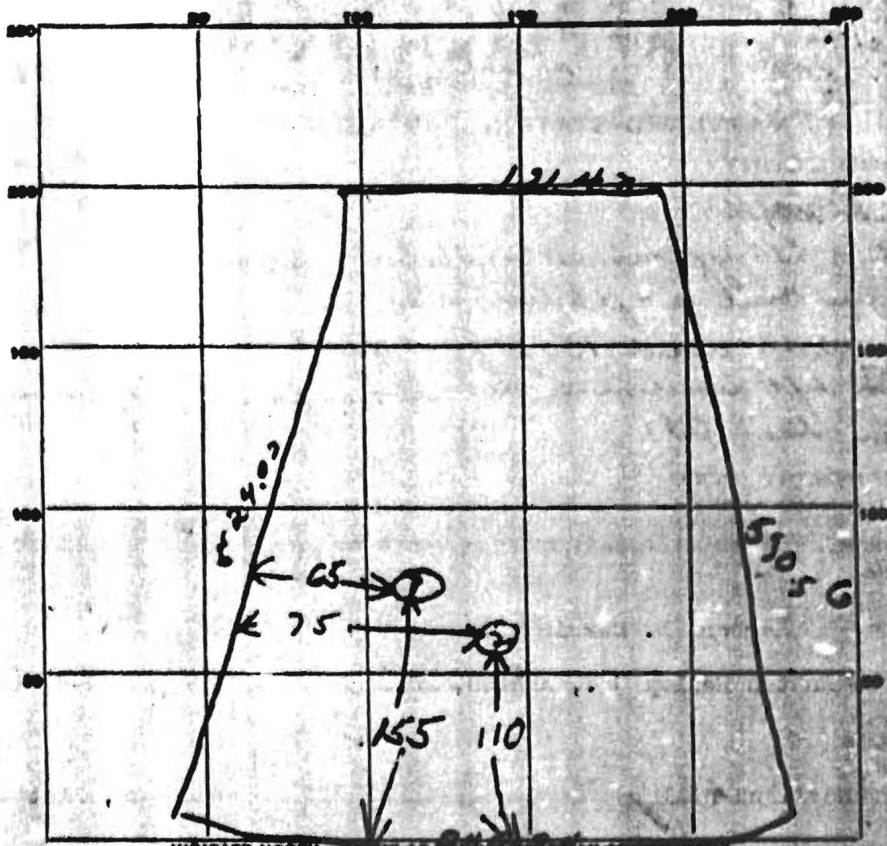

Brighton Ave

DATE	TEST NO.	DEPTH	PRE-WET		TEST - 1 st DROP		TIME	
			START	STOP	START	STOP		
10/1/74	1	10ft	113	122	132	140	18 min	
	2	11ft	125	139	139	205	26 min	
	10/10/74	Hole checked 12 1/2" deep - no water						
		had heavily washed with time						

SOIL AUGER FINDING *Just 4ft in clay*

TESTED BY *W. A. D. [unclear]*

REMARKS

ALSO PRESENT *H. L. Behrman, Capital Realty 29th St*