

LAYOUT 8/16/10 INSP 4 _____
INSP 2 8/17/10 INSP 5 _____
INSP 3 8/19/10 INSP 6 _____

ISSUE DATE: 8/16/2010

PERMIT - Repair

P 533966

APPROVAL DATE: 8/20/10

A Repair

Tax ID # 05407052

ON-SITE SEWAGE DISPOSAL SYSTEM HOWARD COUNTY HEALTH DEPARTMENT BUREAU OF ENVIRONMENTAL HEALTH

Zepp Plumbing & Heating, Inc. IS PERMITTED TO INSTALL ALTER

ADDRESS: _____ PHONE NUMBER: 410-531-6712

SUBDIVISION: Allnut Farms Est. LOT NUMBER: 29

ADDRESS: 13491 Allnut Lane PROPERTY OWNER: Mary Amtower

SEPTIC TANK CAPACITY (GALLONS): Ex. OUTLET BAFFLE FILTER REQUIRED

PUMP CHAMBER CAPACITY (GALLONS): N/A COMPARTMENTED TANK REQUIRED

NUMBER OF BEDROOMS: 4 5 APPLICATION RATE: _____

SQUARE FOOTAGE OF HOUSE: N/A Trenches: 2' wide, Inlet 3', Bottom 9'

LINEAR FEET OF TRENCH REQUIRED: 168 3 x 56' Trenches ~ 121 Ten stens.

TRENCHES:	Trenches to be <u>2</u> feet wide. Inlet <u>3</u> ' feet below original grade. Bottom maximum depth <u>9</u> ' feet below grade. Effective area begins at <u>5</u> feet below original grade. <u>6</u> feet of stone below distribution pipe.
LOCATION:	A Layout inspection is required for correct placement and verification of trench locations.
NOTES:	Manhole access needs to be installed on the tank if not already. Observation pipes must be installed on ends of trenches. <i>* System sized for 5 BR per homeowner</i>

PLANS APPROVED: K. M. Wolf DATE: 8/16/2010

- NOTE: PERMIT VOID AFTER 2 YEARS
- NOTE: CONTRACTOR RESPONSIBLE FOR SCHEDULING A PRE-CONSTRUCTION INSPECTION FOR ALL INSTALLATIONS
- NOTE: WATERTIGHT SEPTIC TANKS REQUIRED
- NOTE: ALL PARTS OF SEPTIC SYSTEM SHALL BE 100 FEET FROM ANY WATER WELL
- NOTE: MANHOLE RISERS REQUIRED ON ALL SEPTIC TANKS AND PUMP CHAMBERS


NEITHER THE HOWARD COUNTY COUNCIL OR THE HEALTH DEPARTMENT IS RESPONSIBLE FOR THE SUCCESSFUL OPERATION OF ANY SYSTEM PERMITTEE RESPONSIBLE FOR OBTAINING FINAL APPROVAL ON THIS PERMIT CALL 410-313-1771 FOR INSPECTION OF SEPTIC SYSTEM

Golden Corn Dr.

HO-81-1193

Ex Well

NOT TO SCALE

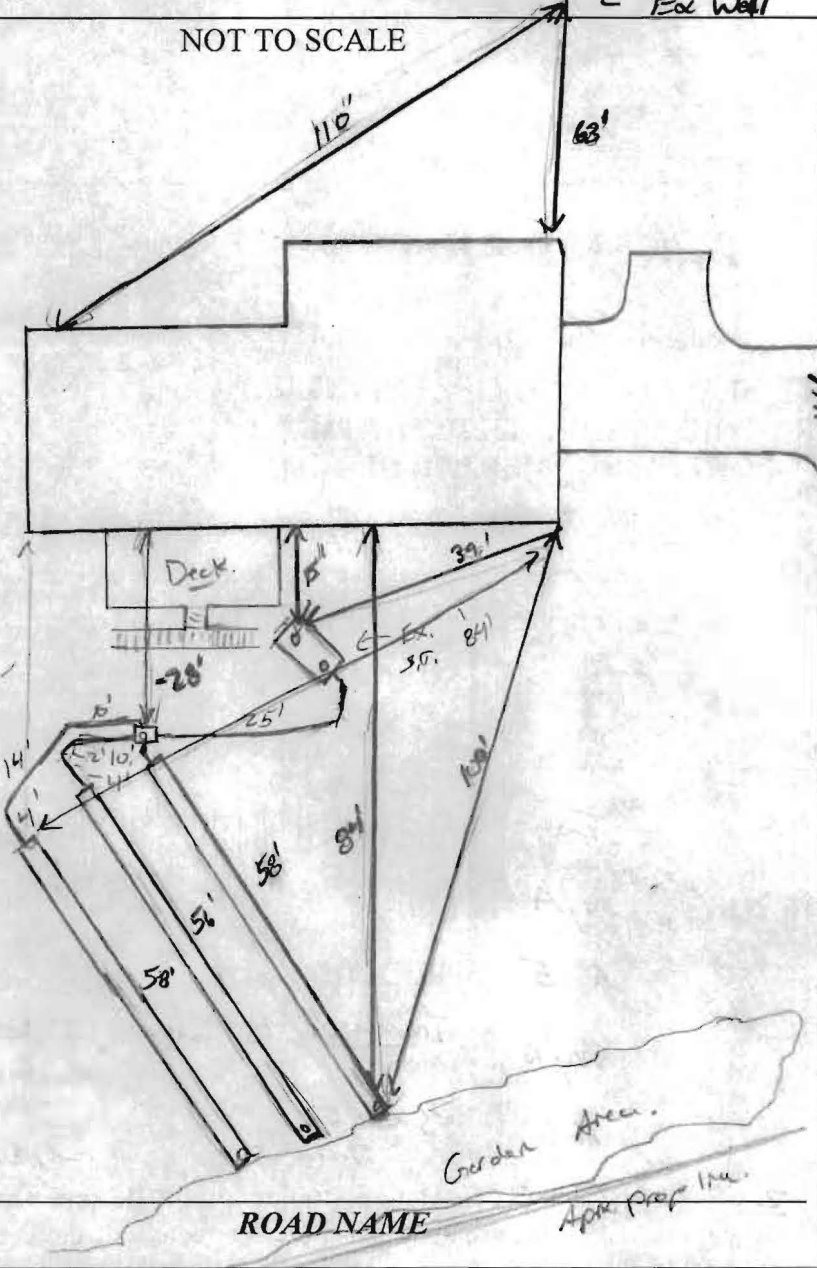

TRENCH/DRAINFIELD DATA

WIDTH	INLET	BOTTOM
2'	3'	9'
NUMBER OF TRENCHES		3
TOTAL LENGTH _____		
ABSORPTION AREA _____		
DISTRIBUTION BOX LEVEL		Level
DISTRIBUTION BOX BAFFLE		Yes
DISTRIBUTION BOX PORT		Yes

SEPTIC TANK DATA

SEPTIC TANK 1 LEVEL	Yes
MANUFACTURER	?
CAPACITY	1500 GAL
SEAM LOC	no - mid
TANK LID DEPTH	2'
BAFFLES	Yes Concrete
BAFFLE FILTER	—
MANHOLE LOC	none
6" PORT LOC	Front/Rear (ok)
WATERTIGHT TEST	—
SLOTTED	no
DATE ON LID	—
PUMP/SEPTIC TANK LEVEL _____	
MANUFACTURER _____	
CAPACITY _____ GAL	
SEAM LOC _____	
TANK LID DEPTH _____	
BAFFLES _____	
BAFFLE FILTER _____	
MANHOLE LOC _____	
6" PORT LOC _____	
WATERTIGHT TEST _____	
SLOTTED _____	
DATE ON LID _____	

PRE-CONSTRUCTION:

8/16/10 All trenches dig up @ time of perc test. Install 3x56' trenches on contour pointed in field just below existing system. Old system will be abandoned. (JW)

INSTALLATION:

8/17/10 Top trench installed. Need to punch into ex. tank and into Dbox. OK to continue (JW)
 8/19/10 2nd trench complete. Dbox set, plumbing to Top 2 trenches installed. Contractor digging bottom trench too close to middle trench. Told him to straighten trench out to make 9' c/c. (JW)
 8/20/10 system complete. OK to backfill

FINAL INSPECTOR

Jh. Way

DATE OF APPROVAL

8/20/10