

B 1 1948 SEQUENCE NO. (MDE USE ONLY) STATE OF MARYLAND PERMIT TO DRILL WELL please print or type STATE PERMIT NUMBER HO-94-2384
70 fill in this form completely 79

OWNER INFORMATION
 Date Received (APA) 08.30.99
 8 MM DD YY 13
 15 Last Name Trinity Builders Owner First Name 34
 36 Street or RFD 6212 Devon Dr. 55
 57 Town Columbia 70 State MD 72 Zip 21044 76

LOCATION OF WELL
B 3 8 COUNTY Howard 21
 23 SUBDIVISION Woodlands Grant # 42
 SECTION - 44 46 LOT 6 48 50
 52 NEAREST TOWN MARIOTTSVILLE 71
 MILES FROM TOWN (enter 0 if in town) 2 M I I
 73 76 77 78

DRILLER INFORMATION
 76 Driller's Name Ralph Mayne M S D I I G License No. 81
 Firm Name Ralph Mayne Well Drilling
 Address 9120 Brown Church Rd Mt Airy
 Signature Ralph Mayne Date 8.30.99

B 4 1 2 DIRECTION OF WELL FROM TOWN (CIRCLE BOX)
 11 NEAR WHAT ROAD Banley Field way 30
 ON WHICH SIDE OF ROAD (CIRCLE APPROPRIATE BOX)
 NORTH N WEST W EAST E SOUTH S
 34 800 37 DISTANCE FROM ROAD 800 38 39
 ENTER FT OR MI FT
 TAX MAP: 10 BLK: 16 PARCEL 30

WELL INFORMATION
 1 2 APPROX. PUMPING RATE 5 GAL. PER MIN. 12
 AVERAGE DAILY QUANTITY NEEDED 500 GAL. PER DAY 14 20

USE FOR WATER (CIRCLE APPROPRIATE BOX)
 DOMESTIC POTABLE SUPPLY & RESIDENTIAL IRRIGATION
 FARMING (LIVESTOCK WATERING & AGRICULTURAL IRRIGATION)
 INDUSTRIAL, COMMERCIAL, DEWATERING
 PUBLIC WATER SUPPLY WELL
 TEST, OBSERVATION, MONITORING
 GEO-THERMAL


NOT TO BE FILLED IN BY DRILLER HEALTH DEPARTMENT APPROVAL
Howard Co COUNTY NAME COUNTY NO. A57555E
 STATE SIGNATURE _____ INSERT S → 41
 DATE ISSUED 083199 A McM... 083100
 43 MM DD YY 48 CO SIGNATURE EXP. DATE
 NORTH GRID 543 000 EAST GRID 827 000
 50 55 57 63

APPROXIMATE DEPTH OF WELL 150 FEET 24 28
 APPROXIMATE DIAMETER OF WELL 64 INCH NEAREST

SHOW MAJOR FEATURES OF BOX & LOCATE WELL WITH AN X
 SOURCES OF DRILLING WATER
 1. wee
 2.
 3.
 WRITE THE BOX NUMBER FROM THE MAP HERE
 E 827 000
 N 543 000

METHOD OF DRILLING (circle one)
 BORED (or Augered) JETTED Jetted & DRIVEN
 30 AIR-ROTary AIR-PERCussion ROTARY (Hydraulic Rotary)
 37 CABLE REVERSE-ROTary DRIVE-POINT
 other _____

REPLACEMENT OR DEEPEMED WELLS (CIRCLE APPROPRIATE BOX)
 THIS WELL WILL NOT REPLACE AN EXISTING WELL
 THIS WELL WILL REPLACE A WELL, THAT WILL BE ABANDONED AND SEALED
 THIS WELL WILL REPLACE A WELL THAT WILL BE USED AS A STANDBY-CONTACT LOCAL APPROVING AUTHORITY FOR POLICY ON STANDBY WELLS
 THIS WELL WILL DEEPEM AN EXISTING WELL
 PERMIT NUMBER OF WELL TO BE REPLACED OR DEEPEMED (IF AVAILABLE) 41 _____ 52

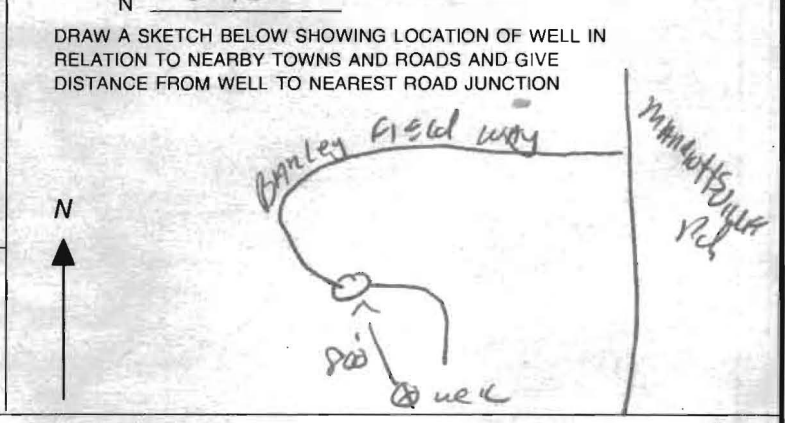

Not to be filled in by driller (MDE OR COUNTY USE ONLY)
 APPROX. PERMIT NUMBER 54 _____ 63
 PERMIT No. HO-94-2384
 70 71 72 73 74 75 76 77 78 79

