

B 1 4793 SEQUENCE NO. - (MDE USE ONLY)

1 2 3 6

STATE OF MARYLAND
 PERMIT TO DRILL WELL
 please print or type

STATE PERMIT NUMBER
HO-94-1769
 70 fill in this form completely 79

Date Received (APA) 09 11 98
 8 MM DD YY 13

OWNER INFORMATION

WOODFORD'S EAST LLC
 15 Last Name Owner First Name 34

6212 DeWoo DR.
 36 Street or RFD 55

Columbin MD 21044
 57 Town 70 State 72 Zip 76

B 3 Howard LOCATION OF WELL

8 COUNTY 21

WOODFORD'S GRANT #
 23 SUBDIVISION 42

SECTION 44 LOT 6
 44 46 48 50

MARIOTTSVILLE
 52 NEAREST TOWN 71

MILES FROM TOWN (enter 0 if in town) 2 M I J
 73 76 77 78


DRILLER INFORMATION

Ralph MAYNE M S D J I G
 Driller's Name 76 License No. 81

Ralph MAYNE Well Drilling
 Firm Name

9120 Brown Church Rd. Mt Airy
 Address

Ralph Mayne 9-9-98
 Signature Date

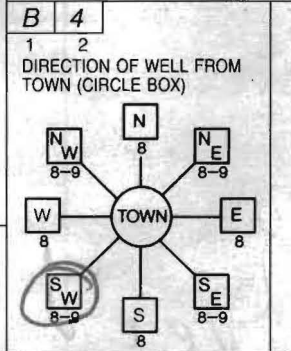

Barley Field Way
 11 NEAR WHAT ROAD 30

ON WHICH SIDE OF ROAD (CIRCLE APPROPRIATE BOX)

34 800 37 DISTANCE FROM ROAD 38 39
 ENTER FT OR MI

TAX MAP: 10 BLK: 16 PARCEL 30

B 2 WELL INFORMATION

1 2 APPROX. PUMPING RATE (GAL. PER MIN.) 5

AVERAGE DAILY QUANTITY NEEDED (GAL. PER DAY) 500
 14 20

USE FOR WATER (CIRCLE APPROPRIATE BOX)

DOMESTIC POTABLE SUPPLY & RESIDENTIAL IRRIGATION
 FARMING (LIVESTOCK WATERING & AGRICULTURAL IRRIGATION)
 INDUSTRIAL, COMMERCIAL, DEWATERING
 PUBLIC WATER SUPPLY WELL
 TEST, OBSERVATION, MONITORING
 GEO-THERMAL

22

NOT TO BE FILLED IN BY DRILLER HEALTH DEPARTMENT APPROVAL

Howard COUNTY NAME COUNTY NO. A57555-E

STATE SIGNATURE _____ INSERT S → S

DATE ISSUED 09 28 98 Mark E. Larkin 9/28/99
 43 MM DD YY 48 CO SIGNATURE EXP. DATE

NORTH GRID 543 0 0 0 EAST GRID 0827 0 0 0
 50 55 57 63

APPROXIMATE DEPTH OF WELL 150 FEET
 24 28

APPROXIMATE DIAMETER OF WELL 6" NEAREST INCH

SHOW MAJOR FEATURES OF BOX & LOCATE WELL WITH AN X 10:00 10/2/98

SOURCES OF DRILLING WATER
 1. well
 2.
 3.

WRITE THE BOX NUMBER FROM THE MAP HERE

E 82x7
 N 5x43

000
 000

Complete @ time of 10:00 A

METHOD OF DRILLING (circle one)

BORED (or Augered) JETTED Jetted & DRIVEN

AIR-ROTary AIR-PERcussion ROTARY (Hydraulic Rotary)

CABLE REVERSE-ROTary DRIVE-POINT

other _____

REPLACEMENT OR DEEPEMED WELLS (CIRCLE APPROPRIATE BOX)


THIS WELL WILL NOT REPLACE AN EXISTING WELL
 THIS WELL WILL REPLACE A WELL THAT WILL BE ABANDONED AND SEALED
 THIS WELL WILL REPLACE A WELL THAT WILL BE USED AS A STANDBY-CONTACT LOCAL APPROVING AUTHORITY FOR POLICY ON STANDBY WELLS
 THIS WELL WILL DEEPEM AN EXISTING WELL

PERMIT NUMBER OF WELL TO BE REPLACED OR DEEPEMED (IF AVAILABLE) 41 _____ 52

Not to be filled in by driller (MDE OR COUNTY USE ONLY)

APPROP. PERMIT NUMBER 54 _____ 63

PERMIT No. HO-94-1769
 70 71 72 73 74 75 76 77 78 79

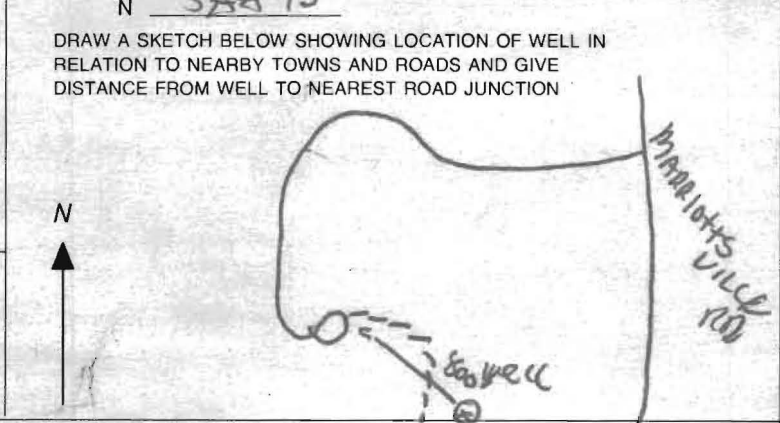

SPECIAL CONDITIONS
 NOTE - APPROVING AUTHORITIES SHOULD USE SEPARATE SHEET IF NEEDED -

C 1 4305

SEQUENCE NO. (MDE USE ONLY)

STATE OF MARYLAND WELL COMPLETION REPORT

THIS REPORT MUST BE SUBMITTED AFTER WELL IS COMPLETED.

COUNTY NUMBER 157555-E

ST/CO USE ONLY DATE Received

DATE WELL COMPLETED

Depth of Well

PERMIT NO. FROM "PERMIT TO DRILL WELL" HO-94-1769

OWNER Woodfords East LLC STREET OR RFD Barley Field Way TOWN Marriottsville SUBDIVISION WOODFORDS GRANT II SECTION LOT 6

WELL LOG table with columns: DESCRIPTION, FEET (FROM, TO), check if water bearing. Includes entries for Top Soil, sandy, Sand Stone, MICKR, Sand Stone, MICKR.

GROUTING RECORD form with fields for WELLS HAS BEEN GROUTED, TYPE OF GROUTING MATERIAL, CEMENT, BENTONITE CLAY, NO. OF BAGS, NO. OF POUNDS, GALLONS OF WATER, DEPTH OF GROUT SEAL.

CASING RECORD form with fields for casing types, MAIN CASING TYPE, Nominal diameter, Total depth.

OTHER CASING (if used) form with fields for diameter, depth.

SCREEN RECORD form with fields for screen type, diameter, depth.

PUMPING TEST form with fields for HOURS PUMPED, PUMPING RATE, METHOD USED, WATER LEVEL, TYPE OF PUMP USED.

NUMBER OF UNSUCCESSFUL WELLS: 0

WELL HYDROFRACTURED Y N

CIRCLE APPROPRIATE LETTER A WELL WAS ABANDONED AND SEALED WHEN THIS WELL WAS COMPLETED

DRILLERS LIC. NO. MSD 116 DRILLERS SIGNATURE Paul E. Wayne

SITE SUPERVISOR (sign. of driller or journeyman responsible for sitework if different from permittee)

DEPTH (nearest ft.) table with columns for depth ranges and casing height (+/-).

GRAVEL PACK IF WELL DRILLED WAS FLOWING WELL INSERT F IN BOX 68

MDE USE ONLY (NOT TO BE FILLED IN BY DRILLER) T (E.R.O.S.) W Q

PUMP INSTALLED form with fields for DRILLER INSTALLED PUMP, TYPE OF PUMP INSTALLED, CAPACITY, PUMP HORSE POWER, PUMP COLUMN LENGTH, CASING HEIGHT.

