

4137

SEQUENCE NO. (MDE USE ONLY)

STATE OF MARYLAND WELL COMPLETION REPORT

FILL IN THIS FORM COMPLETELY PLEASE TYPE

THIS REPORT MUST BE SUBMITTED AFTER WELL IS COMPLETED.

COUNTY NUMBER A50830 U

ST/CO USE ONLY

DATE RECEIVED 5 12 99

DATE WELL COMPLETED

3 3 99

DEPTH OF WELL

260 (TO NEAREST FOOT)

PERMIT NO. FROM "PERMIT TO DRILL WELL"

HO-94-1934

OWNER: Brantwood LLC, STREET OR RFD: Argent Path, TOWN: Ellicott City MD, SUBDIVISION: Brantwood, SECTION: I, LOT: 23

WELL LOG Not required for driven wells

STATE THE KIND OF FORMATIONS PENETRATED, THEIR COLOR, DEPTH, THICKNESS AND IF WATER BEARING

Table with columns: DESCRIPTION, FEET (FROM, TO), check if water bearing. Rows: BROWN SHALE 0-50, BLUE SLATE 50-200. Includes handwritten note: WATER AT 90-190.

GROUTING RECORD

WELL HAS BEEN GROUTED (Y), TYPE OF GROUTING MATERIAL (CM), NO. OF BAGS 15, NO. OF POUNDS 1410, GALLONS OF WATER 90, DEPTH OF GROUT SEAL 59 ft.

CASING RECORD

MAIN CASING TYPE (ST), Nominal diameter top (main) casing 6, Total depth of main casing 60.

OTHER CASING (if used) diameter, depth (feet) from to

SCREEN RECORD

screen type or open hole (ST), DEPTH (nearest ft.) 159, 200.

NUMBER OF UNSUCCESSFUL WELLS: 0

WELL HYDROFRACTURED (Y)

CIRCLE APPROPRIATE LETTER: A, E, P

I HEREBY CERTIFY THAT THIS WELL HAS BEEN CONSTRUCTED IN ACCORDANCE WITH COMAR 26.04.04 "WELL CONSTRUCTION" AND IN CONFORMANCE WITH ALL CONDITIONS STATED IN THE ABOVE CAPTIONED PERMIT...

DRILLERS LIC. NO. MW D 139, Robert Clune, DRILLERS SIGNATURE

LIC. NO. MW D 168, Rick Sogole

SITE SUPERVISOR (sign. of driller or journeyman responsible for sitework if different from permittee)

DEPTH (nearest ft.)

159, 200

SLOT SIZE 1, 2, 3

DIAMETER OF SCREEN (NEAREST INCH) 56, 60

GRAVEL PACK IF WELL DRILLED WAS FLOWING WELL INSERT F IN BOX 68

MDE USE ONLY (NOT TO BE FILLED IN BY DRILLER) T (E.R.O.S.) W Q

TELESCOPE CASING, LOG INDICATOR, OTHER DATA

PUMPING TEST

HOURS PUMPED (nearest hour) 3, PUMPING RATE (gal. per min.) 10, METHOD USED TO MEASURE PUMPING RATE TIME, WATER LEVEL (distance from land surface) BEFORE PUMPING 33 ft., WHEN PUMPING 57 ft., TYPE OF PUMP USED (for test) S submersible

PUMP INSTALLED

DRILLER INSTALLED PUMP (YES or NO) YES, IF DRILLER INSTALLS PUMP, THIS SECTION MUST BE COMPLETED FOR ALL WELLS.

TYPE OF PUMP INSTALLED PLACE (A,C,J,P,R,S,T,O) IN BOX 29

CAPACITY: GALLONS PER MINUTE (to nearest gallon) 31, 35


PUMP HORSE POWER 37, 41

PUMP COLUMN LENGTH (nearest ft.) 43, 47

CASING HEIGHT (circle appropriate box and enter casing height) (+) above, (-) below

LAND SURFACE 1 (nearest foot)

LOCATION OF WELL ON LOT SHOW PERMANENT STRUCTURES AND INDICATE NOT LESS THAN TWO DISTANCES (MEASUREMENTS TO WELL)

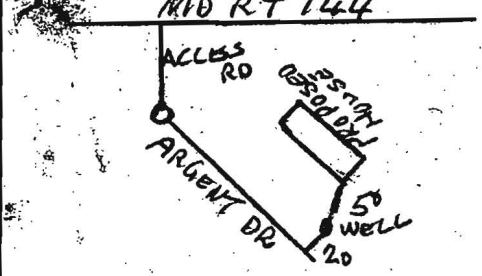

LOT 23 Brantwood


Pool -

THIS LIMITED POOL INTRODUCTION CAN BE MADE UP ON LEFT SIDE OF LOT.

NO SLOTTED MAKE-UP SHOULD BE IN THIS AREA (TEST HOLES FOR WATER TABLE)

Will be back with specific plan

Be sure house footprint matches BR plan no additional slope area can be lost.

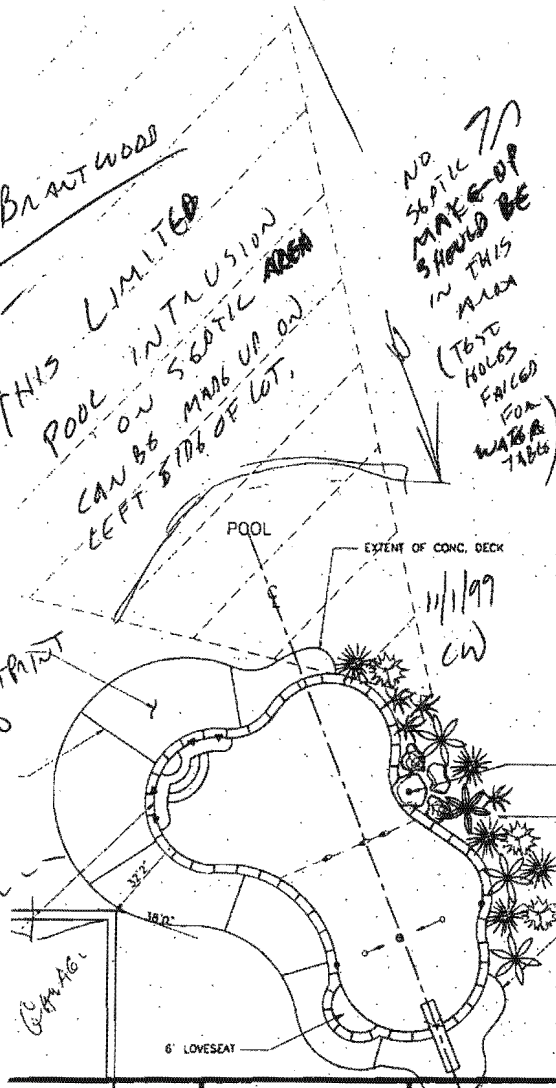

- STEEL CREW:
- GUMITE CREW:
- COPING & TILE:
- DECK CREW:
- PLASTER CREW:

EQUIPMENT LIST

- DIRT:
- TILE:
- COPING:
- STEPS:
- PLASTER:
- FILTER:
- SAFETY EQ:
- CLEANING EQ:
- VACUUM EQ:
- DIVING EQ:
- LADDERS:
- GRABRAILS:
- LIGHTS:
- WATTS:
- HEATER:
- SPA:
- LOVESEATS:
- DECKING:
- POOL COVER - WINTER:
- SOLAR:
- AUTO:
- FENCE:
- OTHER ITEMS:

STYLE:


VOLTS:

RECEIVED

NOV 01 1999


HOWARD COUNTY HEALTH DEPARTMENT  
BUREAU OF ENVIRONMENTAL HEALTH

POOL DATA	
SIZE: 27'x40'	SHAPE: CUSTO
AREA - POOL: 688 + L. SEAT	OTHER:
TOTAL Sq. Ft.: 700	L. SEAT - 1:
PERIMETER - POOL: 116	OTHER:
GALLONAGE: 29,700	

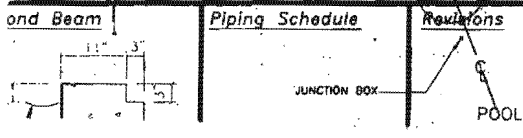

NAME: DAVE & MARIA VANSTONE  
ADDRESS: 3105 ARGENT PATH  
CITY: ELLICOTT CITY, MARYLAND 21043  
COUNTY: HOWARD ZONE: 1

Maryland State Archives

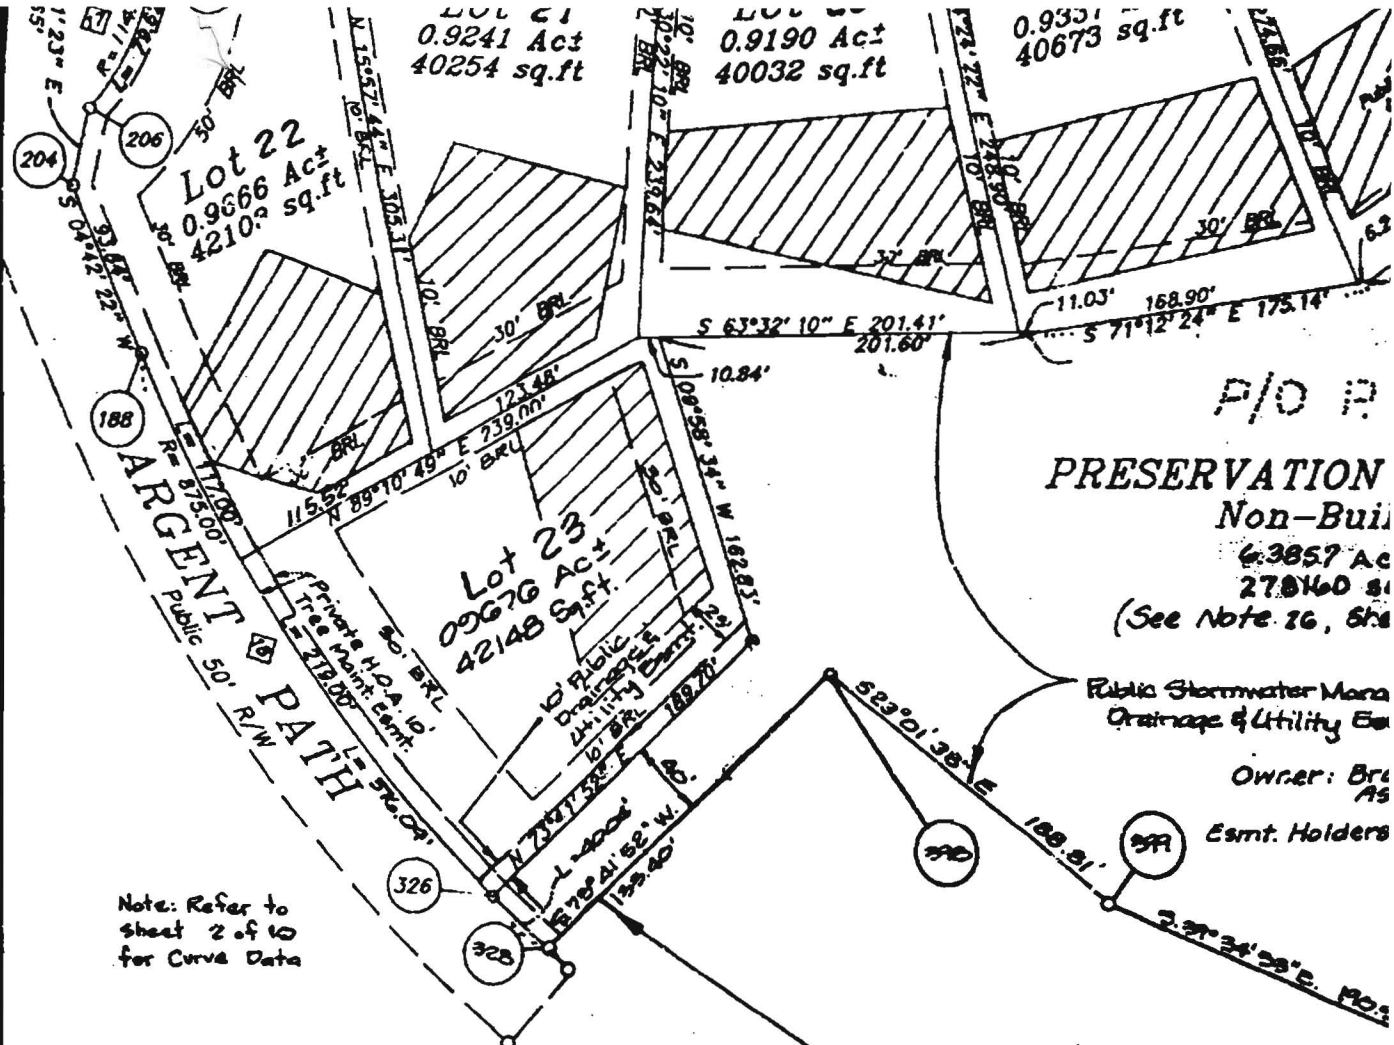

Note: Refer to sheet 2 of 10 for Curve Data

LEGEND

- Iron Pipe/Rebar Found
- Stone/Concrete Monument Found
- Rebar w/ Identification Cap Set
- Concrete Monument Set

The requirements § 3-108, The Real Property Article, Annotated Code of Maryland, 1988 replacement volume, (as supplemented) as far as they relate to the making of this map and the setting of markers have been complied with.

*D. Wayne Weller*  
D. Wayne Weller MD Reg No. 10885  
*David A. Cooper*  
David A. Cooper Trustee

12/10/98  
Date

Environmental/Easement  
Stream  
Nontidal Wetlands/C  
25' Wetland Buffer  
75' Stream Buffer  
100 Year Flood Plain  
100 Year Flood Plain  
Forest Conservation  
Easement/Corridor

Show well  
swm easement/  
pipe  
5' - back prop line  
- stay 10' from  
occupied prop.  
- letter statures