

C1 0159

SEQUENCE NO. (MDE USE ONLY)

STATE OF MARYLAND WELL COMPLETION REPORT

THIS REPORT MUST BE SUBMITTED WITHIN 45 DAYS AFTER WELL IS COMPLETED.

(THIS NUMBER IS TO BE PUNCHED IN COLS. 3-6 ON ALL CARDS)

COUNTY NUMBER AS20847

ST/CO USE ONLY DATE Received

DATE WELL COMPLETED 12 22 85

Depth of Well 600 (TO NEAREST FOOT)

PERMIT NO. FROM "PERMIT TO DRILL WELL" HO-95-0186

OWNER: Rachuba Home Builders, last name first name; STREET OR RFD: 26. Nulhain Rd; TOWN: Windbine; SUBDIVISION: SECTION 722/223 LOT P.P.

WELL LOG Not required for driven wells

STATE THE KIND OF FORMATIONS PENETRATED, THEIR COLOR, DEPTH, THICKNESS AND IF WATER BEARING

Table with columns: DESCRIPTION (Use additional sheets if needed), FEET (FROM, TO), check if water bearing. Entries: Brown shale 0-72, Gray Limestone 72-600.

GROUTING RECORD

WELL HAS BEEN GROUTED (Y) (N); TYPE OF GROUTING MATERIAL: CEMENT (CM), BENTONITE CLAY (BC); NO. OF BAGS: 60; NO. OF POUNDS: 5040; GALLONS OF WATER: 360; DEPTH OF GROUT SEAL: 0-77 ft.

CASING RECORD: MAIN CASING TYPE: ST (STEEL); Nominal diameter top (main) casing: 06; Total depth of main casing: 81.

OTHER CASING (if used) diameter depth (feet) from to

SCREEN RECORD: screen type or open hole: HO (OTHER HOLE); insert appropriate code below.

NUMBER OF UNSUCCESSFUL WELLS: 0

WELL HYDROFRACTURED: (Y) (N)

CIRCLE APPROPRIATE LETTER: A (WELL WAS ABANDONED AND SEALED WHEN THIS WELL WAS COMPLETED); E (ELECTRIC LOG OBTAINED); P (TEST WELL CONVERTED TO PRODUCTION WELL)

I HEREBY CERTIFY THAT THIS WELL HAS BEEN CONSTRUCTED IN ACCORDANCE WITH COMAR 26.04.04 "WELL CONSTRUCTION" AND IN CONFORMANCE WITH ALL CONDITIONS STATED IN THE ABOVE CAPTIONED PERMIT...

DRILLERS LIC. NO.: MSD 009; DRILLERS SIGNATURE: [Signature]; LIC. NO.: D

SITE SUPERVISOR (sign. of driller or journeyman responsible for sitework if different from permittee)

DEPTH (nearest ft.) table with columns 1-11 and rows A-C, S-E, N. Values: 80, 81, 600.

SLOT SIZE 1 2 3; DIAMETER OF SCREEN (NEAREST INCH) 58 60; from to

GRAVEL PACK IF WELL DRILLED WAS FLOWING WELL INSERT F IN BOX 68

MDE USE ONLY (NOT TO BE FILLED IN BY DRILLER) T (E.R.O.S.) W Q

TELESCOPE CASING LOG INDICATOR OTHER DATA


PUMPING TEST

HOURS PUMPED (nearest hour) 06; PUMPING RATE (gal. per min.) 1.7; METHOD USED TO MEASURE PUMPING RATE 1 gal.; WATER LEVEL (distance from land surface) BEFORE PUMPING 30 ft. WHEN PUMPING 99 ft. TYPE OF PUMP USED (for test): A (air), P (piston), T (turbine), C (centrifugal), R (rotary), O (other), J (jet), S (submersible)

PUMP INSTALLED

DRILLER INSTALLED PUMP (CIRCLE) YES (NO); IF DRILLER INSTALLS PUMP, THIS SECTION MUST BE COMPLETED FOR ALL WELLS. TYPE OF PUMP INSTALLED PLACE (A,C,J,P,R,S,T,O) IN BOX 29. CAPACITY: GALLONS PER MINUTE (to nearest gallon) 31 35. PUMP HORSE POWER 37 41. PUMP COLUMN LENGTH (nearest ft.) 43 47. CASING HEIGHT (circle appropriate box and enter casing height) above 49 below 49. LAND SURFACE 02 (nearest foot)

LOCATION OF WELL ON LOT SHOW PERMANENT STRUCTURE SUCH AS BUILDING, SEPTIC TANKS, AND /OR LANDMARKS AND INDICATE NOT LESS THAN TWO DISTANCES (MEASUREMENTS TO WELL)

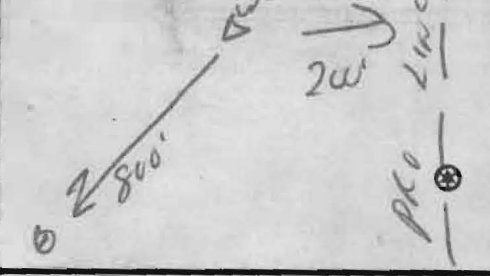

B 1 1002

SEQUENCE NO. (MDE USE ONLY)

STATE OF MARYLAND APPLICATION FOR PERMIT TO DRILL WELL please type

STATE PERMIT NUMBER

HD - 95 - 0186 fill in this form completely

Date Received (APA)

OWNER INFORMATION

8 MM DD YY 13

Rachuba Home Builders Last Name Owner First Name 34 946-A Macinich Ct. Street or RFD 55 Eldersburg MD 21784 Town 70 State 72 Zip 76

B 3

LOCATION OF WELL


8 COUNTY Howard 21 A.E. Mullinix Road Rd. 23 SUBDIVISION Preservation Parcel SECTION 44 46 LOT 48 50 Woodbine 52 NEAREST TOWN 71 MILES FROM TOWN (enter 0 if in town) 5 M I 73 76 77 78

DRILLER INFORMATION

Allen Compton M S D 009 Driller's Name 76 License No. 81 Eagles Well Drilling Firm Name 580 Obrecht Rd Address Signature Date 11-2-05

B 4

1 2 DIRECTION OF WELL FROM TOWN (CIRCLE BOX)

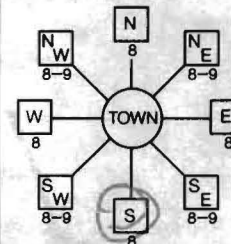

116780 AE Mullinix Rd. NEAR WHAT ROAD 30 ON WHICH SIDE OF ROAD (CIRCLE APPROPRIATE BOX) NORTH SOUTH WEST EAST DISTANCE FROM ROAD 800 ENTER FT OR MI 38 39 TAX MAP: 7 BLK: 22 PARCEL 323

B 2

WELL INFORMATION

APPROX. PUMPING RATE 5 (GAL. PER MIN.) 8 12 AVERAGE DAILY QUANTITY NEEDED 500 (GAL. PER DAY) 14 20

USE FOR WATER (CIRCLE APPROPRIATE BOX)

- DOMESTIC POTABLE SUPPLY & RESIDENTIAL IRRIGATION (circled) FARMING (LIVESTOCK WATERING & AGRICULTURAL IRRIGATION) INDUSTRIAL, COMMERCIAL, DEWATERING PUBLIC WATER SUPPLY WELL TEST, OBSERVATION, MONITORING GEO-THERMAL

NOT TO BE FILLED IN BY DRILLER HEALTH DEPARTMENT APPROVAL

Howard COUNTY NAME A520847 COUNTY NO. STATE SIGNATURE INSERT S DATE ISSUED 12/17/05 CO SIGNATURE 12/17/06 EXP. DATE NORTH GRID 542000 EAST GRID 775 000 50 55 57 63

APPROXIMATE DEPTH OF WELL 300 FEET 24 28

APPROXIMATE DIAMETER OF WELL 6 INCH NEAREST INCH

METHOD OF DRILLING (circle one)

BORED (or Augered) JETTED Jetted & DRIVEN AIR-ROTary AIR-PERcussion ROTARY (Hydraulic Rotary) CABLE REVerse-ROTary DRive-POINT other

REPLACEMENT OR DEEPEMED WELLS (CIRCLE APPROPRIATE BOX)

- THIS WELL WILL NOT REPLACE AN EXISTING WELL (circled) THIS WELL WILL REPLACE A WELL THAT WILL BE ABANDONED AND SEALED THIS WELL WILL REPLACE A WELL THAT WILL BE USED AS A STANDBY-CONTACT LOCAL APPROVING-AUTHORITY FOR POLICY ON STANDBY WELLS THIS WELL WILL DEEPEMED AN EXISTING WELL PERMIT NUMBER OF WELL TO BE REPLACED OR DEEPEMED (IF AVAILABLE) 41 52

SHOW MAJOR FEATURES OF BOX & LOCATE WELL WITH AN X


SOURCES OF DRILLING WATER

- 1. 2. 3.

WRITE THE BOX NUMBER FROM THE MAP HERE

E 7705 N 5402

DRAW A SKETCH BELOW SHOWING LOCATION OF WELL IN RELATION TO NEARBY TOWNS AND ROADS AND GIVE DISTANCE FROM WELL TO NEAREST ROAD JUNCTION

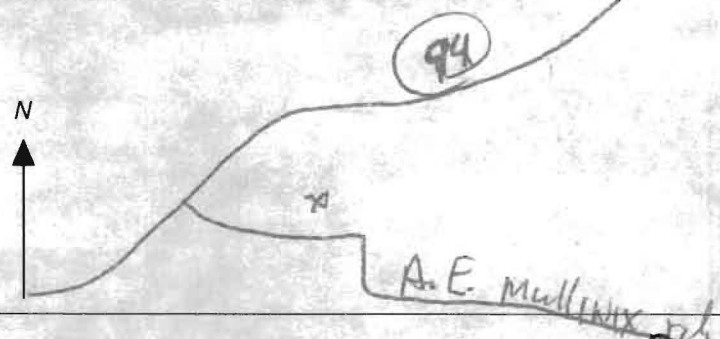

Not to be filled in by driller (MDE OR COUNTY USE ONLY)

APPROP. PERMIT NUMBER G PERMIT No. HD - 95 - 0186 70 71 72 73 74 75 76 77 78 79

SPECIAL CONDITIONS

NOTE - APPROVING AUTHORITIES SHOULD USE SEPARATE SHEET IF NEEDED

(MDE USE ONLY)

STATE OF MARYLAND WELL COMPLETION REPORT

FILL IN THIS FORM COMPLETELY
PLEASE TYPE

THIS REPORT MUST BE SUBMITTED WITHIN
45 DAYS AFTER WELL IS COMPLETED.

COUNTY
NUMBER

(THIS NUMBER IS TO BE PUNCHED
IN COLS. 3-6 ON ALL CARDS)

ST/CO USE ONLY

DATE Received

MM DD YY
8 13

DATE WELL COMPLETED

MM DD YY
7 27 85

Depth of Well

22 600 26
(TO NEAREST FOOT)

PERMIT NO.
FROM "PERMIT TO DRILL WELL"

28 29 30 31 32 33 34 35 36 37

OWNER

STREET OR RFD

SUBDIVISION

last name

first name

TOWN

SECTION

LOT

WELL LOG

Not required for driven wells

STATE THE KIND OF FORMATIONS PENETRATED, THEIR
COLOR, DEPTH, THICKNESS AND IF WATER BEARING

DESCRIPTION (Use
additional sheets if needed)

FEET
FROM TO

check
if water
bearing

DESCRIPTION (Use additional sheets if needed)	FEET FROM	TO	check if water bearing
Brown shale	0	72	
Gravel	72	600	

GROUTING RECORD

yes no
Y N
44 44

WELL HAS BEEN GROUTED
(Circle Appropriate Box)

TYPE OF GROUTING MATERIAL (Circle one)

CEMENT **CM** BENTONITE CLAY **BC**

NO. OF BAGS 60 NO. OF POUNDS 5400

GALLONS OF WATER 500

DEPTH OF GROUT SEAL (to nearest foot)

from 48 TOP 52 ft. to 54 BOTTOM 58 ft.
(enter 0 if from surface)

CASING RECORD

casing types insert appropriate code below

ST **CO**
STEEL CONCRETE
PL **OT**
PLASTIC OTHER

MAIN CASING TYPE ST
Nominal diameter top (main) casing (nearest inch) 66
Total depth of main casing (nearest foot) 81

OTHER CASING (if used)
EACH CASING diameter depth (feet) inch from to

screen type or open hole insert appropriate code below

SCREEN RECORD
ST **BR** **HO**
STEEL BRASS OPEN HOLE
PL **OT**
PLASTIC OTHER

C 3

PUMPING TEST

HOURS PUMPED (nearest hour) 06

PUMPING RATE (gal. per min.) 1.7

METHOD USED TO MEASURE PUMPING RATE 190L

WATER LEVEL (distance from land surface)

BEFORE PUMPING 30 ft.

WHEN PUMPING 99 ft.

TYPE OF PUMP USED (for test)

A air **P** piston **T** turbine
C centrifugal **R** rotary **O** other (describe below)
J jet **S** submersible

PUMP INSTALLED

DRILLER INSTALLED PUMP YES NO

IF DRILLER INSTALLS PUMP, THIS SECTION MUST BE COMPLETED FOR ALL WELLS.

TYPE OF PUMP INSTALLED PLACE (A,C,J,P,R,S,T,O) IN BOX 29

CAPACITY: GALLONS PER MINUTE (to nearest gallon) 31 35


PUMP HORSE POWER 37 41

PUMP COLUMN LENGTH (nearest ft.) 43 47

CASING HEIGHT (circle appropriate box and enter casing height)
+ above } LAND SURFACE
- below } 02 (nearest foot)

LOCATION OF WELL ON LOT

SHOW PERMANENT STRUCTURE SUCH AS BUILDING, SEPTIC TANKS, AND /OR LANDMARKS AND INDICATE NOT LESS THAN TWO DISTANCES (MEASUREMENTS TO WELL)

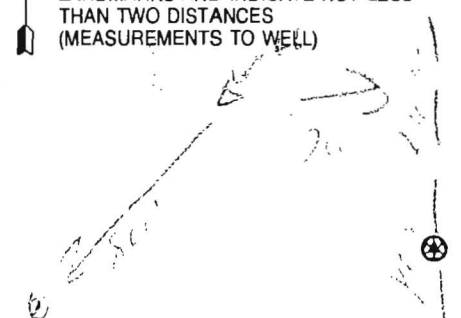

NUMBER OF UNSUCCESSFUL WELLS: 0

WELL HYDROFRACTURED **Y** **N**

CIRCLE APPROPRIATE LETTER

- A** A WELL WAS ABANDONED AND SEALED WHEN THIS WELL WAS COMPLETED
- E** ELECTRIC LOG OBTAINED
- P** TEST WELL CONVERTED TO PRODUCTION WELL

I HEREBY CERTIFY THAT THIS WELL HAS BEEN CONSTRUCTED IN ACCORDANCE WITH COMAR 26.04.04 "WELL CONSTRUCTION" AND IN CONFORMANCE WITH ALL CONDITIONS STATED IN THE ABOVE CAPTIONED PERMIT, AND THAT THE INFORMATION PRESENTED HEREIN IS ACCURATE AND COMPLETE TO THE BEST OF MY KNOWLEDGE.

DRILLERS LIC. NO. M 5D 009

DRILLERS SIGNATURE [Signature]

LIC. NO. D

SITE SUPERVISOR (sign. of driller or journeyman responsible for sitework if different from permittee)

GRAVEL PACK IF WELL DRILLED WAS FLOWING WELL INSERT F IN BOX 68

MDE USE ONLY (NOT TO BE FILLED IN BY DRILLER)
T (E.R.O.S.) W Q

70 72 74 75 76

TELESCOPE CASING LOG INDICATOR OTHER DATA

SEQUENCE NO. (MDE USE ONLY)

STATE OF MARYLAND WELL COMPLETION REPORT

FILL IN THIS FORM COMPLETELY
PLEASE TYPE

THIS REPORT MUST BE SUBMITTED WITHIN
45 DAYS AFTER WELL IS COMPLETED.

THIS NUMBER IS TO BE PUNCHED
IN COLS. 3-6 ON ALL CARDS)

COUNTY
NUMBER

1520847

ST/CO USE ONLY
DATE RECEIVED

DATE WELL COMPLETED

Depth of Well

PERMIT NO.
FROM "PERMIT TO DRILL WELL"

MM DD YY

12 28 05

600

28 29 30 31 32 33 34 35 36 37

OWNER
STREET OR RFD
SUBDIVISION

SECTION TOWN LOT

WELL LOG

Not required for driven wells

STATE THE KIND OF FORMATIONS PENETRATED, THEIR
COLOR, DEPTH, THICKNESS AND IF WATER BEARING

DESCRIPTION (Use
additional sheets if needed)

FEET

check
if water
bearing

DESCRIPTION (Use additional sheets if needed)	FEET		check if water bearing
	FROM	TO	
Brown shale	0	76	
Gray limestone	76	600	✓

GROUTING RECORD

WELL HAS BEEN GROUTED
(Circle Appropriate Box)

yes no

TYPE OF GROUTING MATERIAL (Circle one)

CEMENT BENTONITE CLAY

NO. OF BAGS 27 NO. OF POUNDS 2538

GALLONS OF WATER 162

DEPTH OF GROUT SEAL (to nearest foot)

from 0 ft. to 79 ft. (enter 0 if from surface)

CASING RECORD

casing types insert appropriate code below

STEEL CONCRETE
 PLASTIC OTHER

MAIN CASING TYPE: ST
Nominal diameter top (main) casing (nearest inch): 06
Total depth of main casing (nearest foot): 84

OTHER CASING (if used) diameter inch depth (feet) from to

SCREEN RECORD

screen type or open hole insert appropriate code below

STEEL BRASS OPEN HOLE
 PLASTIC OTHER

DEPTH (nearest ft.)
NO 84 600
SLOT SIZE 1 2 3
DIAMETER OF SCREEN (NEAREST INCH)
56 60

GRAVEL PACK IF WELL DRILLED WAS FLOWING WELL INSERT F IN BOX 68

MDE USE ONLY (NOT TO BE FILLED IN BY DRILLER)
T (E.R.O.S.) W Q

TELESCOPE CASING LOG INDICATOR OTHER DATA

C 3

PUMPING TEST

HOURS PUMPED (nearest hour) 06

PUMPING RATE (gal. per min.) 9.1

METHOD USED TO MEASURE PUMPING RATE 190L

WATER LEVEL (distance from land surface)

BEFORE PUMPING 30 ft.

WHEN PUMPING 117 ft.

TYPE OF PUMP USED (for test)

air piston turbine
 centrifugal rotary other (describe below)
 jet submersible

PUMP INSTALLED

DRILLER INSTALLED PUMP (CIRCLE) (YES or NO) YES NO

IF DRILLER INSTALLS PUMP, THIS SECTION MUST BE COMPLETED FOR ALL WELLS.

TYPE OF PUMP INSTALLED PLACE (A,C,J,P,R,S,T,O) IN BOX 29

CAPACITY: GALLONS PER MINUTE (to nearest gallon) 31 35

PUMP HORSE-POWER 37 41

PUMP COLUMN LENGTH (nearest ft.) 43 47

CASING HEIGHT (circle appropriate box and enter casing height)

above LAND SURFACE
 below 02 (nearest foot)

LOCATION OF WELL ON LOT

SHOW PERMANENT STRUCTURE SUCH AS BUILDING, SEPTIC TANKS, AND/OR LANDMARKS AND INDICATE NOT LESS THAN TWO DISTANCES (MEASUREMENTS TO WELL)




DRILLERS LIC. NO. M SD 009

DRILLERS SIGNATURE (MUST MATCH SIGNATURE ON APPLICATION)

LIC. NO. D

SITE SUPERVISOR (sign. of driller or journeyman responsible for sitework if different from permittee)

OWNER

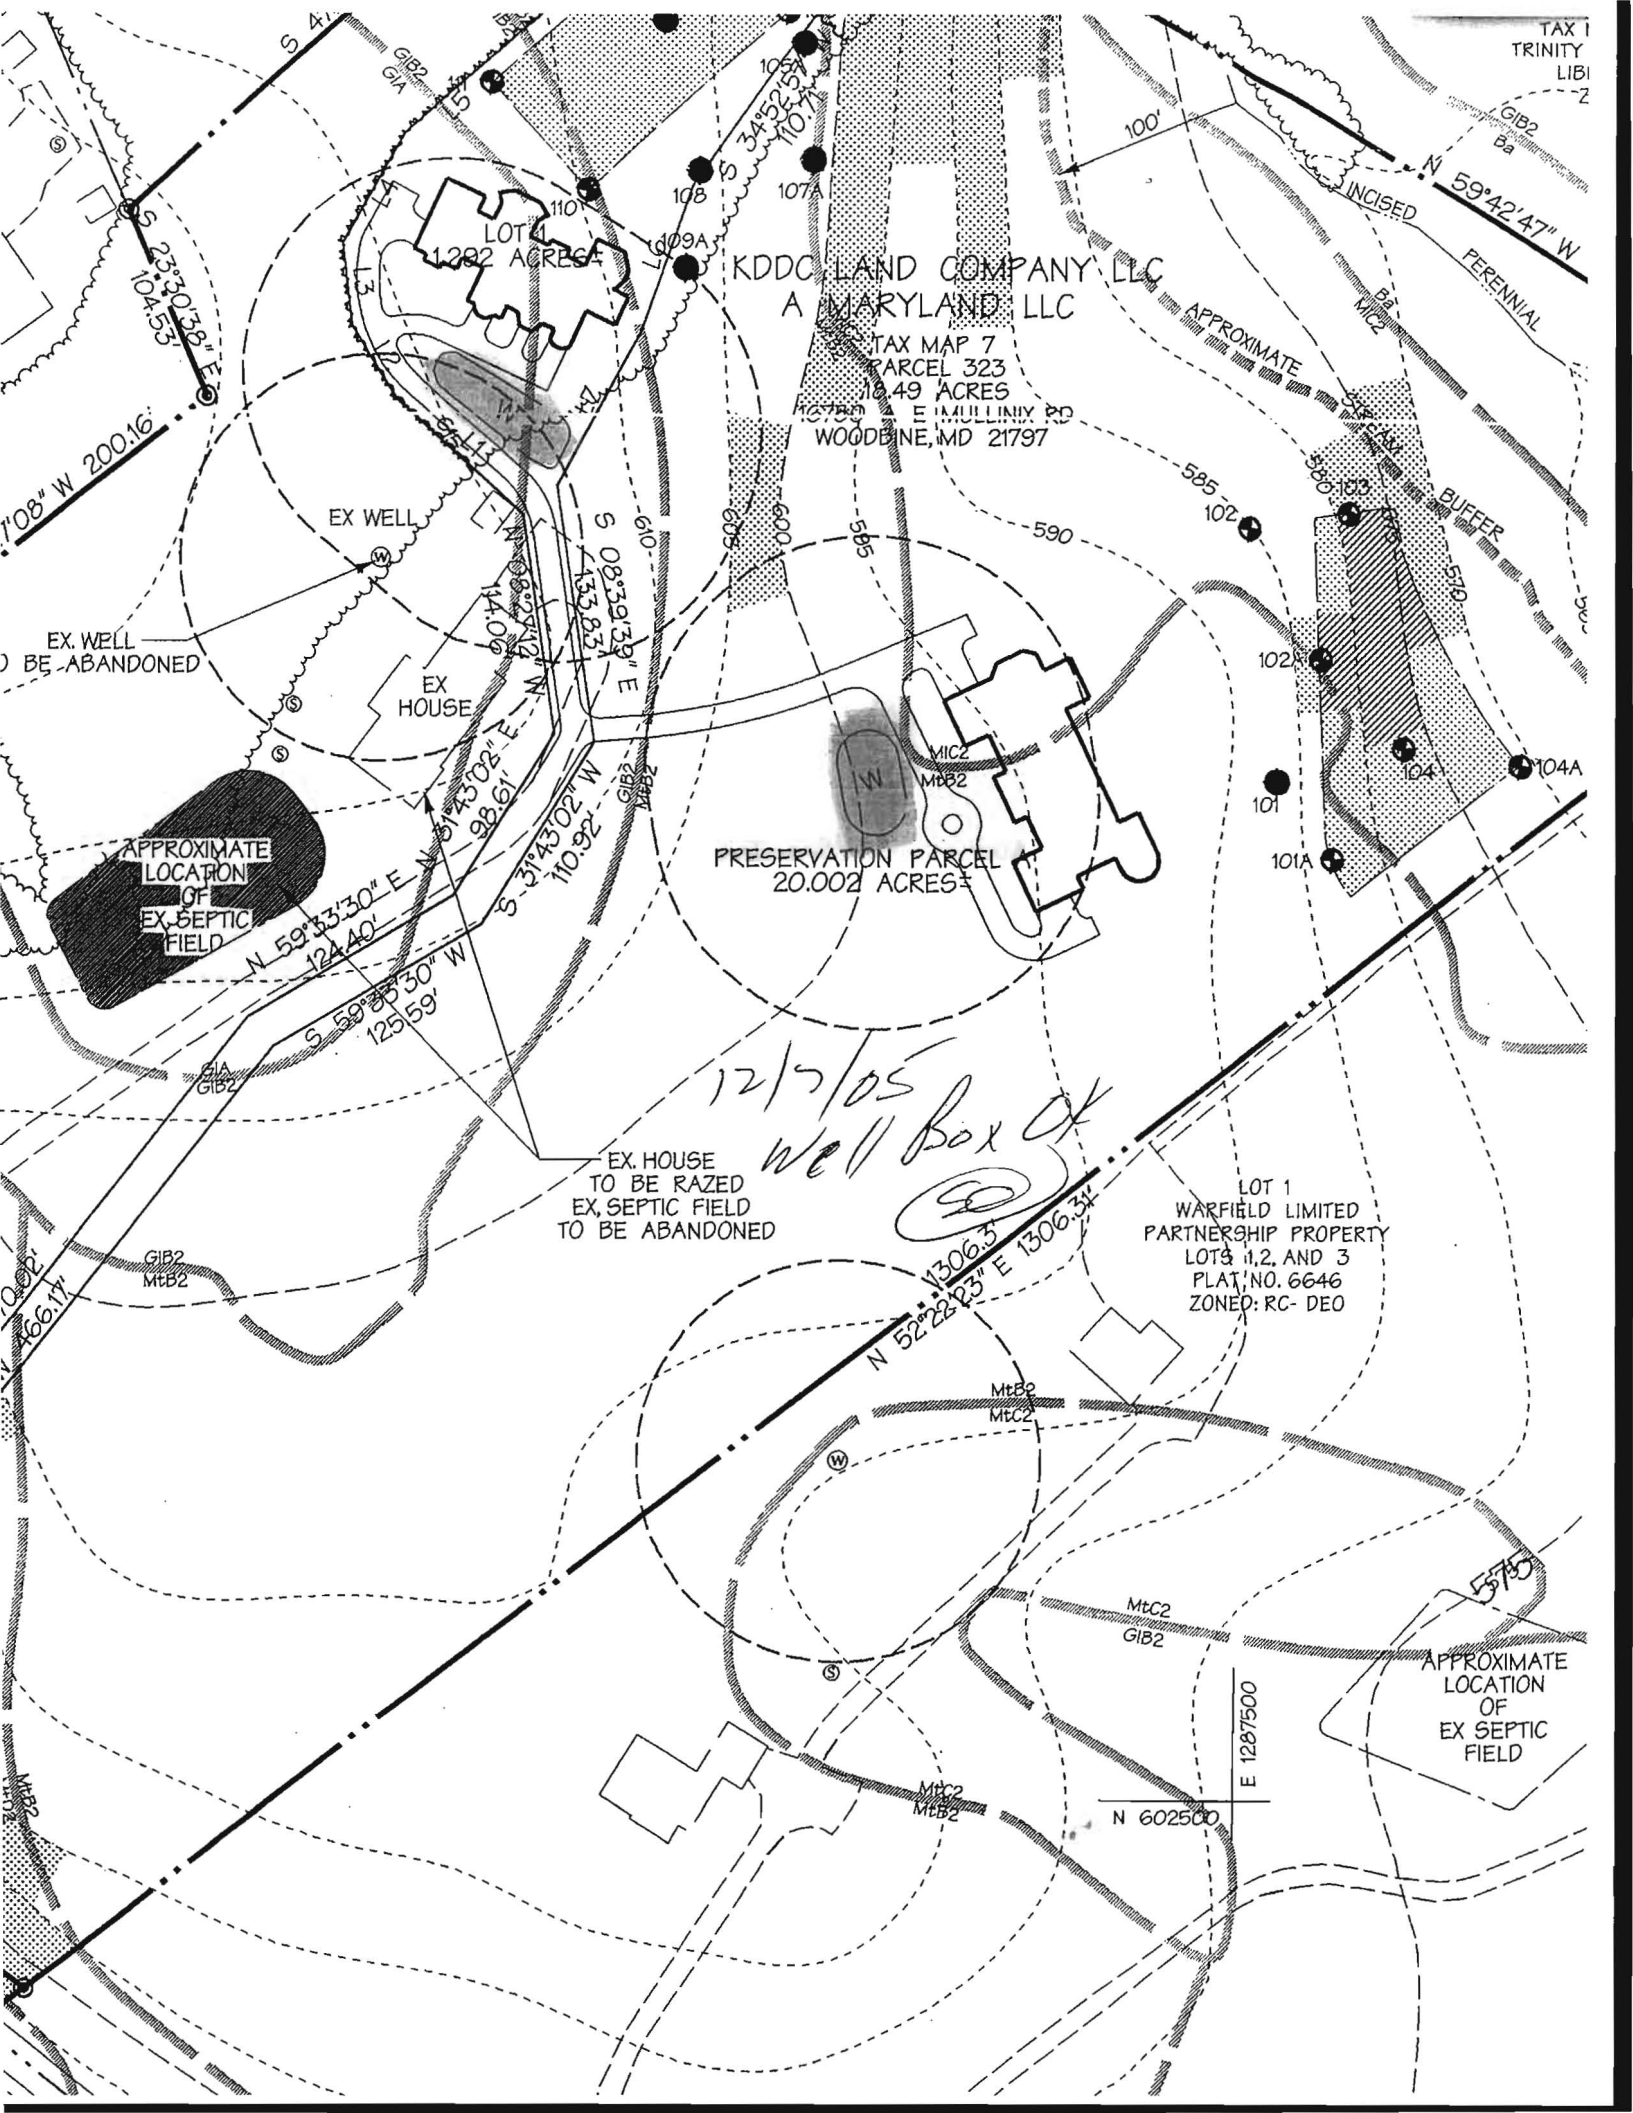

KDDO LAND COMPANY, LLC
A MARYLAND LLC

TAX MAP 7
PARCEL 323
18.49 ACRES
E MULLINY RD
WOODBINE, MD 21797

APPROXIMATE
LOCATION
OF
EX SEPTIC
FIELD

PRESERVATION PARCEL
20.002 ACRES

EX. HOUSE
TO BE RAZED
EX. SEPTIC FIELD
TO BE ABANDONED

12/5/05
Well Box

LOT 1
WARFIELD LIMITED
PARTNERSHIP PROPERTY
LOTS 1, 2, AND 3
PLAT NO. 6646
ZONED: RC-DEO

APPROXIMATE
LOCATION
OF
EX SEPTIC
FIELD



7178 Columbia Gateway Drive, Columbia, MD 21046
(410) 313- 6300 Fax (410) 313-6303
TDD (410) 313-2323 Toll Free 1-866-313-6300
Website: www.hchealth.org

Penny E. Borenstein, M.D., M.P.H., Health Officer

August 3, 2006

Chris Rachuba
946-A Manwich Ct
Sykesville, MD 21784

RE: **Existing Well**
To remain for agricultural purposes
A.E. Mullinix Rd. Property
M. 7 G. 22 P. 428, 323

Dear Chris:

I am writing in regards to the existing well currently on parcel 428, soon to become Preservation Parcel A, pending subdivision of the aforementioned property. This office has no objections to this well being kept on the property for agricultural purposes based upon the provision that this well is and will be constructed, maintained, and operated according to the (COMAR) Code of Maryland Annotated Regulations rules pertinent to this situation.

Respectfully,

GAC
Gabriel A. Creighton
Sanitarian, Well & Septic Program

GAC
cc: Well & Septic Program file

8/2 /06
Well Has No Tag
and No Pump.

BB

04034.A

*July 12th
Submission
date for comments*



946-A Marimich Court
Eldersburg, Maryland 21784
(410) 781-3400
(410) 781-3475 FAX
www.rachuba.com

*Call
CHRIS 443-277-3137*

May 30, 2006

VIA FACSIMILE 410-313-2648

Mr. Michael Davis
Ms. Kacie Noonan
Howard County Health Department
7178 Columbia Gateway Drive
Columbia, Maryland 21046

*6/28/06
Chris is needing
lot 2's well drilled.*

RE: F-06-044, A.E. Mullinix Property

Dear Mike and Kacie:

I would request that the existing well that was to originally service lot 2 of the future subdivision not be abandoned when a new well is drilled so that I may use it for future agricultural purposes. I plan on building a barn for some horses in close proximity to the existing well. The well will remain on property that will be 20 acres and be put into the Howard County Agricultural Land preservation Program.

Thank you for your consideration. If you have any questions please feel free to contact me.

Sincerely,

KDDC Land Company, LLC
Christopher L. Rachuba
Managing Member

Co:
Mr. Michael Pieranunzi, DMW



2001 and 2002 Maryland Award of Excellence for Outstanding Custom Home



946-A Marimich Court
Eldersburg, Maryland 21784
(410) 781-3400
(410) 781-3475 FAX
www.rachuba.com

September 28, 2006

Ms. Sara Fegel
Howard County Health Department
7178 Columbia Gateway Drive
Columbia, Maryland 21046

RE: F-06-044 16780 A.E. Mullinix Road

Dear Ms. Fegel:

I am requesting that the existing structures on the preservation parcel for the above referenced subdivision be allowed to remain as auxiliary structures. The structure is currently being used as my home and is storing all of my belongings as well as the equipment needed to maintain the property.

My request would extend so that the Use and Occupancy Certificate not be issued on the future home on the preservation parcel until the existing well and septic are abandoned on the existing structure.

Requiring me to move my belongings and myself would be a large financial burden.

Thank you in advance for your consideration.

Sincerely,

Christopher L. Rachuba



MHBR #271



CHARTER

2001 and 2002 Maryland Award of Excellence for Outstanding Custom Home



946-A Maimich Court
Eldersburg, Maryland 21784
(410) 781-3400
(410) 781-3475 FAX
www.rachuba.com

September 28, 2006

Ms. Cassandra Heidler
Howard County Department of Planning and Zoning
3430 Courthouse Drive
Ellicott City, Maryland 21043

RE: F-06-044 A.E. Mullinix Road Property

Dear Cassandra:

Per comment 15 of the DLD comments, I have worked with the future owner of lot 2, Robin and Patrick Arnone. They have agreed that as long as the trees are not planted on future lot 2 it is in my discretion as to where they are placed. The only exception is the placement of 2 trees on the perimeter between future lot 2 and existing Parcel 249. Cindy informed me via Derrick Jones on September 27, 2006 that a couple of trees were needed in that location.

If you have any questions please feel free to contact me.

Sincerely,

KDDC Land Company, LLC

Christopher L. Rachuba
Managing Member



MHBIR #271



CHARTER

2001 and 2002 Maryland Award of Excellence for Outstanding Custom Homes

Penny E. Borenstein, M.D., M.P.H., Health Officer

TO ALL INTERESTED PARTIES

When submitting a well permit application for a proposed well for new construction, please indicate one of the following:

- The well site has been staked by Dart, McCune Walker, Inc.
(professional land surveyor or company employing professional land surveyors)
on 11-2-05 (date) and does not require a site inspection.
- The well driller, builder or property owner will call the Health Department to schedule a time to meet in the field to verify the proposed well site location.


This sheet, along with two copies of an acceptable well site plan, must be attached to the green well permit application.

Revised 6/10/03

ZONED: RC-DE0

624.

605

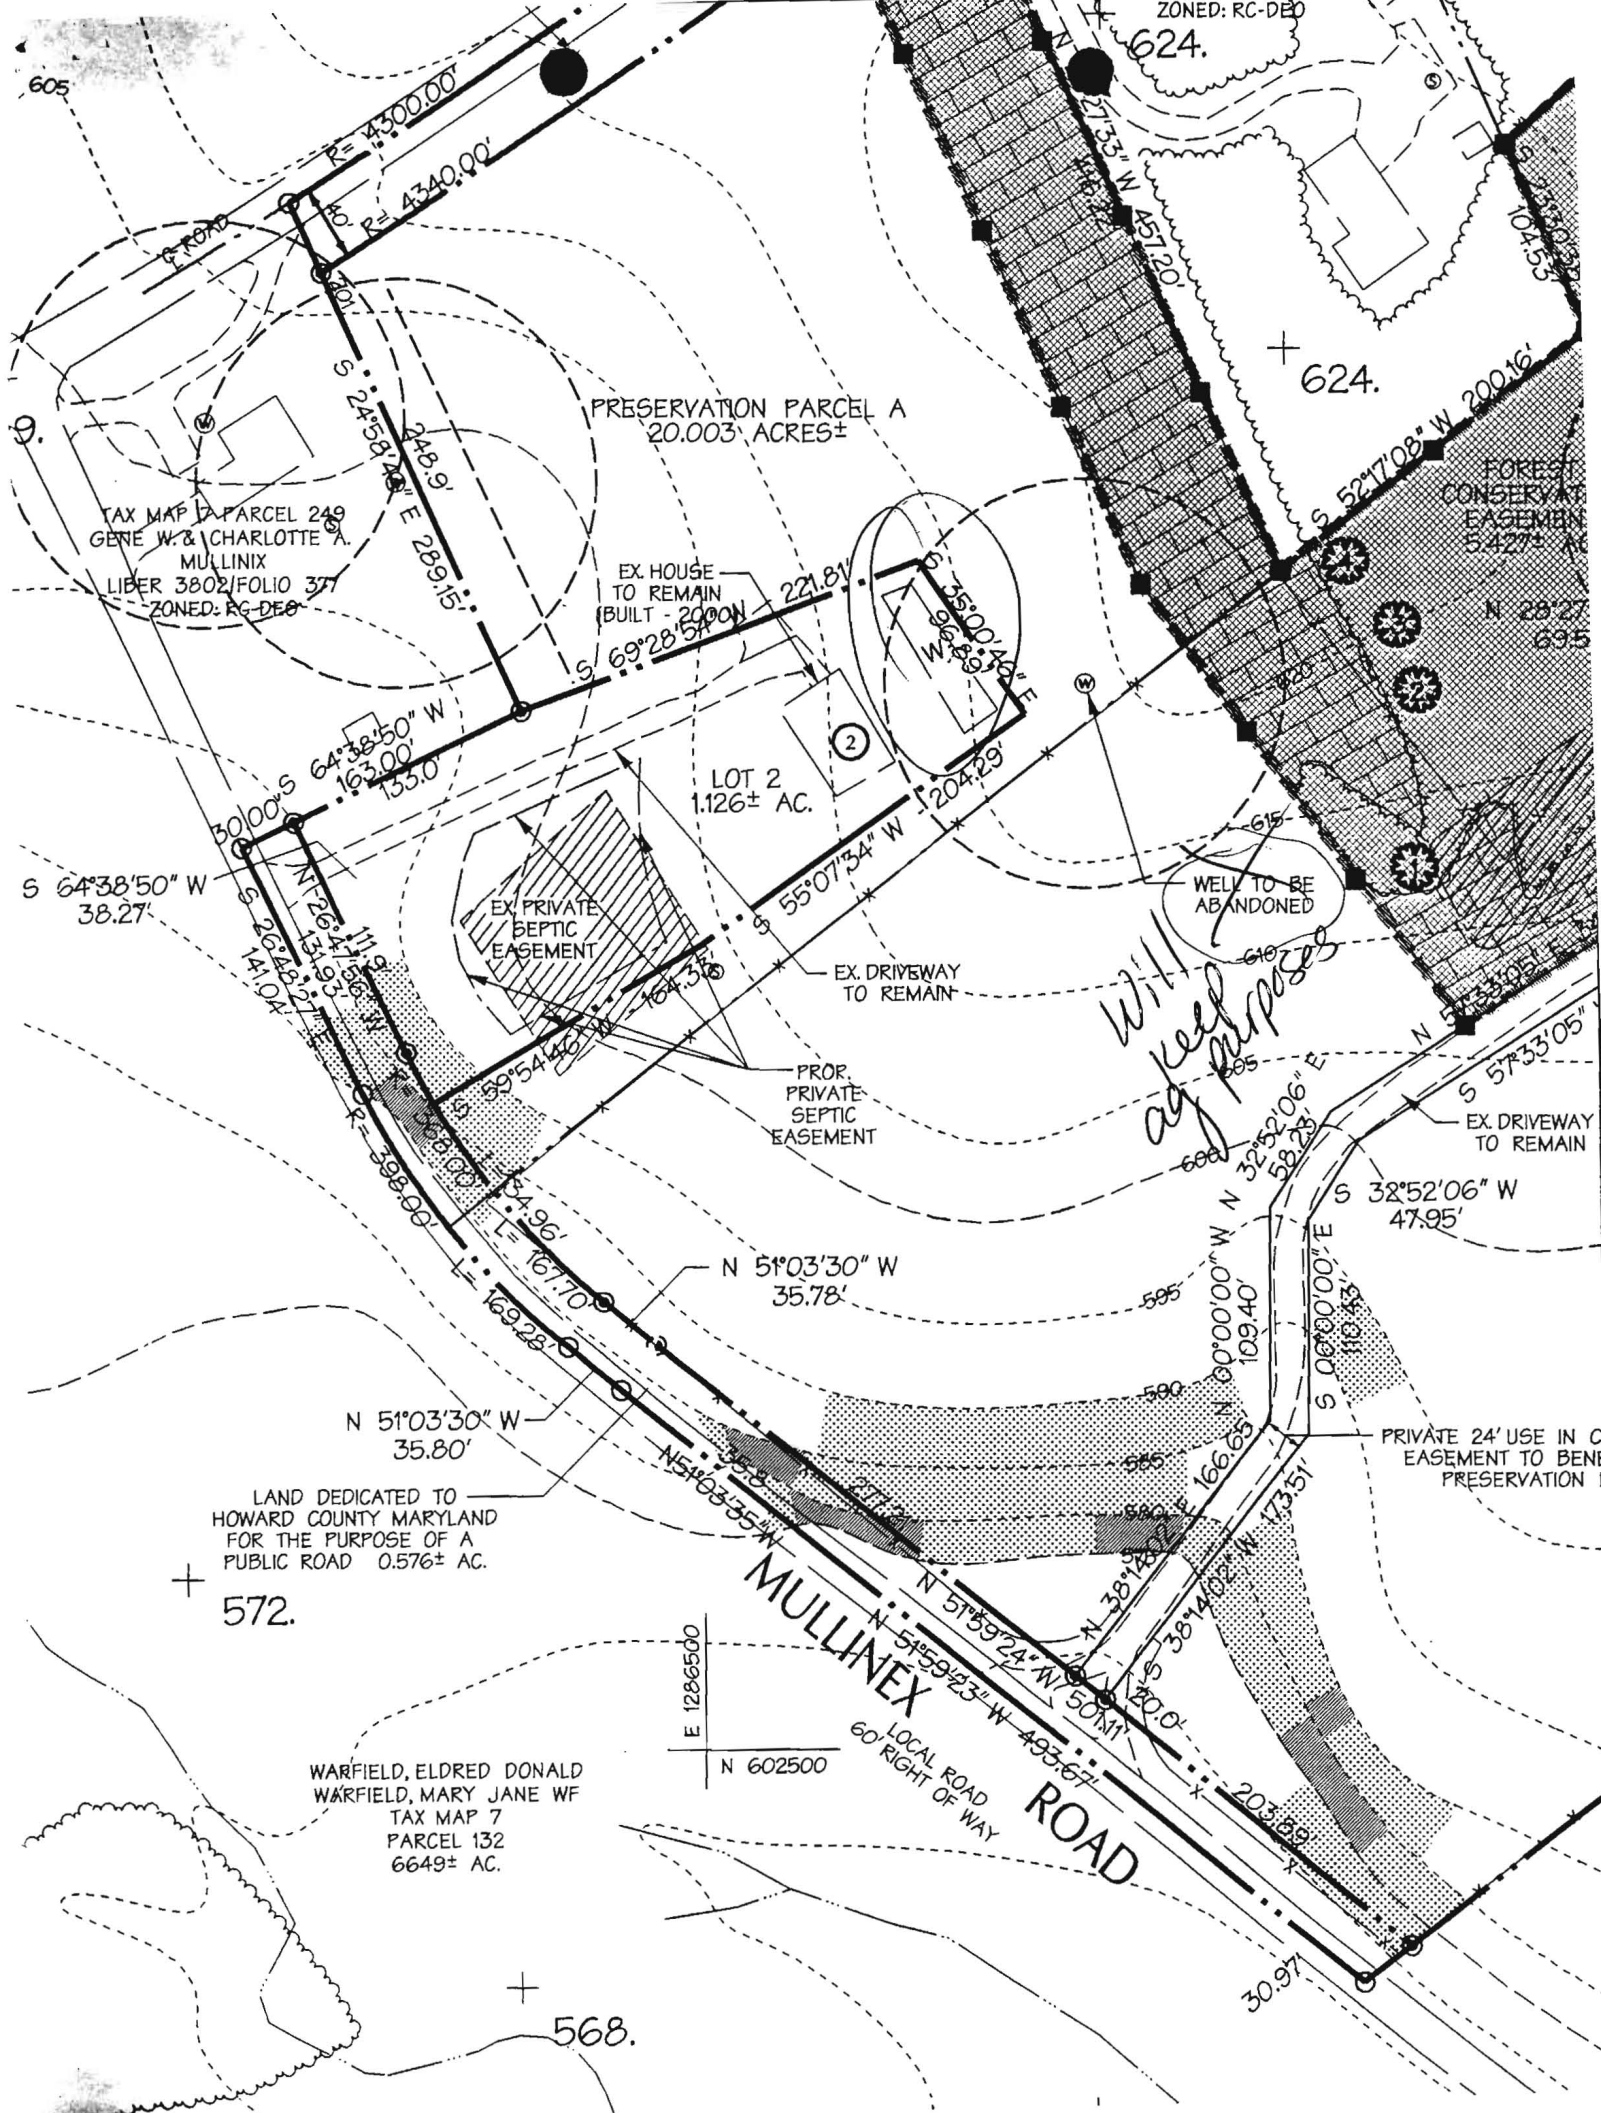

PRESERVATION PARCEL A
20.003 ACRES±

TAX MAP 7 PARCEL 249
GENE W. & CHARLOTTE A.
MULLINEX
LIBER 3802/FOLIO 37
ZONED: RC-DE0

EX HOUSE
TO REMAIN
(BUILT - 2000N)

LOT 2
1.126± AC.

WELL TO BE
ABANDONED

EX PRIVATE
SEPTIC
EASEMENT

EX DRIVEWAY
TO REMAIN

PROR.
PRIVATE
SEPTIC
EASEMENT

will keep as purpose

FOREST
CONSERVATION
EASEMENT
5.427± AC

N 28°27'
69.5

S 64°38'50" W
38.27'

S 64°38'50" W
162.00'
133.0

S 69°28'54" W
221.81'

S 35°00'40" E
163.89'

S 55°07'34" W
204.29'

N 57°53'05" W
104.53'

S 57°53'05" W
47.95'

S 32°52'06" W
47.95'

N 51°03'30" W
35.78'

N 51°03'30" W
35.80'

LAND DEDICATED TO
HOWARD COUNTY MARYLAND
FOR THE PURPOSE OF A
PUBLIC ROAD 0.576± AC.

572.

WARFIELD, ELDRED DONALD
WARFIELD, MARY JANE WF
TAX MAP 7
PARCEL 132
6649± AC.

E 1286500

N 602500

MULLINEX

ROAD

LOCAL ROAD
60' RIGHT OF WAY

PRIVATE 24' USE IN C
EASEMENT TO BENEFIT
PRESERVATION

568.