

PUB. SEWER STATUS VERIFIED BY \_\_\_\_\_

ISSUE DATE: \_\_\_\_\_

P 536001

APPROVAL DATE: 11/8/2011

A REPAIR

# PERMIT

## Septic Repair

**ON-SITE SEWAGE DISPOSAL SYSTEM  
HOWARD COUNTY HEALTH DEPARTMENT  
BUREAU OF ENVIRONMENTAL HEALTH**

J & A Construction Services IS PERMITTED TO INSTALL  ALTER

ADDRESS: 7991 Bennett Branch Road MT Airy, MD 21771 PHONE NUMBER: 301-806-8480

SUBDIVISION: \_\_\_\_\_ LOT NUMBER: \_\_\_\_\_

ADDRESS: 13734 Briaridge Court PROPERTY OWNER: Jack Burke

SEPTIC TANK CAPACITY (GALLONS): N/A

PUMP CHAMBER CAPACITY (GALLONS): \_\_\_\_\_

NUMBER OF BEDROOMS: \_\_\_\_\_

SQUARE FEET OF HOUSE: \_\_\_\_\_

LINEAR FEET OF TRENCH REQUIRED: \_\_\_\_\_


TRENCHES:	
LOCATION:	
PURPOSE:	

PLANS APPROVED: \_\_\_\_\_ DATE: \_\_\_\_\_

- NOTE: PERMIT VOID AFTER 2 YEARS
- NOTE: CONTRACTOR RESPONSIBLE FOR SCHEDULING A PRE-CONSTRUCTION INSPECTION FOR ALL INSTALLATIONS
- NOTE: WATERTIGHT SEPTIC TANKS REQUIRED
- NOTE: ALL PARTS OF SEPTIC SYSTEM SHALL BE 100 FEET FROM ANY WATER WELL
- NOTE: MANHOLE RISERS REQUIRED ON ALL SEPTIC TANKS AND PUMP CHAMBERS

**NEITHER THE HOWARD COUNTY COUNCIL OR THE HEALTH DEPARTMENT IS RESPONSIBLE FOR THE SUCCESSFUL OPERATION OF ANY SYSTEM PERMITTEE RESPONSIBLE FOR OBTAINING FINAL APPROVAL ON THIS PERMIT CALL 410-313-1771 FOR INSPECTION OF SEPTIC SYSTEM**

NOT TO SCALE

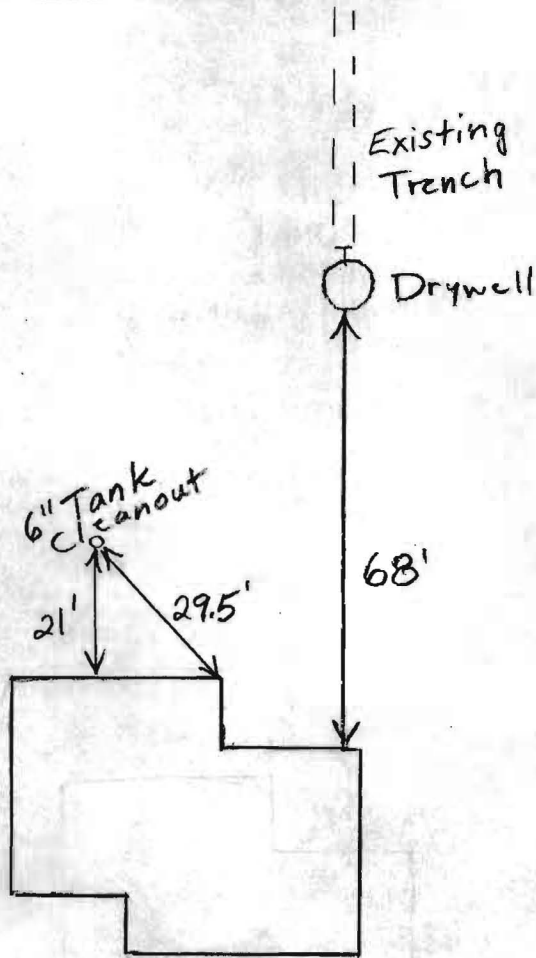

ROAD NAME  
Briaridge Court

**TRENCH/DRAINFIELD DATA**

WIDTH \_\_\_\_\_ INLET \_\_\_\_\_ BOTTOM \_\_\_\_\_

NUMBER OF TRENCHES \_\_\_\_\_

TOTAL LENGTH \_\_\_\_\_

ABSORPTION AREA \_\_\_\_\_

DISTRIBUTION BOX LEVEL \_\_\_\_\_

DISTRIBUTION BOX BAFFLE \_\_\_\_\_

DISTRIBUTION BOX PORT \_\_\_\_\_

**SEPTIC TANK DATA**

SEPTIC TANK 1 LEVEL \_\_\_\_\_

MANUFACTURER \_\_\_\_\_

CAPACITY \_\_\_\_\_ GAL

SEAM LOC \_\_\_\_\_

TANK LID DEPTH \_\_\_\_\_

BAFFLES \_\_\_\_\_

BAFFLE FILTER \_\_\_\_\_

MANHOLE LOC \_\_\_\_\_

6" PORT LOC \_\_\_\_\_

WATERTIGHT TEST \_\_\_\_\_

SLOTTED \_\_\_\_\_

DATE ON LID \_\_\_\_\_

PUMP/SEPTIC TANK LEVEL \_\_\_\_\_

MANUFACTURER \_\_\_\_\_

CAPACITY \_\_\_\_\_ GAL

SEAM LOC \_\_\_\_\_

TANK LID DEPTH \_\_\_\_\_

BAFFLES \_\_\_\_\_

BAFFLE FILTER \_\_\_\_\_

MANHOLE LOC \_\_\_\_\_

6" PORT LOC \_\_\_\_\_

WATERTIGHT TEST \_\_\_\_\_

SLOTTED \_\_\_\_\_

DATE ON LID \_\_\_\_\_

PRE-CONSTRUCTION:

10/21/2011 Drywell cover collapsed. Drywell full. Trench of drywell is dry. Pump out and clean out drywell. Fill drywell with gravel and add a 6" piece of perforated pipe extending from bottom of drywell to grade. Check that existing trench is O.K. If O.K. connect trench to drywell. Also, cover drywell with fabric. (BB)

INSTALLATION:

11/8/2011 Drywell pumped out and filled with gravel. Everything covered except for part of drywell when I arrived. Installer said that existing trench looked O.K. alright to finish backfilling. (BB)

FINAL INSPECTOR

B. Baker

DATE OF APPROVAL

11/8/2011

PUB. SEWER STATUS VERIFIED BY \_\_\_\_\_

ISSUE DATE: \_\_\_\_\_

# PERMIT

P 536001 \_\_\_\_\_

APPROVAL DATE: \_\_\_\_\_

A REPAIR \_\_\_\_\_

## Septic Repair ON-SITE SEWAGE DISPOSAL SYSTEM HOWARD COUNTY HEALTH DEPARTMENT BUREAU OF ENVIRONMENTAL HEALTH

J & A Construction Services IS PERMITTED TO INSTALL  ALTER

ADDRESS: 7991 Bennett Branch Road MT Airy, MD 21771 PHONE NUMBER: 301-806-8480

SUBDIVISION: \_\_\_\_\_ LOT NUMBER: \_\_\_\_\_

ADDRESS: 13734 Briaridge Court PROPERTY OWNER: Jack Burke

SEPTIC TANK CAPACITY (GALLONS): N/A

PUMP CHAMBER CAPACITY (GALLONS): \_\_\_\_\_

NUMBER OF BEDROOMS: 4

SQUARE FEET OF HOUSE: \_\_\_\_\_

LINEAR FEET OF TRENCH REQUIRED: \_\_\_\_\_

TRENCHES:	
LOCATION:	
PURPOSE:	

PLANS APPROVED: \_\_\_\_\_ DATE: \_\_\_\_\_

- NOTE: PERMIT VOID AFTER 2 YEARS
- NOTE: CONTRACTOR RESPONSIBLE FOR SCHEDULING A PRE-CONSTRUCTION INSPECTION FOR ALL INSTALLATIONS
- NOTE: WATERTIGHT SEPTIC TANKS REQUIRED
- NOTE: ALL PARTS OF SEPTIC SYSTEM SHALL BE 100 FEET FROM ANY WATER WELL
- NOTE: MANHOLE RISERS REQUIRED ON ALL SEPTIC TANKS AND PUMP CHAMBERS

**NEITHER THE HOWARD COUNTY COUNCIL OR THE HEALTH DEPARTMENT IS RESPONSIBLE FOR THE SUCCESSFUL OPERATION OF ANY SYSTEM PERMITTEE RESPONSIBLE FOR OBTAINING FINAL APPROVAL ON THIS PERMIT CALL 410-313-1771 FOR INSPECTION OF SEPTIC SYSTEM**

We are an Equal Opportunity Employer

# SAVAGE STONE, LLC

SAVAGE, MARYLAND

Mailing Address: P.O. Box 850, Laurel, Maryland 20725

DISPATCH / SALES

301-953-8973

410-792-3753

CUSTOMER'S COPY

BILLING INQUIRIES

301-953-7650

410-792-7234

TICKET # 4562

STATION SS

DATE 11/08/11 TIME 07:37:43

CUSTOMER CASH  
CASH

JOB PICCON : PICK UP CONTRACTOR  
P.O. # PROJECT #:

TRUCK JA1 LICENSE @ AXLES  
DRIVER: J A CONSTRUCTION

GROSS	SCALE A	67920 lb
TARE IN	(STORED)	28600 lb
NET		39320 lb
NET		19.66 t

	Loads	Tons
DAILY	1	19.66
TOTAL	14	202.30
TIME IN 07:37:43		TIME OUT 07:37:43

MAT'L 0029 : WASHED #2 STONE  
HAUL RATE \$0.00/ton  
HAUL ZONE 0000

MATERIAL CHARGE (@ \$14.95/ton )	\$293.92
HAUL CHARGE	\$0.00
Fuel Surcharge	\$0.00
6.00% SALES TAX	\$17.64
TOTAL CHARGE	\$311.56

WEIGHMASTER \_\_\_\_\_  
Gail Harrison

RECEIVED BY *[Signature]*

SAFETY FIRST! HAVE A GREAT DAY! PLEASE CHECK YOUR TICKET!

We are an Equal Opportunity Employer

# SAVAGE STONE, LLC

SAVAGE, MARYLAND

Mailing Address: P.O. Box 850, Laurel, Maryland 20725

DISPATCH / SALES  
301-953-8973  
410-792-3753

CUSTOMER'S COPY

BILLING INQUIRIES  
301-953-7650  
410-792-7234

TICKET #00524912

STATION SS

DATE 11/08/11 TIME 12:19:26

CUSTOMER CASH  
CASH

JOB PICCON : PICK UP CONTRACTOR  
P.O. # PROJECT #:

TRUCK JA1 LICENSE 0 AXLES  
DRIVER: J A CONSTRUCTION

				Loads	Tons
GROSS	SCALE A	68140 lb	DAILY	2	39.43
TARE	IN (STORED)	28600 lb	TOTAL	15	222.07
NET		39540 lb	TIME IN 12:19:26		TIME OUT 12:19:26
NET		19.77 t			

MAT'L 0029 : WASHED #2 STONE  
HAUL RATE \$0.00/ton  
HAUL ZONE 0000

MATERIAL CHARGE (@ \$14.95/ton)	\$295.56
HAUL CHARGE	\$0.00
Fuel Surcharge	\$0.00
6.00% SALES TAX	\$17.73
TOTAL CHARGE	\$313.29

WEIGHMASTER \_\_\_\_\_  
Stacey Hawke

RECEIVED BY  \_\_\_\_\_

SAFETY FIRST! HAVE A GREAT DAY! PLEASE CHECK YOUR TICKET!